THIS MAP WAS PREPARED FOR ASSESSMENT PURPOSE ONLY.

SEC.24 T.28S. R.7W. W.M.
DOUGLAS COUNTY
1" = 400'

REVISED ON 3-31-22
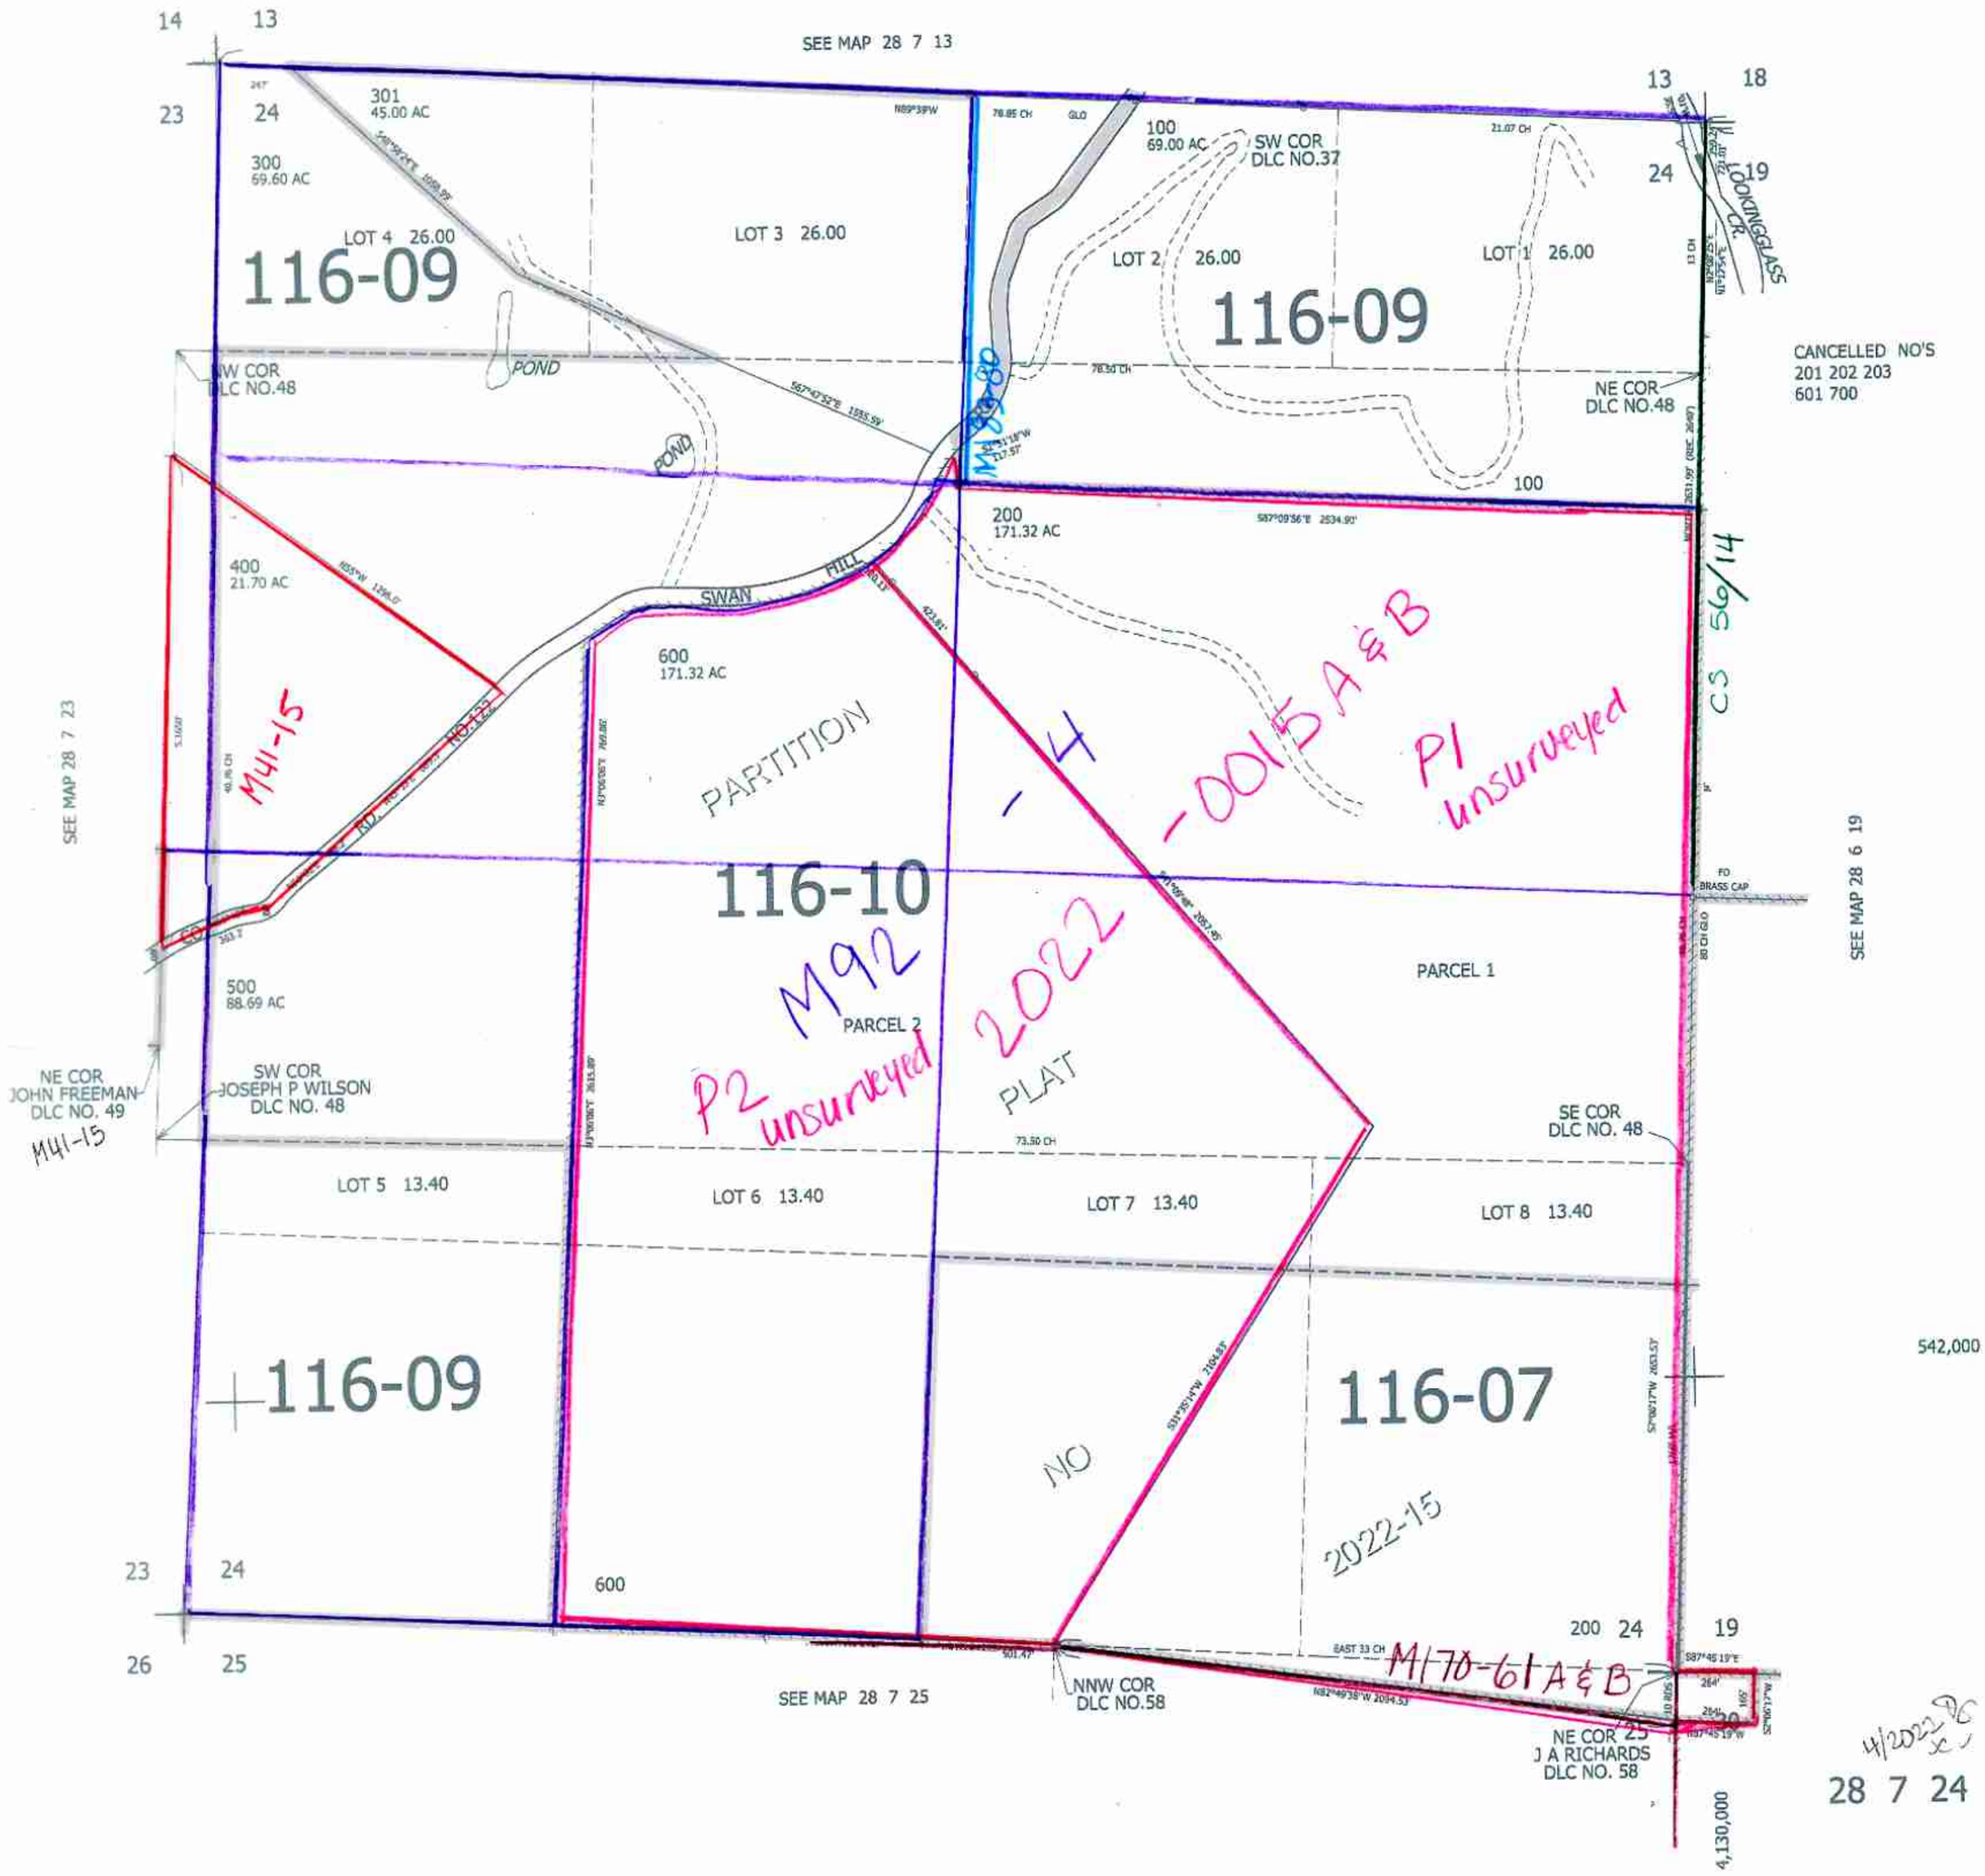
28 7 24