THIS MAP WAS PREPARED FOR ASSESSMENT PURPOSE ONLY.

SEC.25 T.28S. R.7W. W.M.
DOUGLAS COUNTY

1" = 400'

REVISED ON 4-13-16

28 7 25

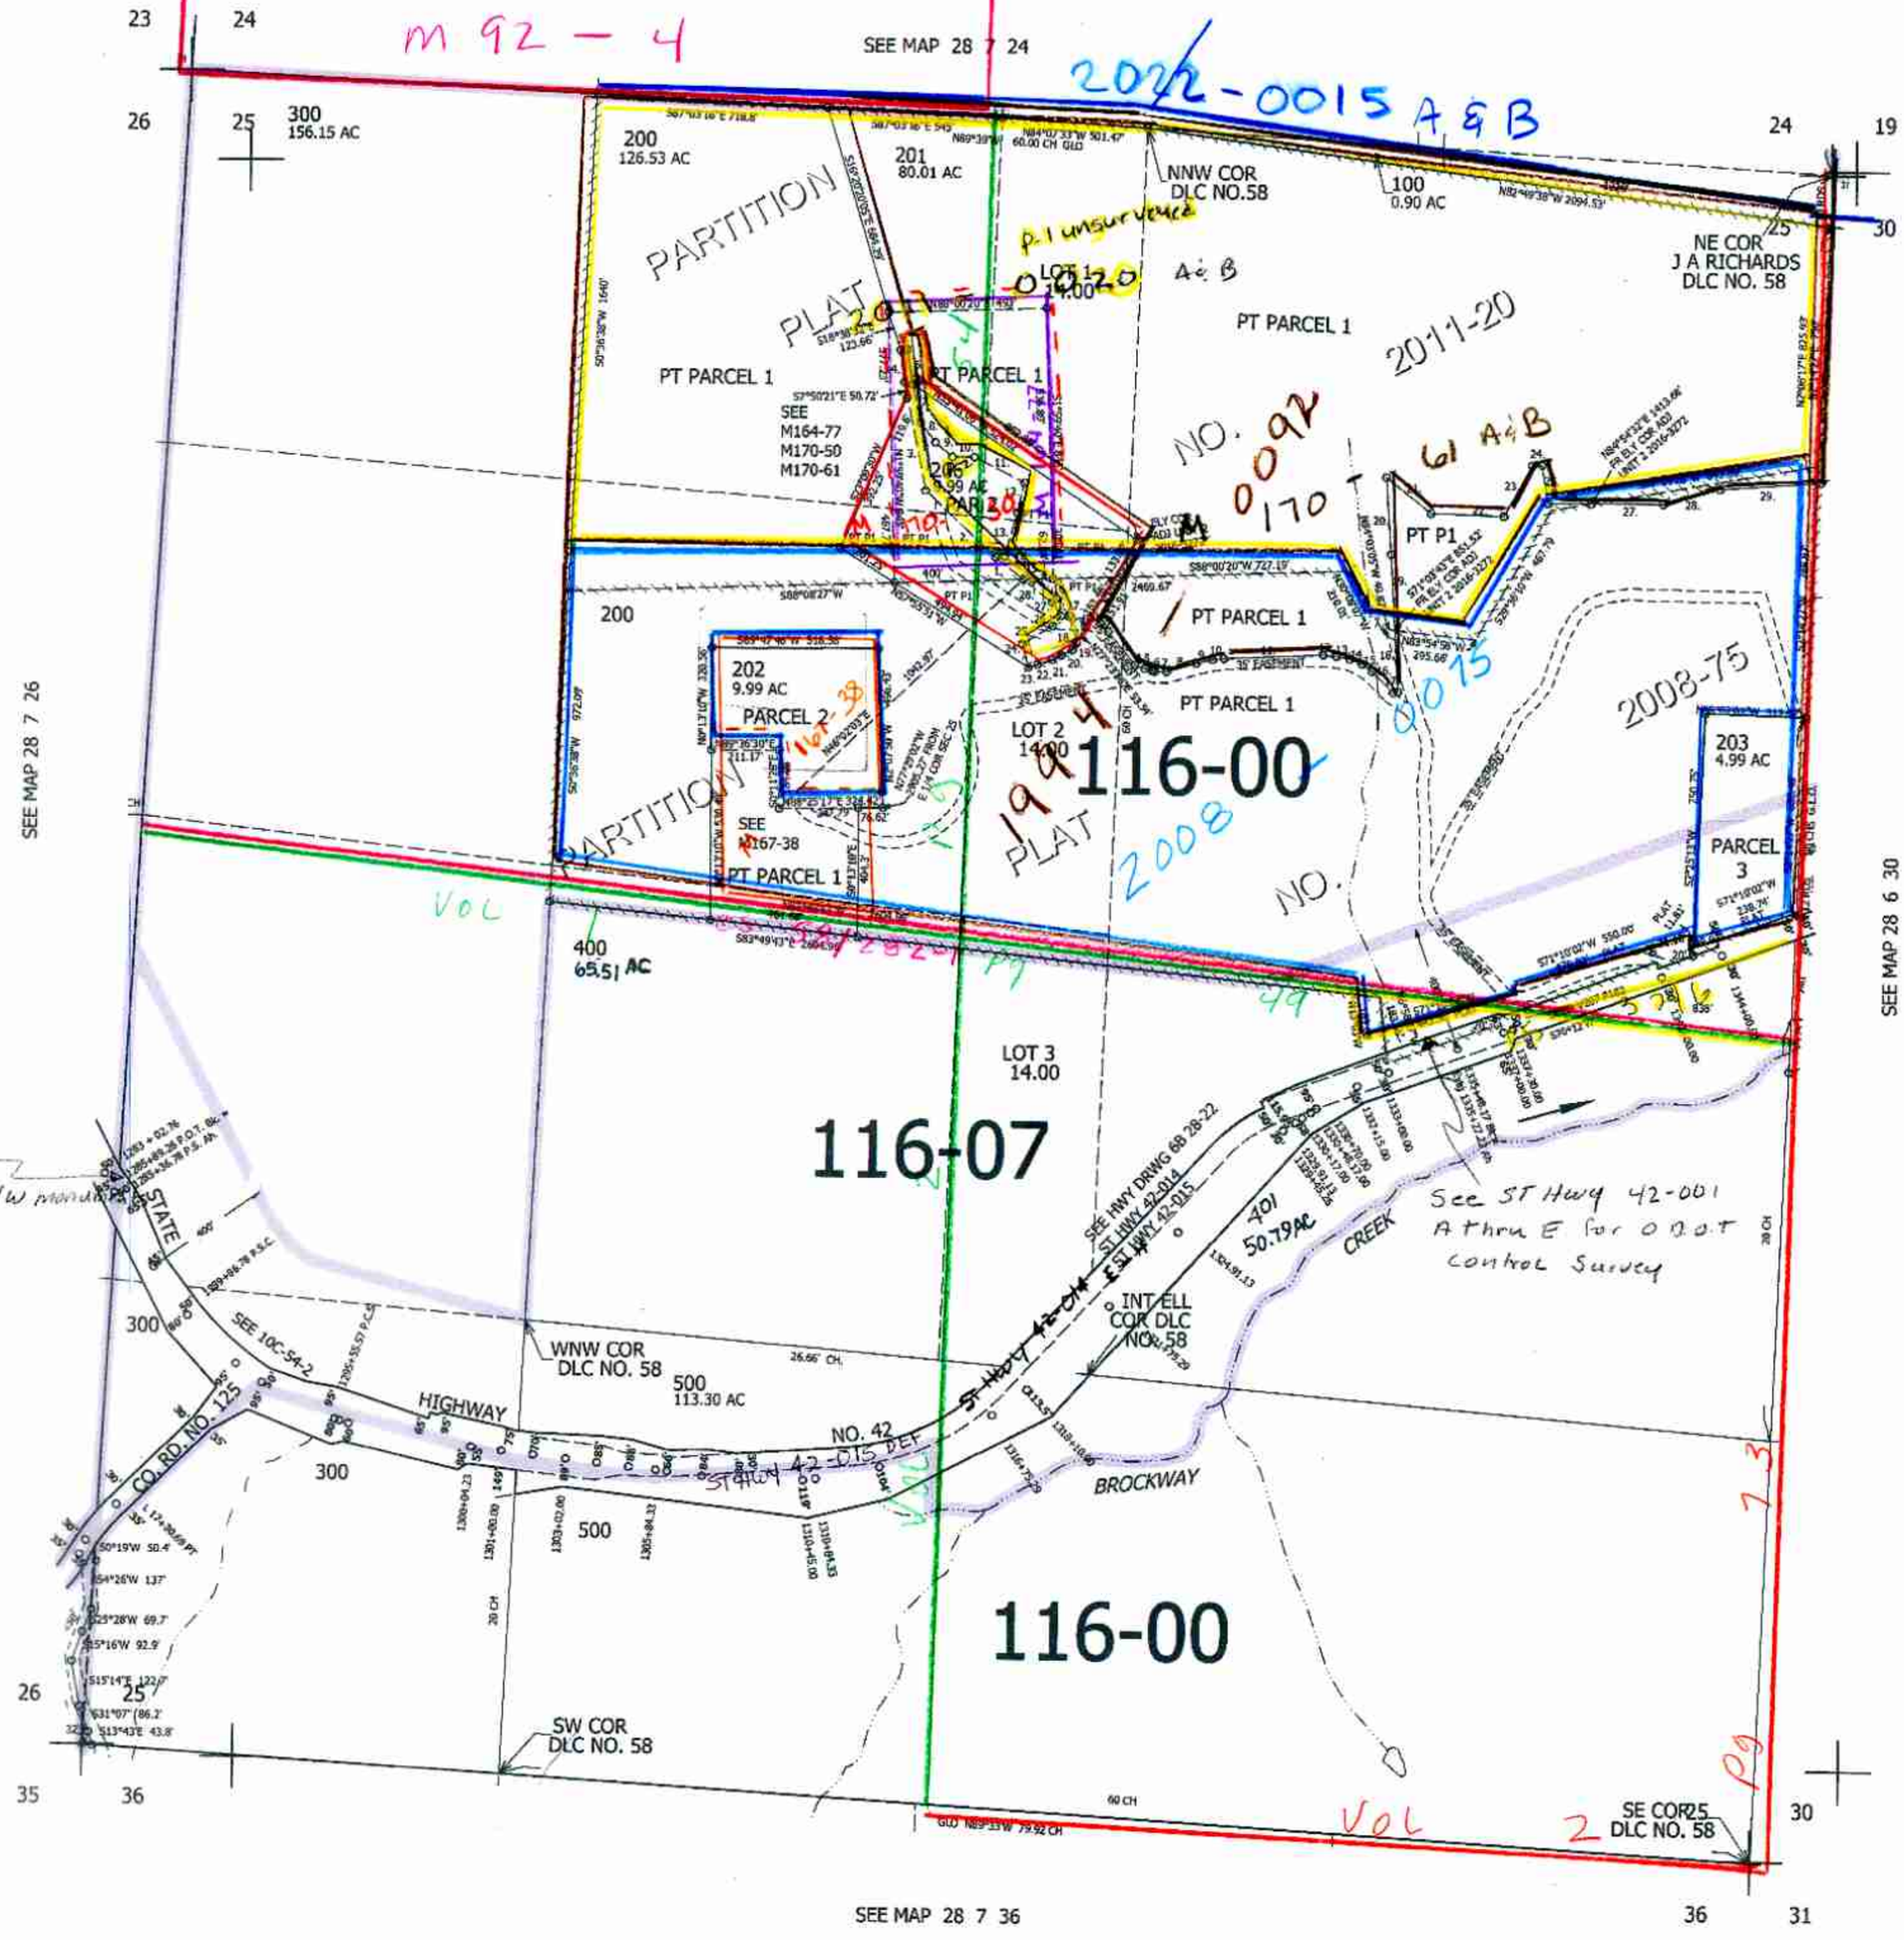

CANCELLED NO'S
204 205 207
208 THRU 213

PARCEL 206
1. N51°41'43"W 110.44'
2. N46°56'46"W 302.6'
3. N11°22'25"W 345.52'
4. N7°50'21"W 106.56'
5. N85°40'00"E 20'
6. S10°00'00"E 110'
7. S11°50'18"E 121.44'
8. S37°16'33"E 77.31'
9. S49°46'58"E 69.63'
10. EAST 69.55'
11. S63°26'06"E 174.38'
12. S12°06'09"W 97.39'
13. S15°31'09"W 141.54'
14. S51°41'43"E 113.87'
15. N88°00'20"E 30.92'
16. S51°41'43"E 94.62'
17. S34°31'39"E 71.34'
18. S16°43'35"E 83.34'
19. S27°52'08"W 27.64'
20. S63°34'00"W 39.4'
21. S63°18'31"W 31.64'
22. S70°48'20"W 47.4'
23. S73°00'00"W 30'
24. N15°00'00"W 75'
25. N58°28'07"E 109.8'
26. N38°52'25"E 41.65'
27. N34°31'39"W 52.2'
28. N51°41'43"W 115.19'

PARCEL 200
1. S64°26'06"E 37.38'
2. S42°19'45"E 34.04'
3. S38°55'03"E 134.24'
4. S72°15'05"E 32.5'
5. S73°44'38"E 24.04'
6. S74°55'40"E 7.58'
7. S89°14'38"E 37.05'
8. N73°45'20"E 95.12'
9. N77°13'20"E 53.63'
10. N83°48'58"E 35.71'
11. N87°24'47"E 308.66'
12. S84°30'47"E 42'
13. S78°31'51"E 41.85'
14. S69°02'30"E 42.18'
15. S54°52'37"E 37.76'
16. S44°55'22"E 94.07'
17. N76°19'57"E 14.96'
18. N3°30'31"W 191.93'
19. N3°30'31"W 239.47'
20. N4°07'36"W 241.72'
21. S51°32'11"E 179.77'
22. S88°01'56"E 227.57'
23. N38°21'21"E 181.09'
24. N86°55'50"E 30.4'
25. S9°24'02"E 121.42'
26. N89°56'45"E 130.32'
27. N89°56'45"E 228.79'
28. N74°24'38"E 182.26'
29. N86°06'59"E 303.73'
FR WHICH A 3/8" I.R. BEARS
N86°06'59"E 8.44'

CM 1/04/03
JC ✓

28 7 25