THIS MAP WAS PREPARED FOR ASSESSMENT PURPOSE ONLY.

SEC.31 T.28S. R.7W. W.M.
DOUGLAS COUNTY

1" = 400'

REVISED ON 6-2-10

28 7 31 & INDEX

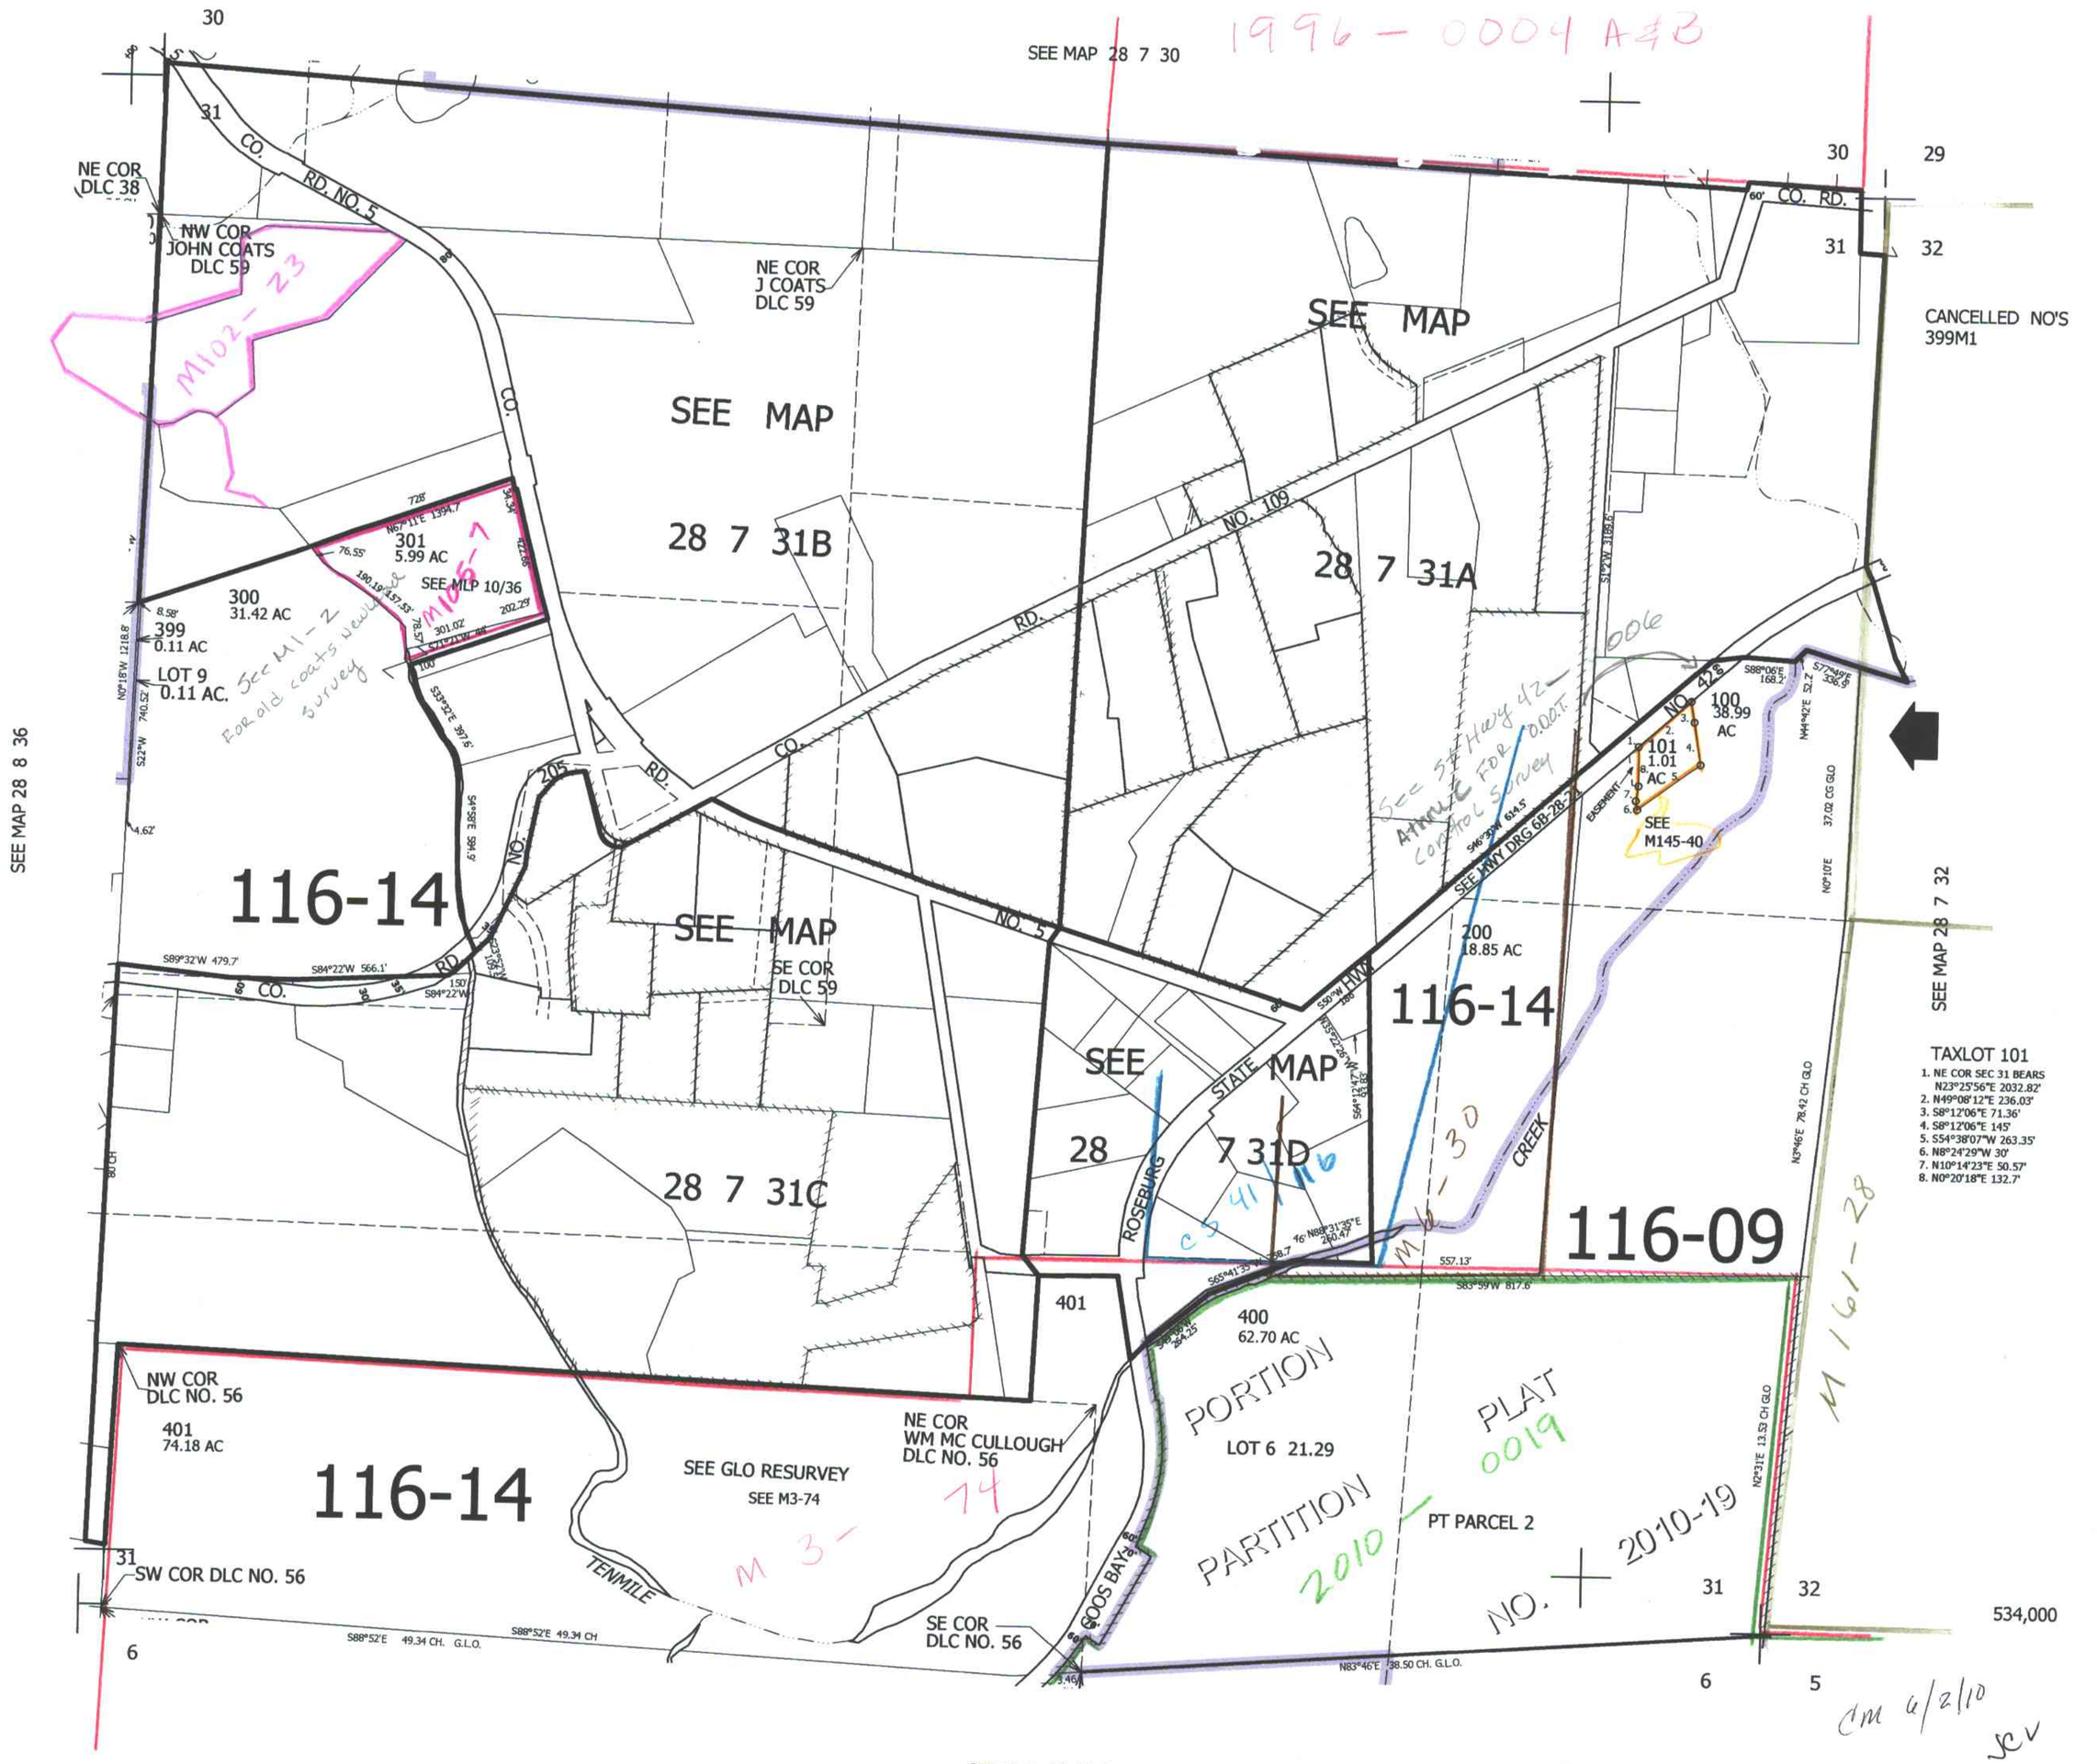

28 7 31 & INDEX