THIS MAP WAS PREPARED FOR ASSESSMENT PURPOSE ONLY.

SEC.34 T.28S. R.7W. W.M.
DOUGLAS COUNTY
1" = 400'

REVISED ON 4-30-19

28 7 34
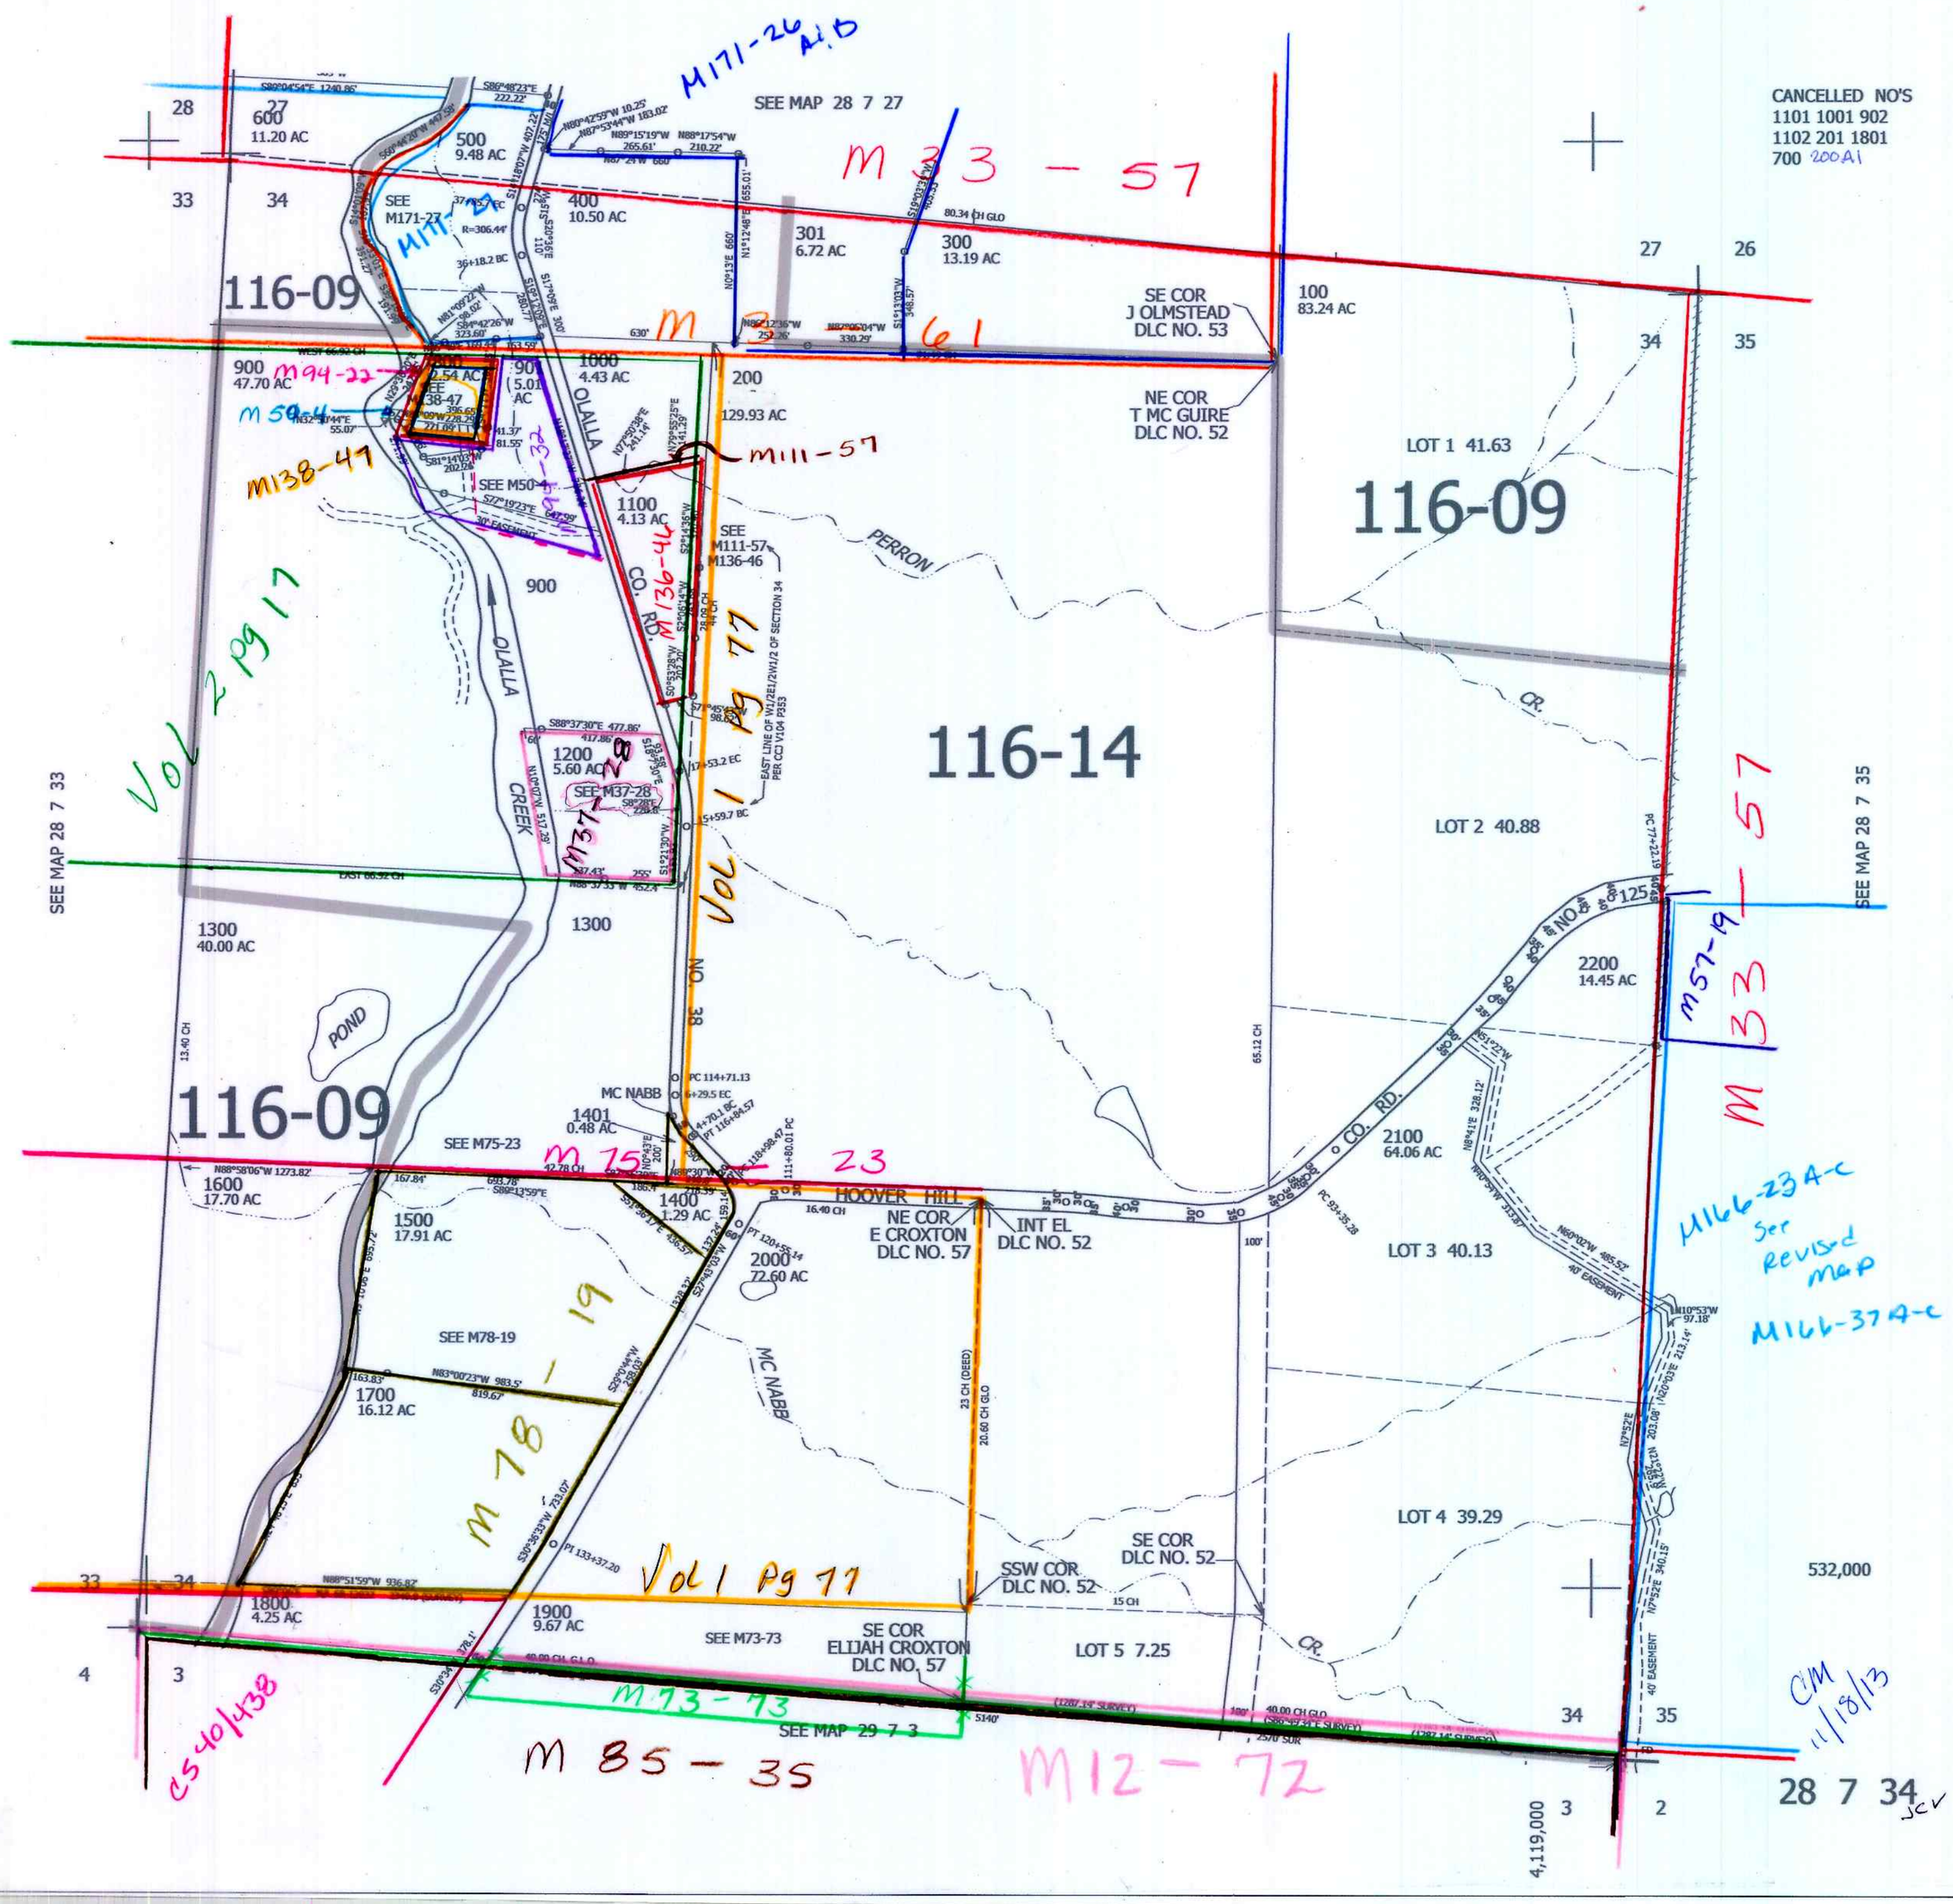
CANCELLED NO'S
1101 1001 902
1102 201 1801
700 200A1