


THIS MAP WAS PREPARED FOR ASSESSMENT PURPOSE ONLY.

SEC.35 T.28S. R.7W. W.M. DOUGLAS COUNTY

1" = 400'

REVISED ON 5-9-12

28 7 35

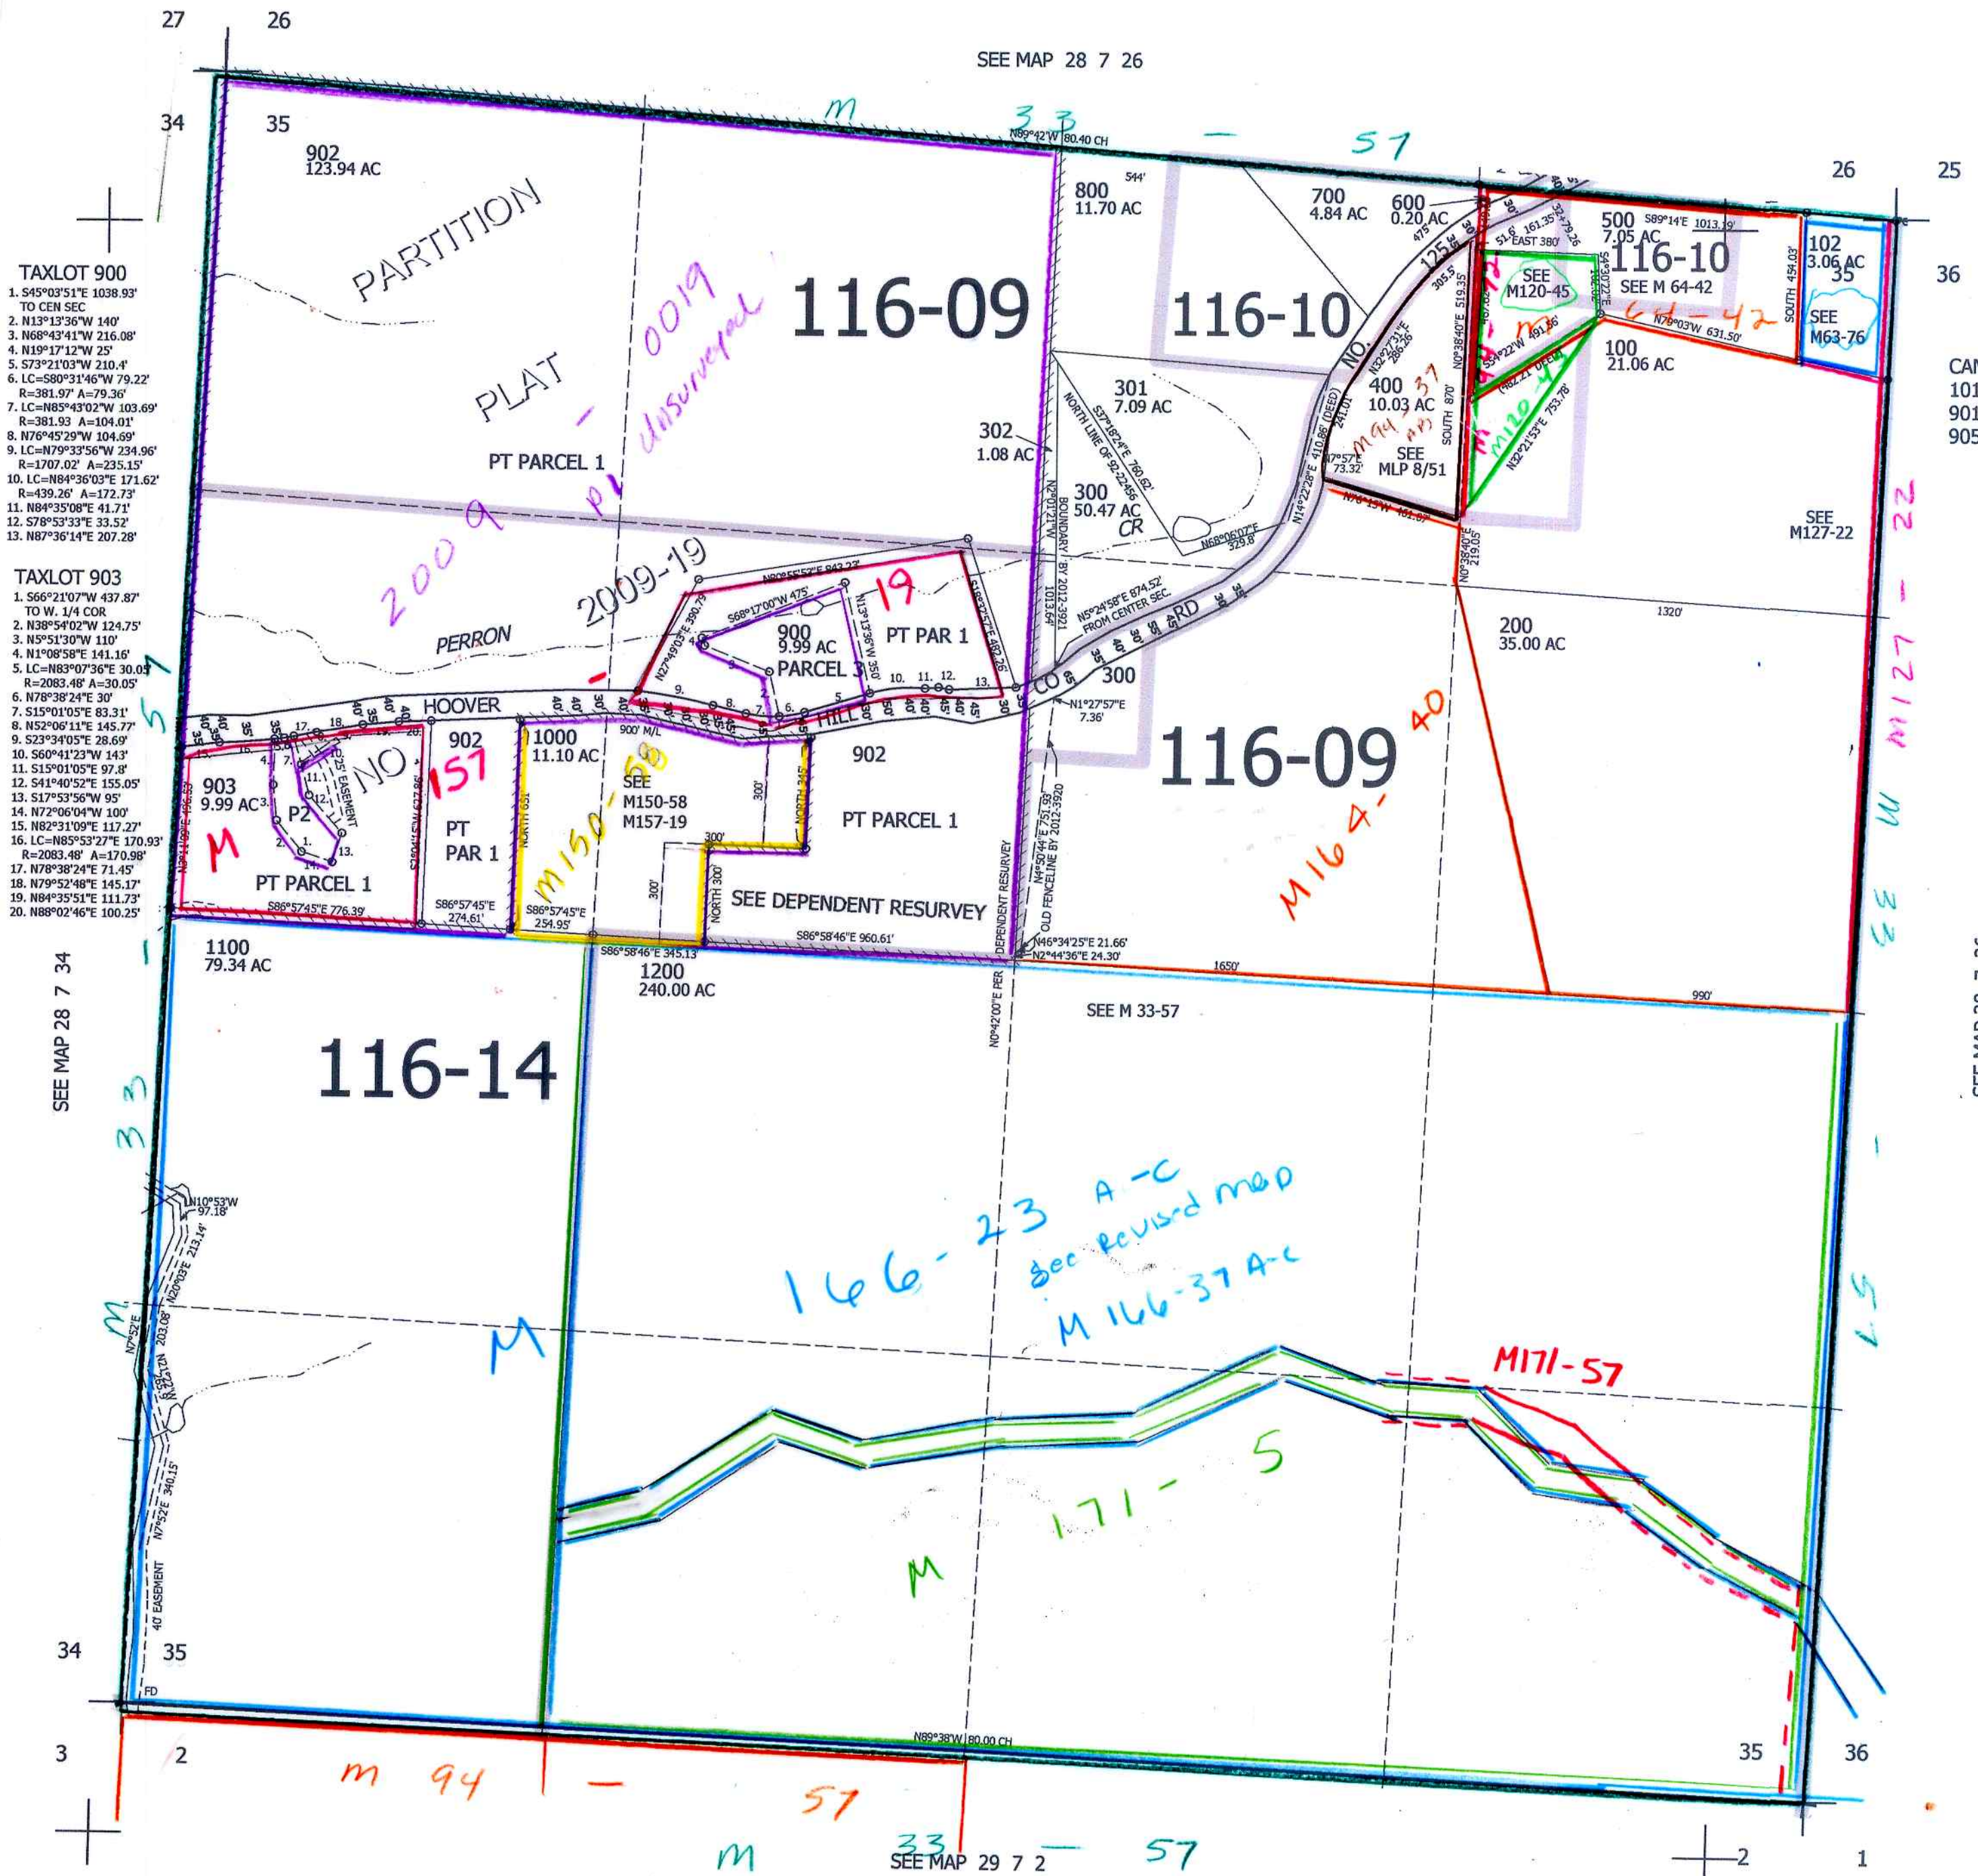

CANCELLED NO'S
101 501 800M1
901 1001 904
905

SEE MAP 28 7 36

SEE MAP 28 7 34

SEE MAP 29 7 2

531,000

4,124,000

CM 5/6/09
JCV
28 7 35