THIS MAP WAS PREPARED FOR ASSESSMENT PURPOSE ONLY.

SECTION 2 T.28S. R.8W. W.M.
DOUGLAS COUNTY

1" = 400'

REVISED ON 12-30-93
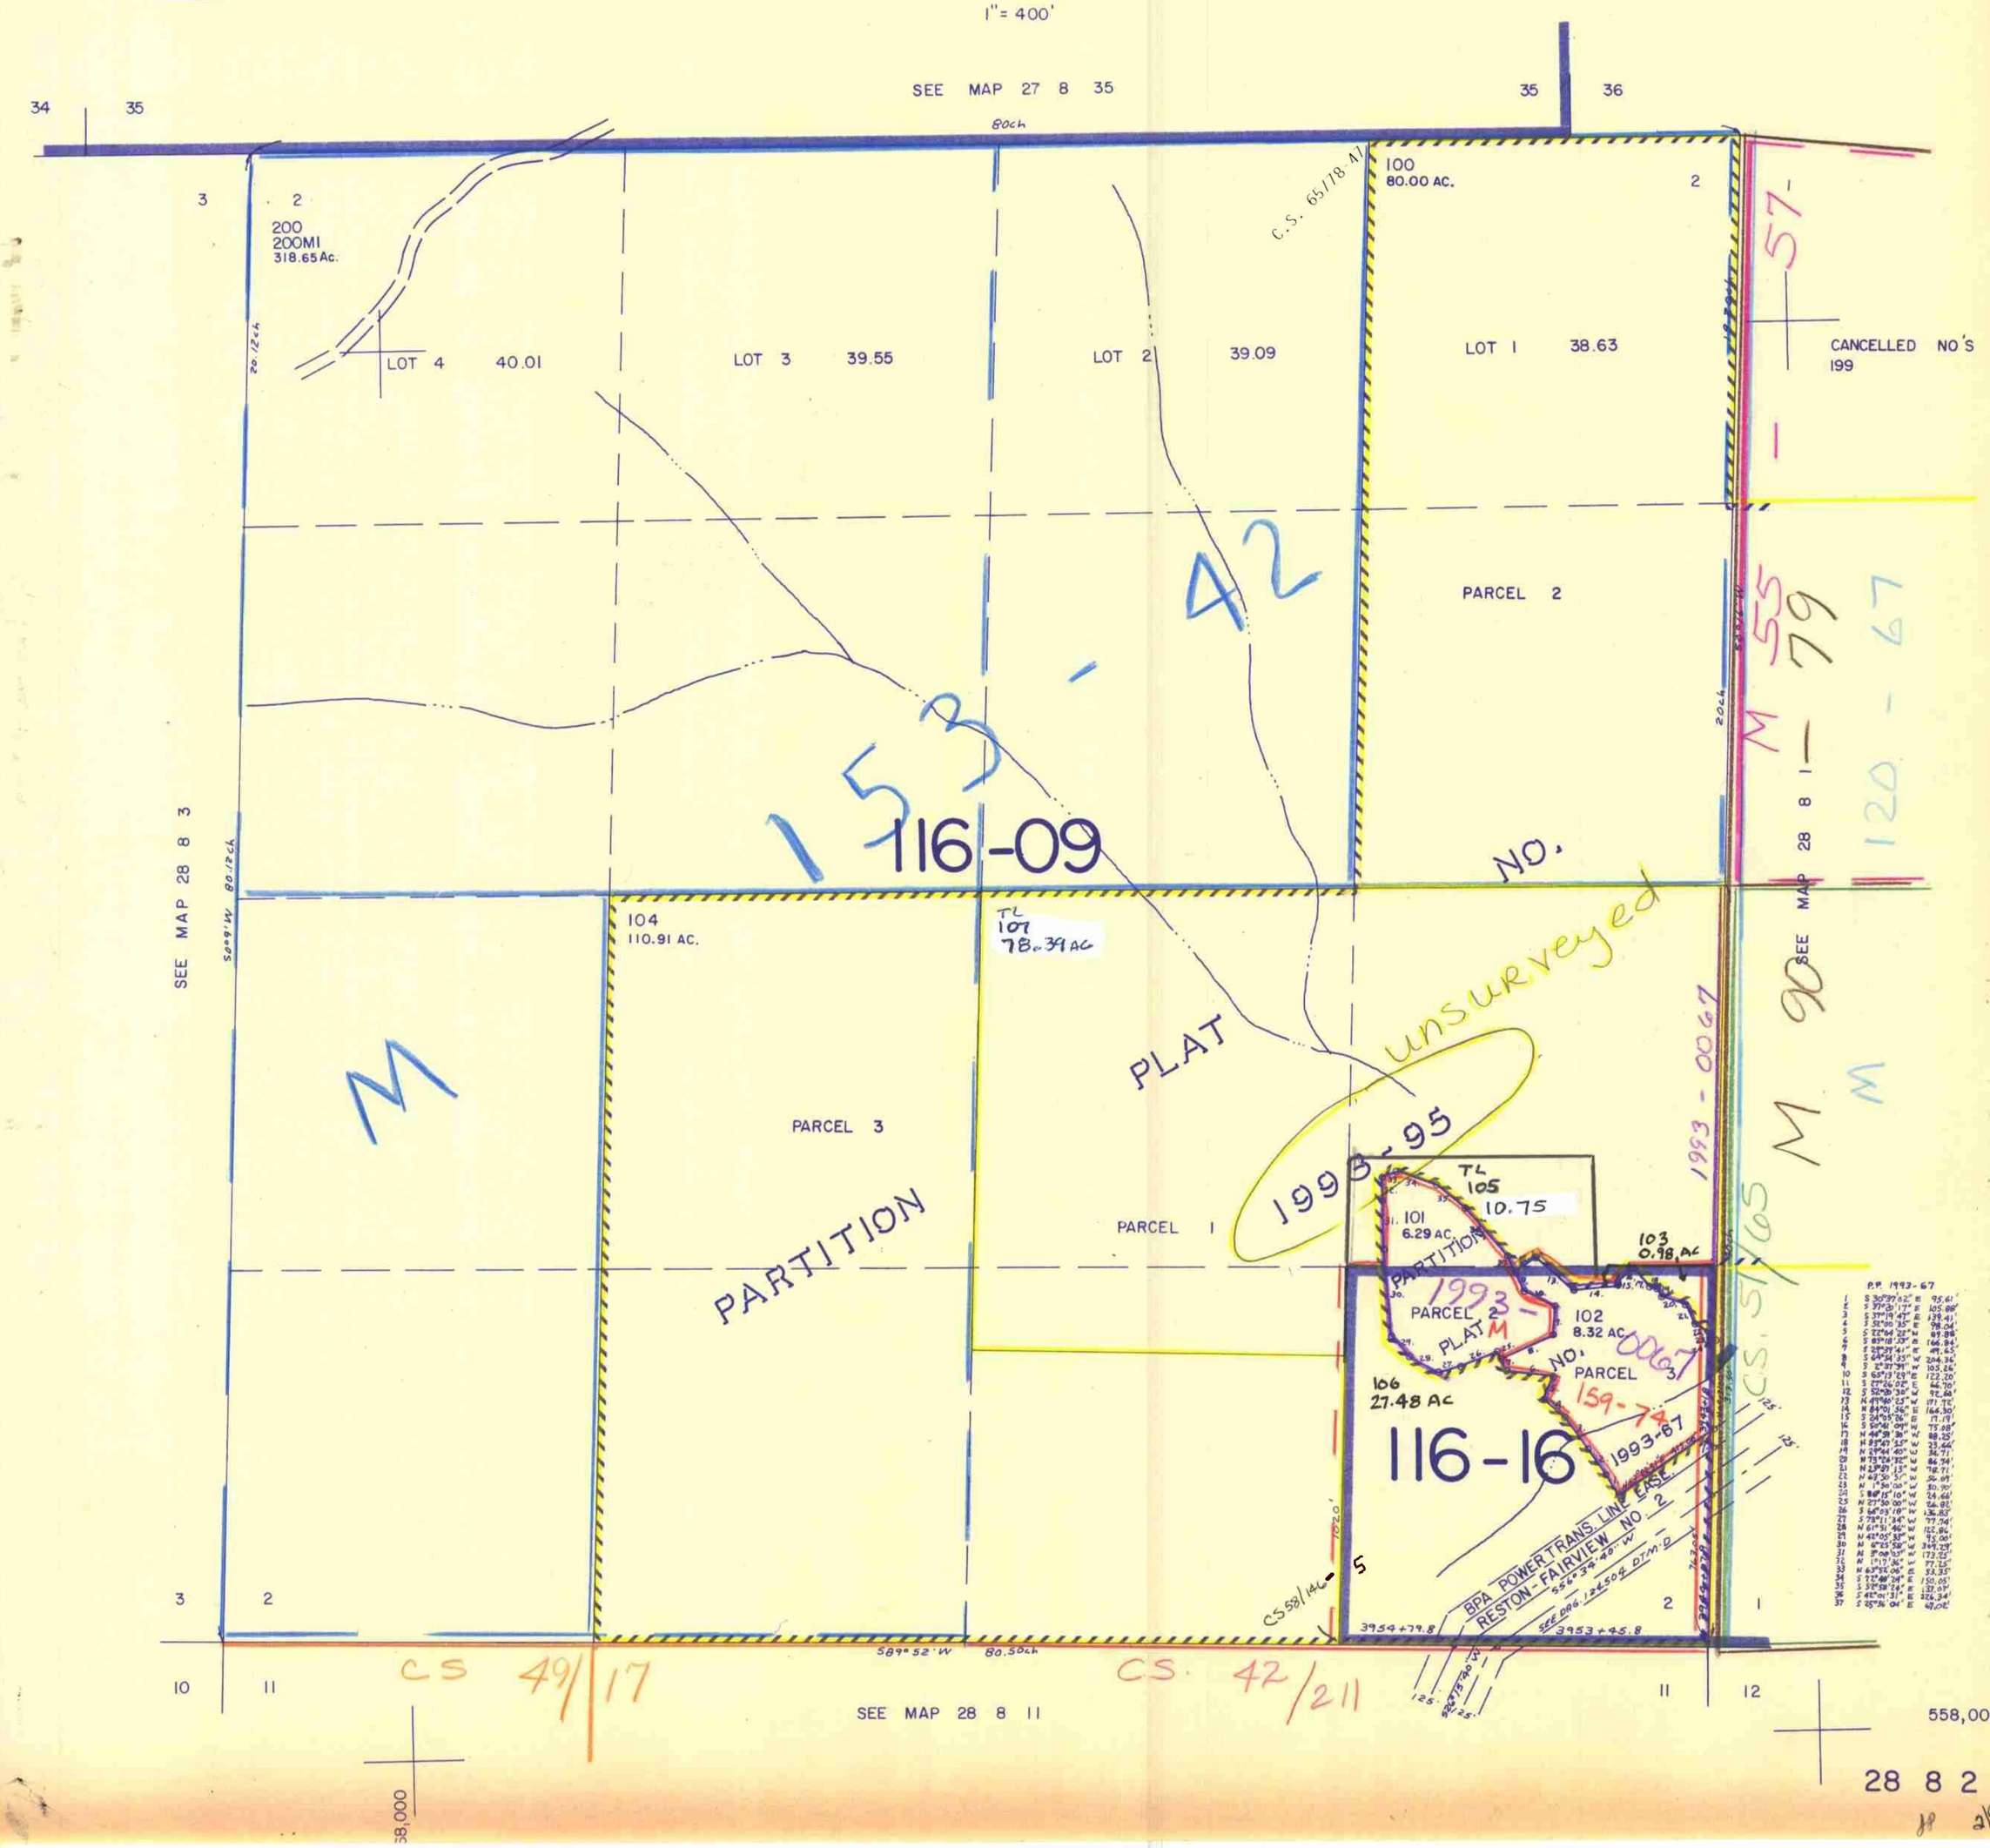
28 8 2