THIS MAP WAS PREPARED FOR ASSESSMENT PURPOSE ONLY.

SEC.11 T.28S. R.8W. W.M.
DOUGLAS COUNTY

REVISED ON 5-21-21

28 8 11

1" = 400'

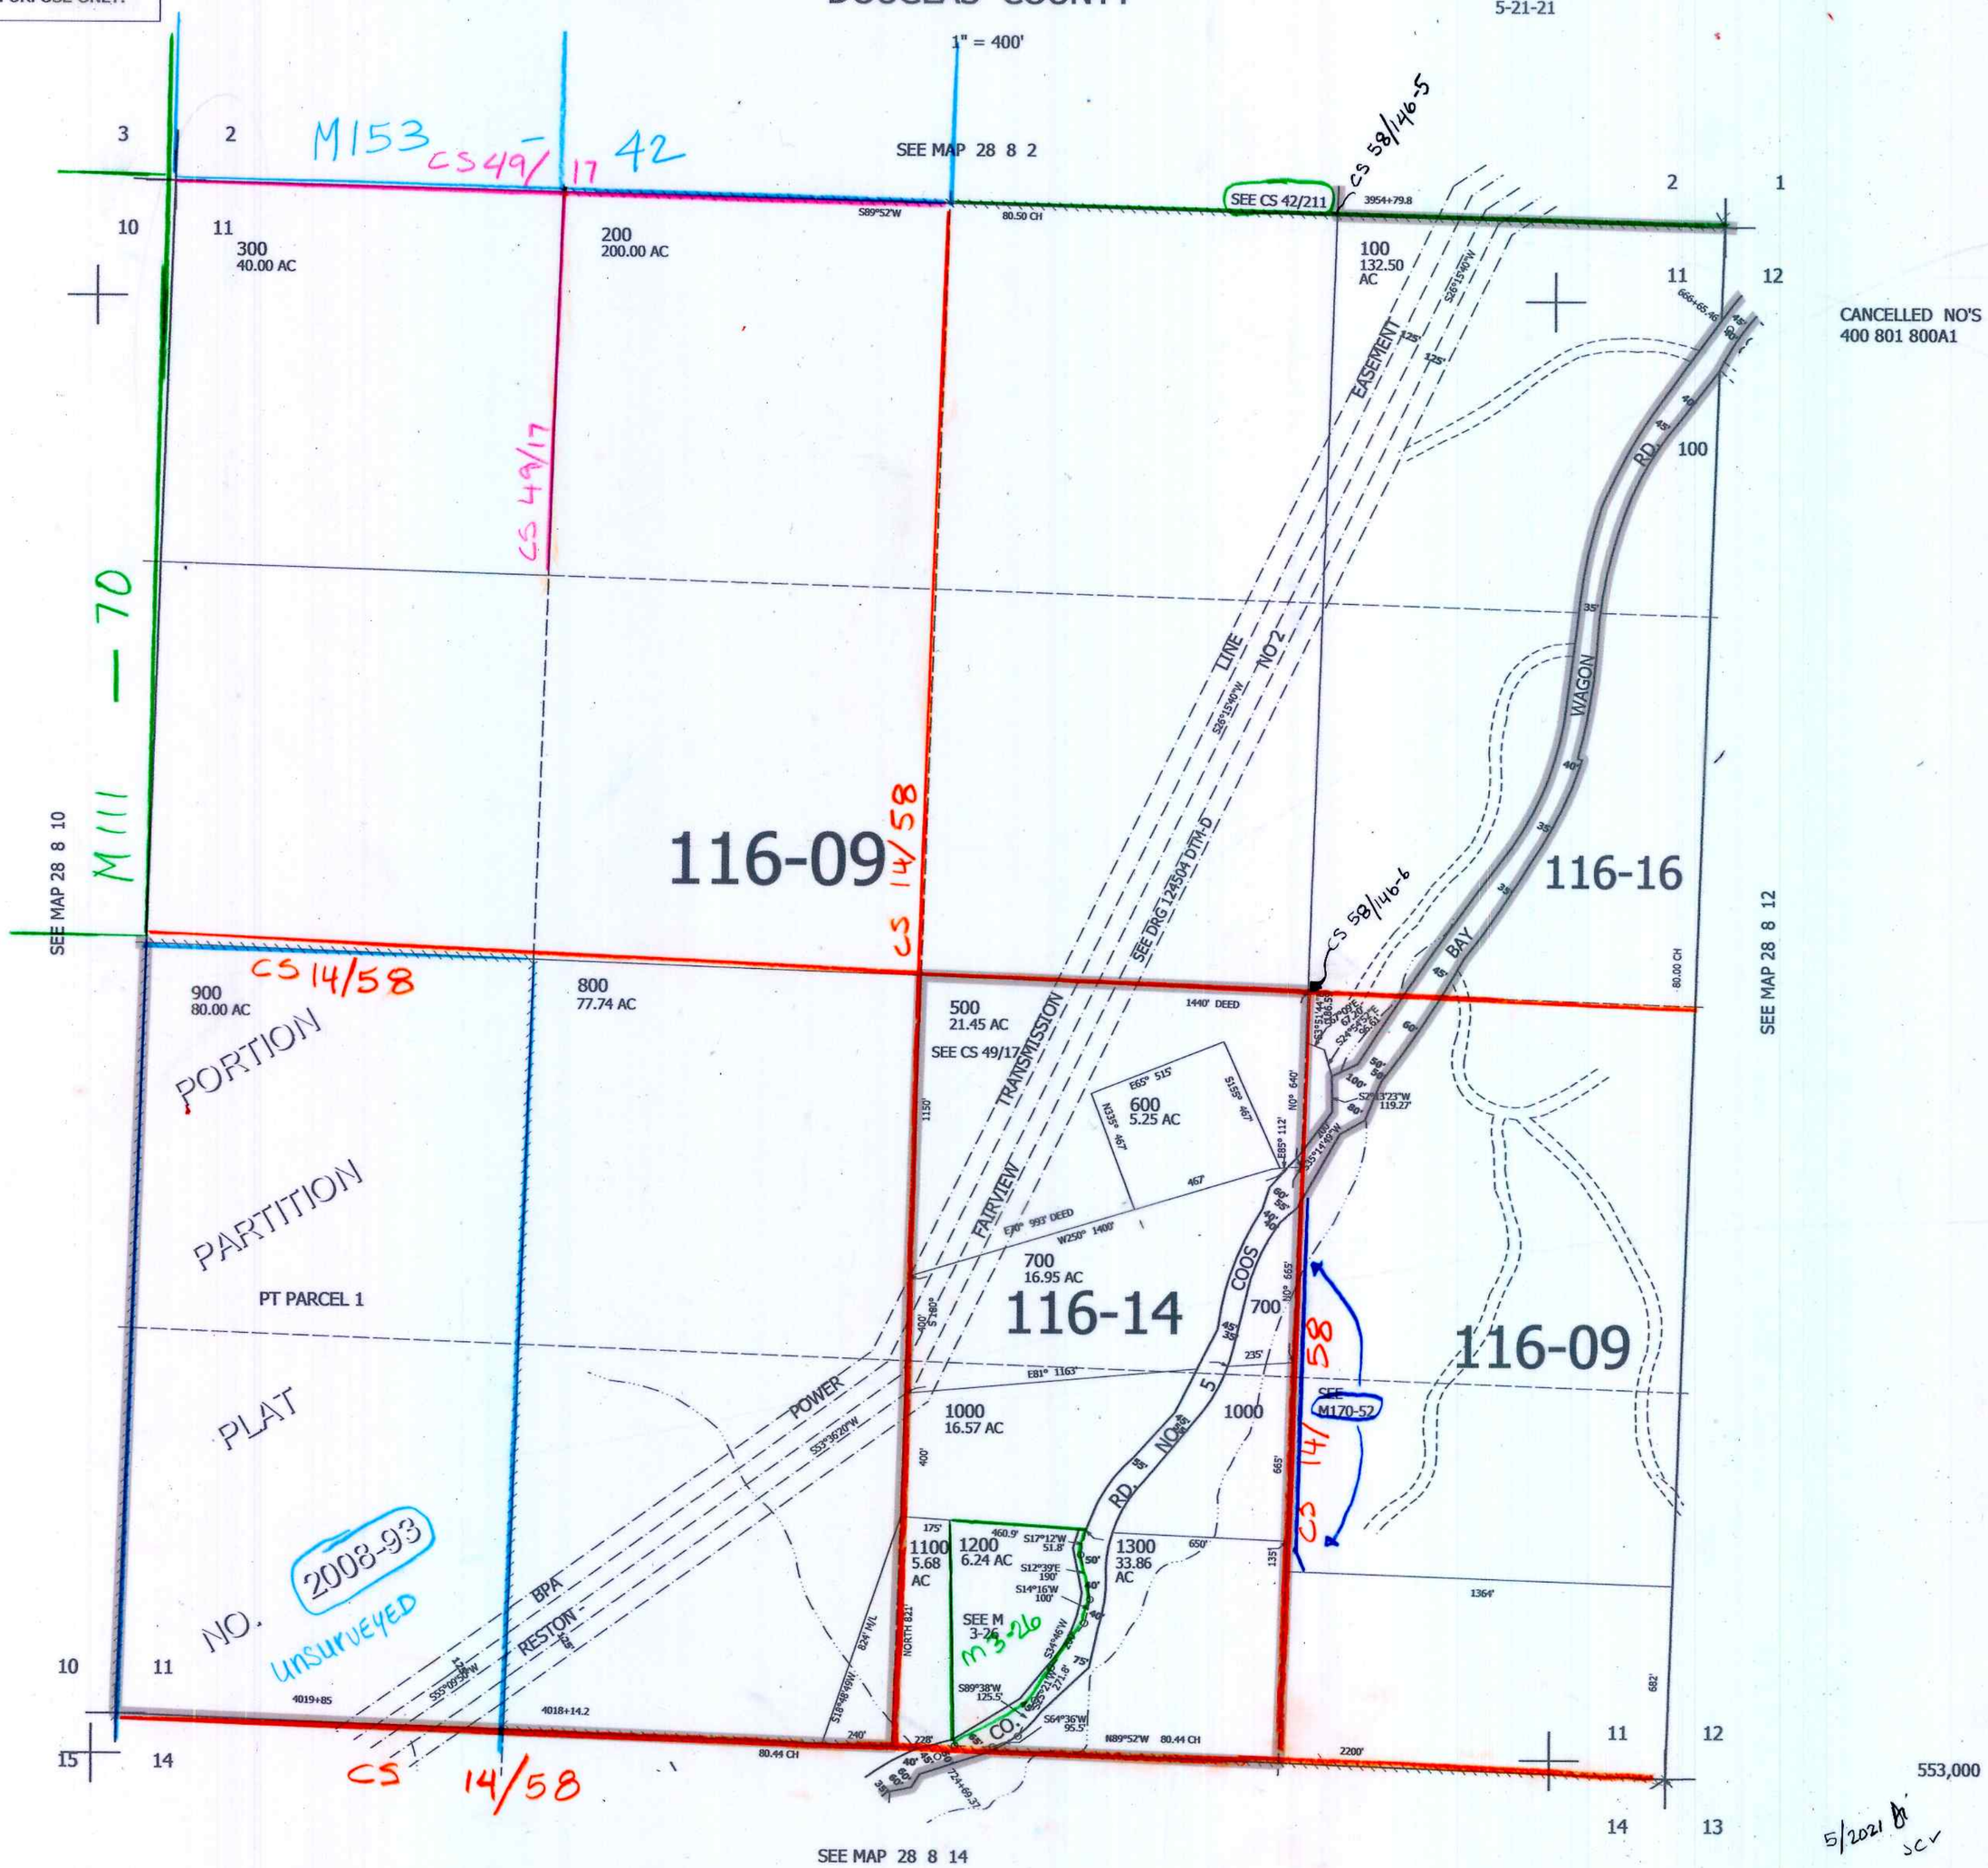

CANCELLED NO'S
400 801 800A1

553,000

4,093,000

5/2021 JCV

28 8 11