


THIS MAP WAS PREPARED FOR ASSESSMENT PURPOSE ONLY.

SECTION 35 T.28S. R.8W. W.M.
DOUGLAS COUNTY

28 8 35

1" = 400'

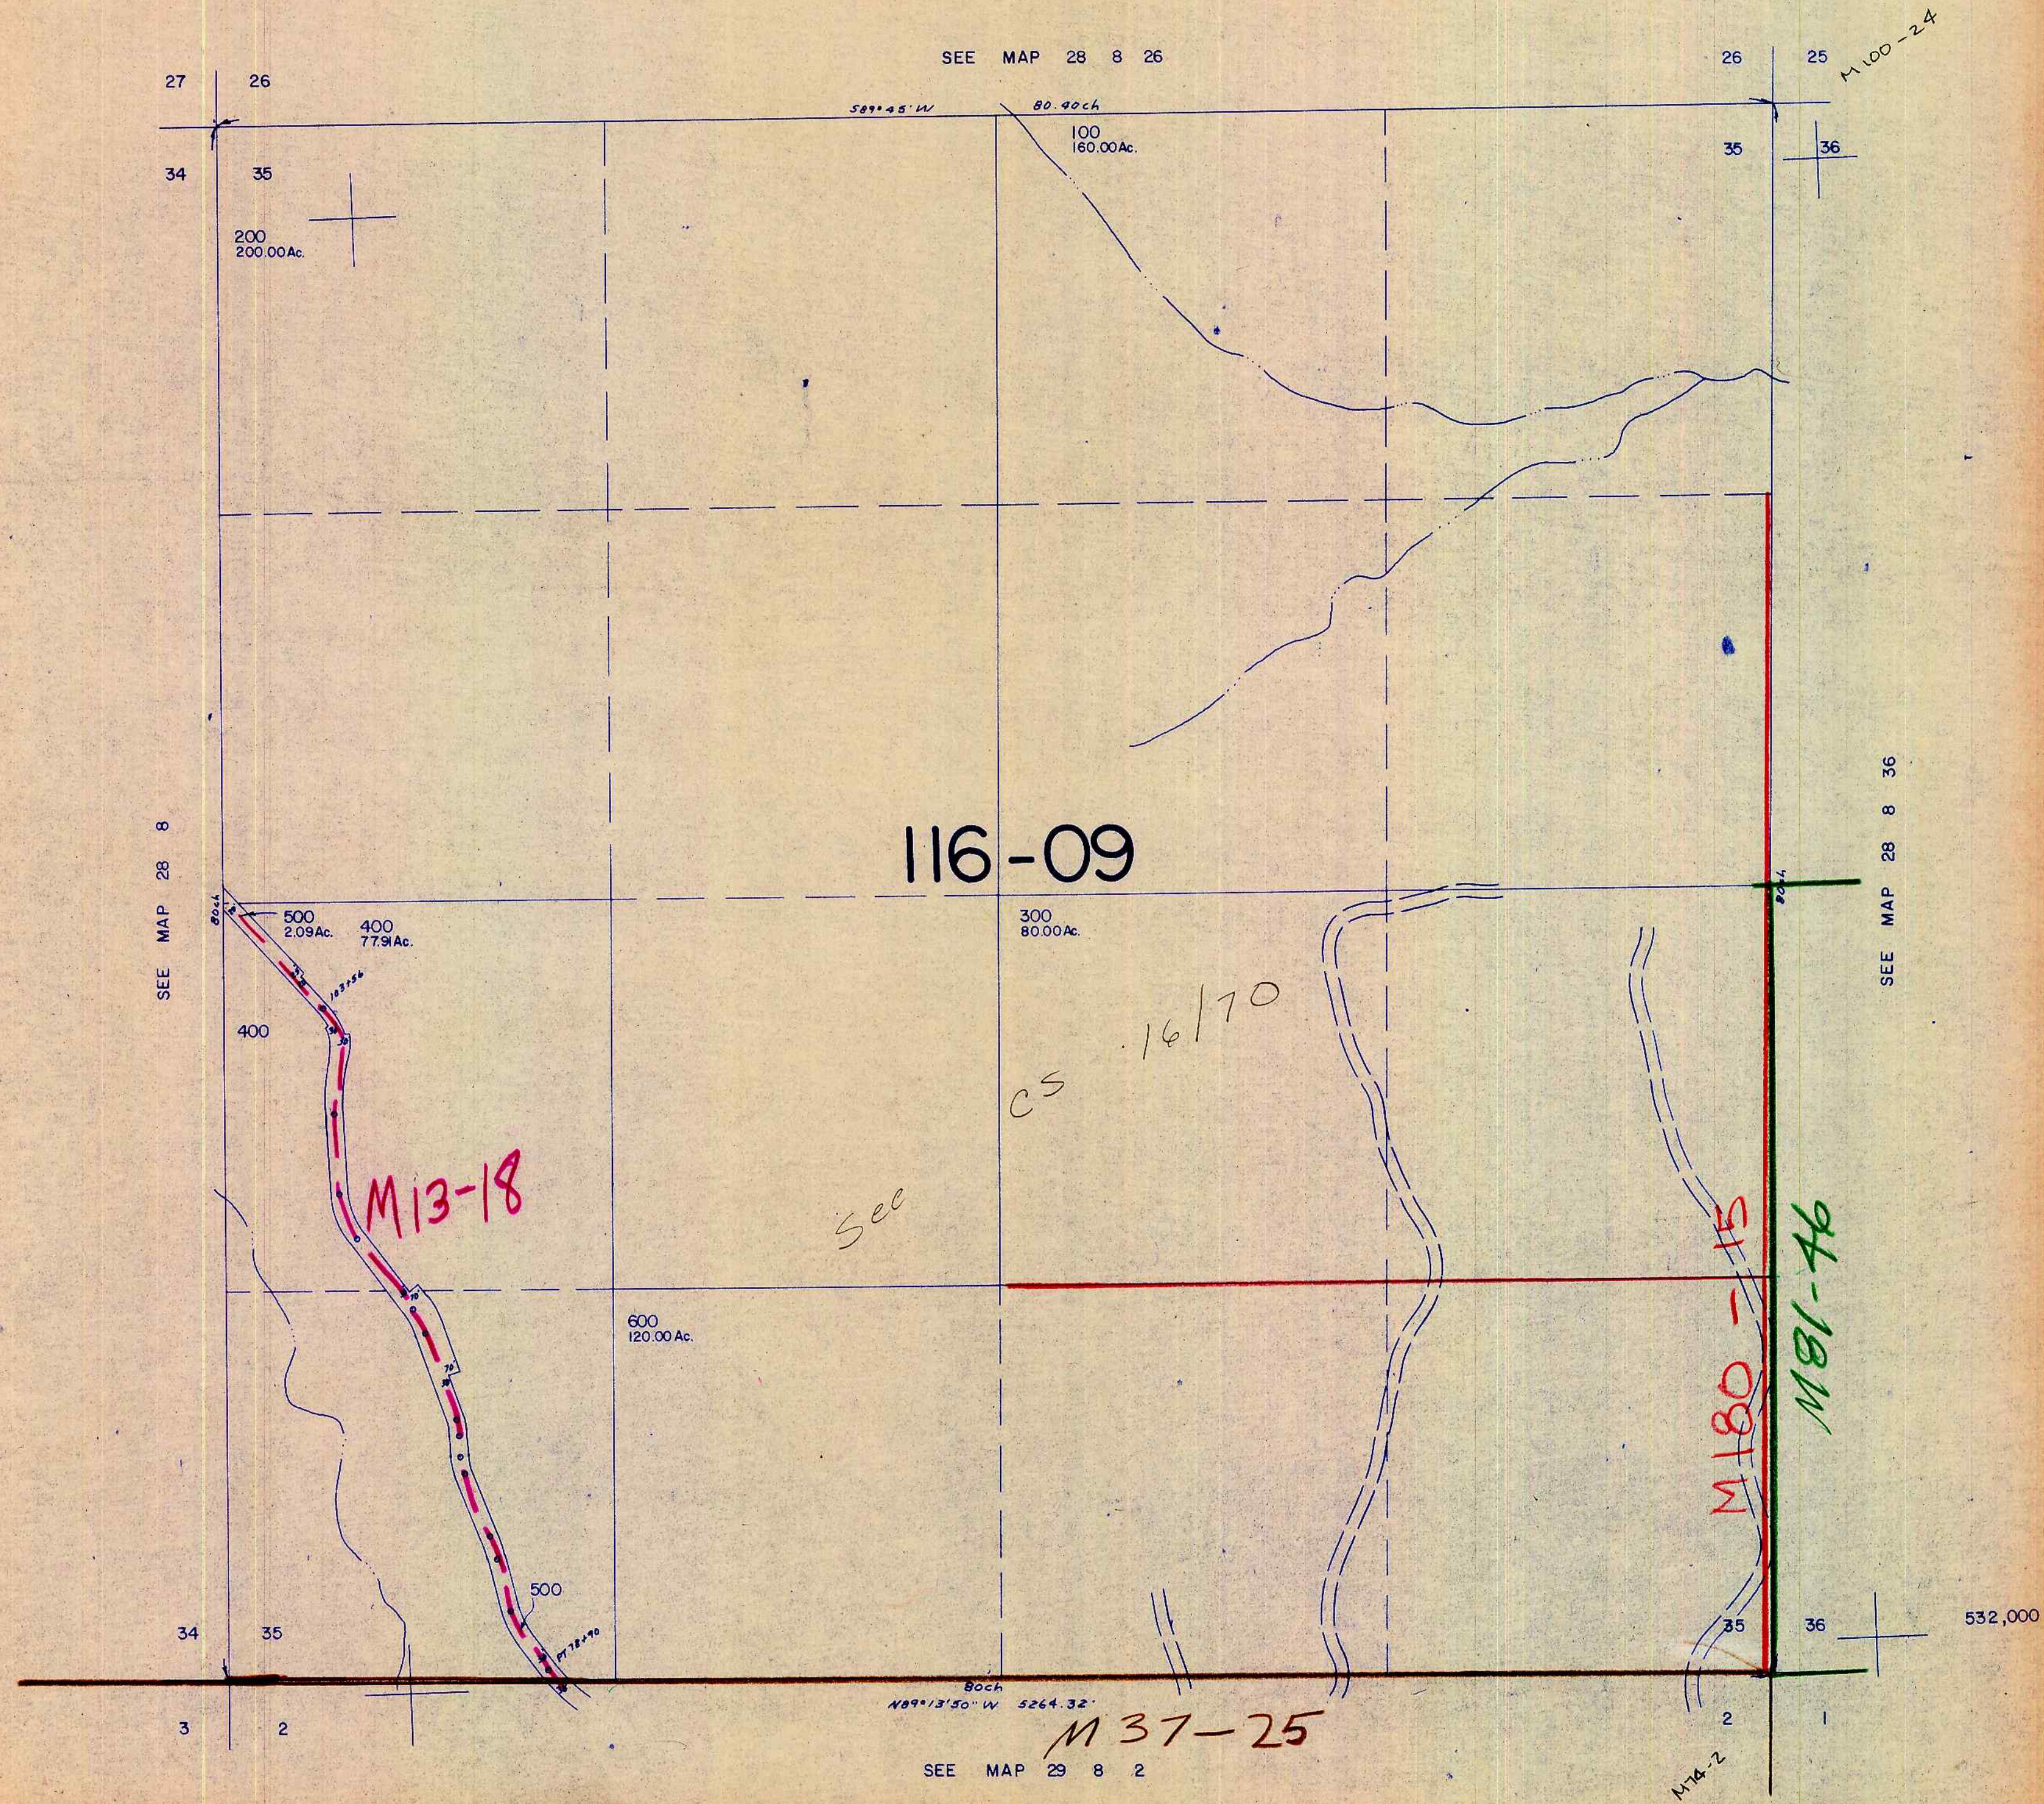

28 8 35

4/85
C.M.O.