HOMESTEAD DETAIL T.29S. R.1E. W.M.
DOUGLAS COUNTY

1" - 400'

29 1E
DETAIL MAP
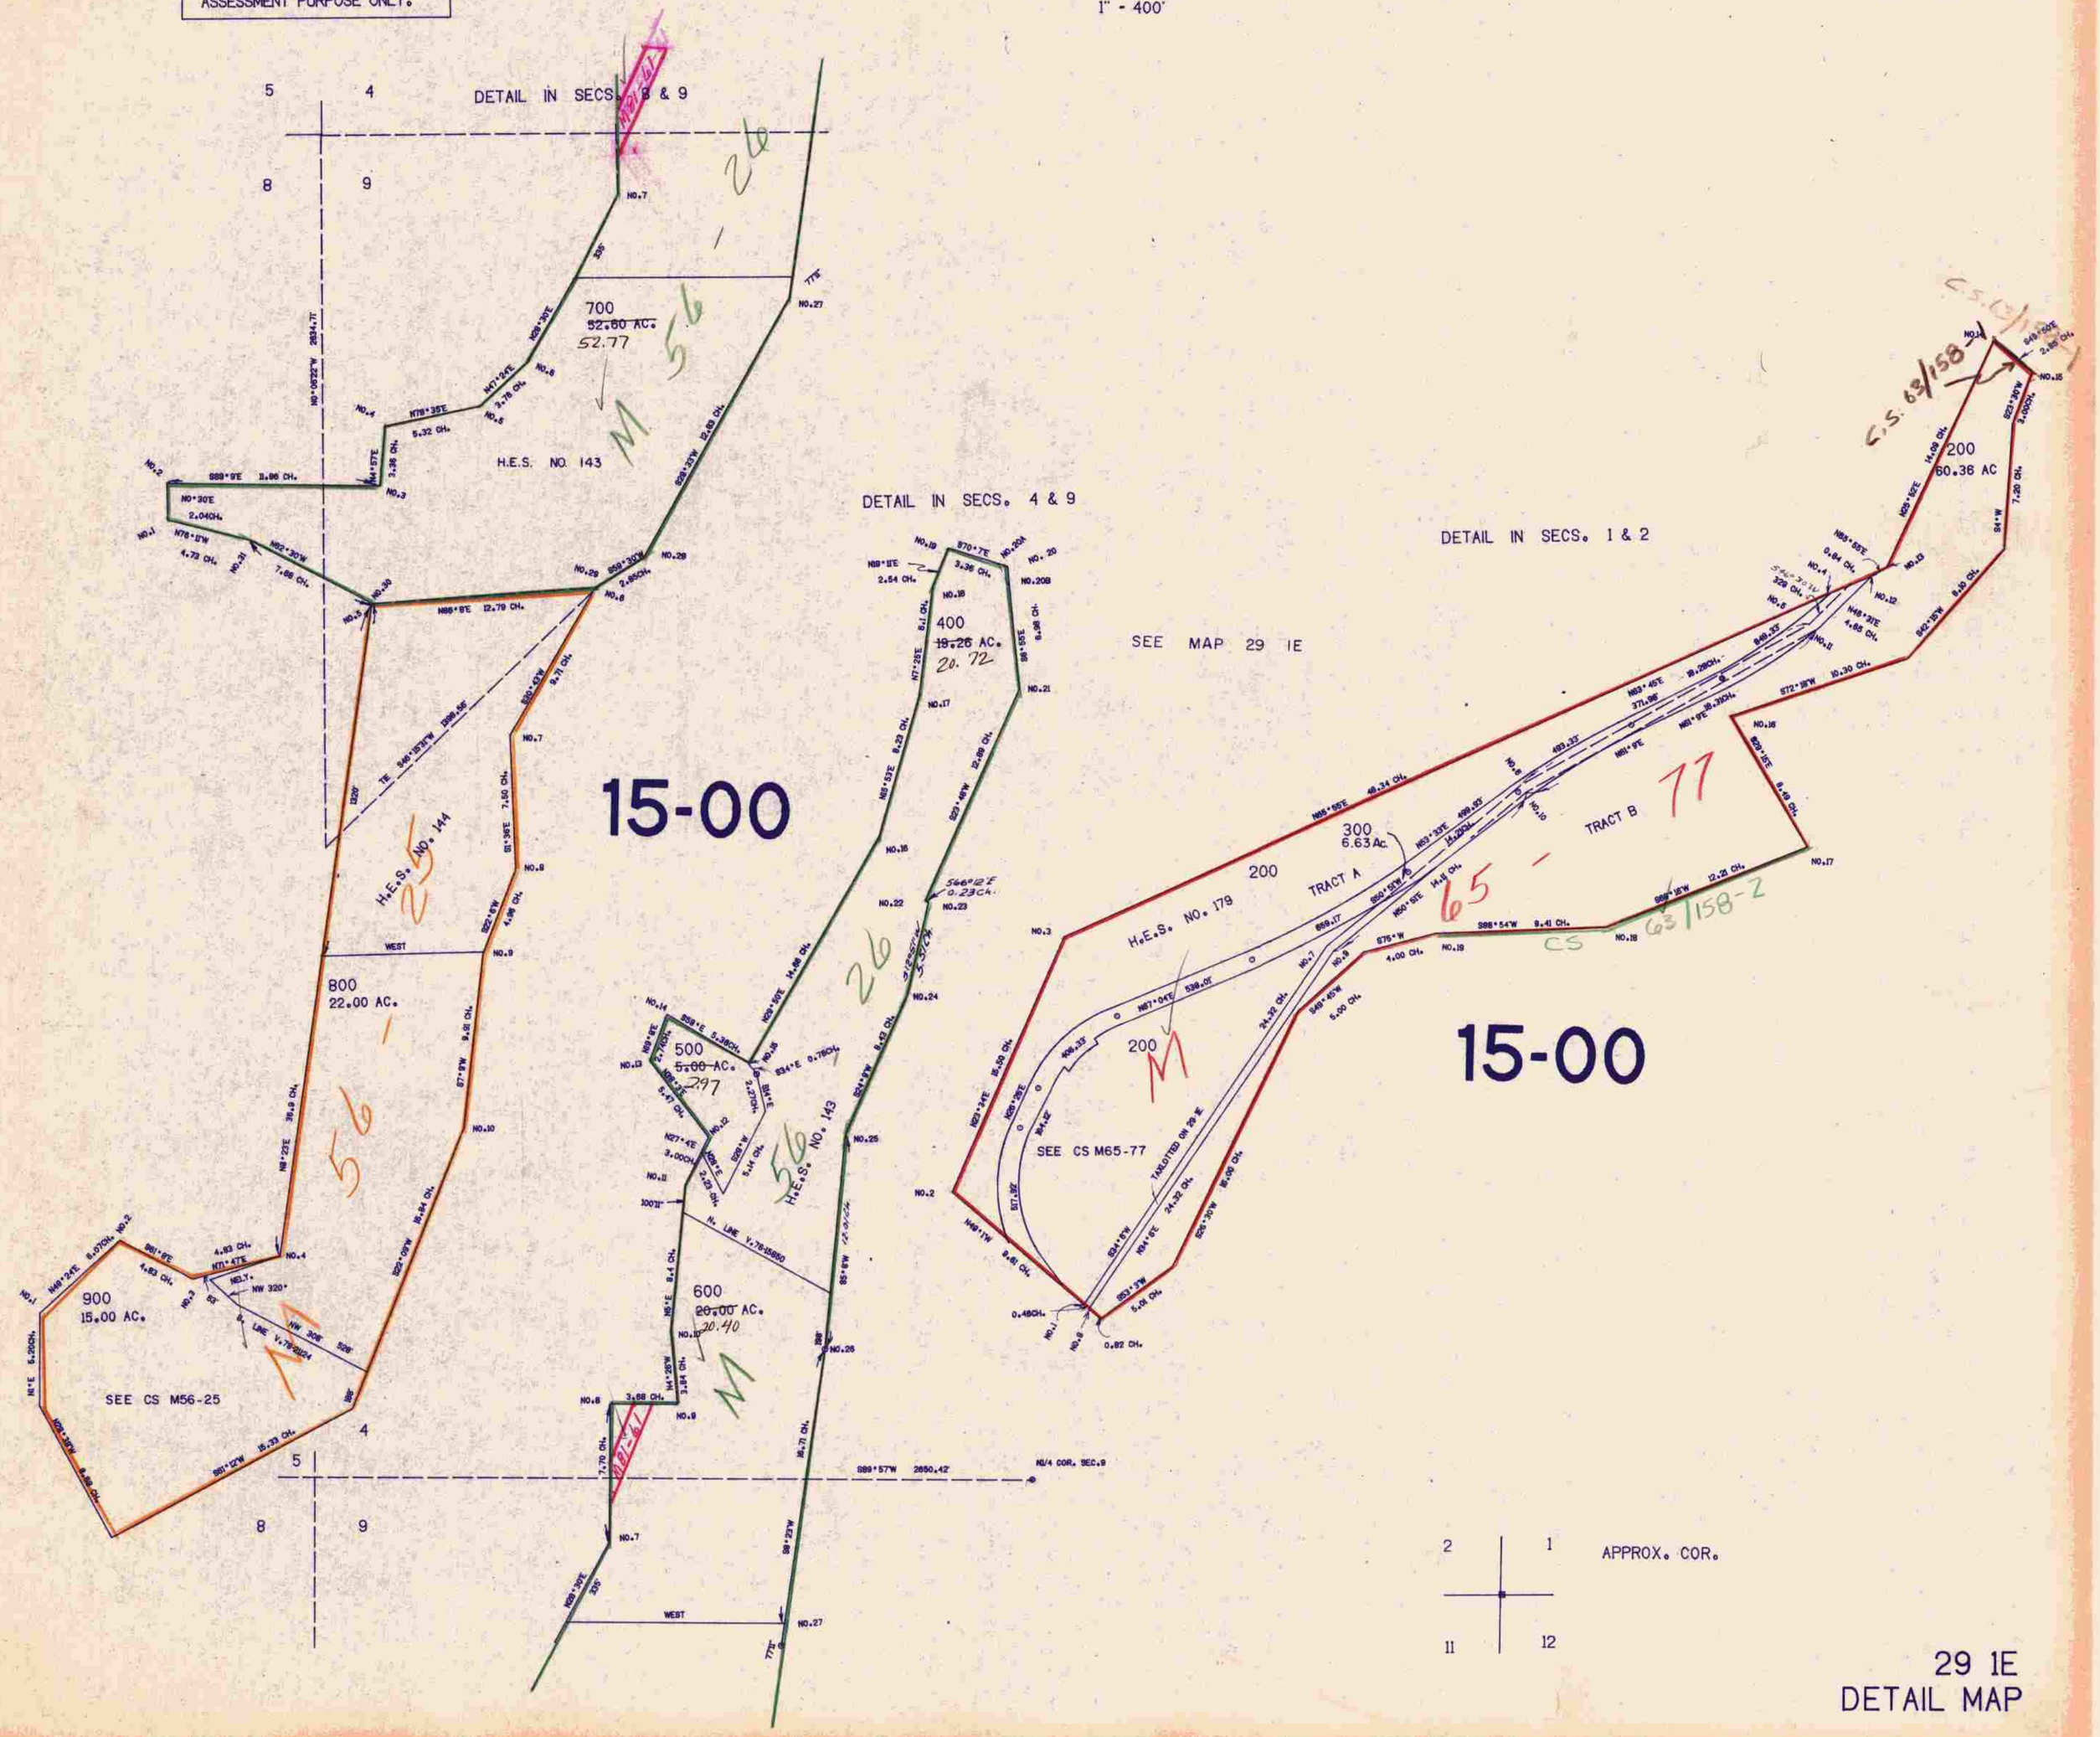
THIS MAP WAS PREPARED FOR ASSESSMENT PURPOSE ONLY.