


SECTION 33 T29S R. 1 W. M.
DOUGLAS COUNTY

1" = 400'

SEE MAP 29 | 28

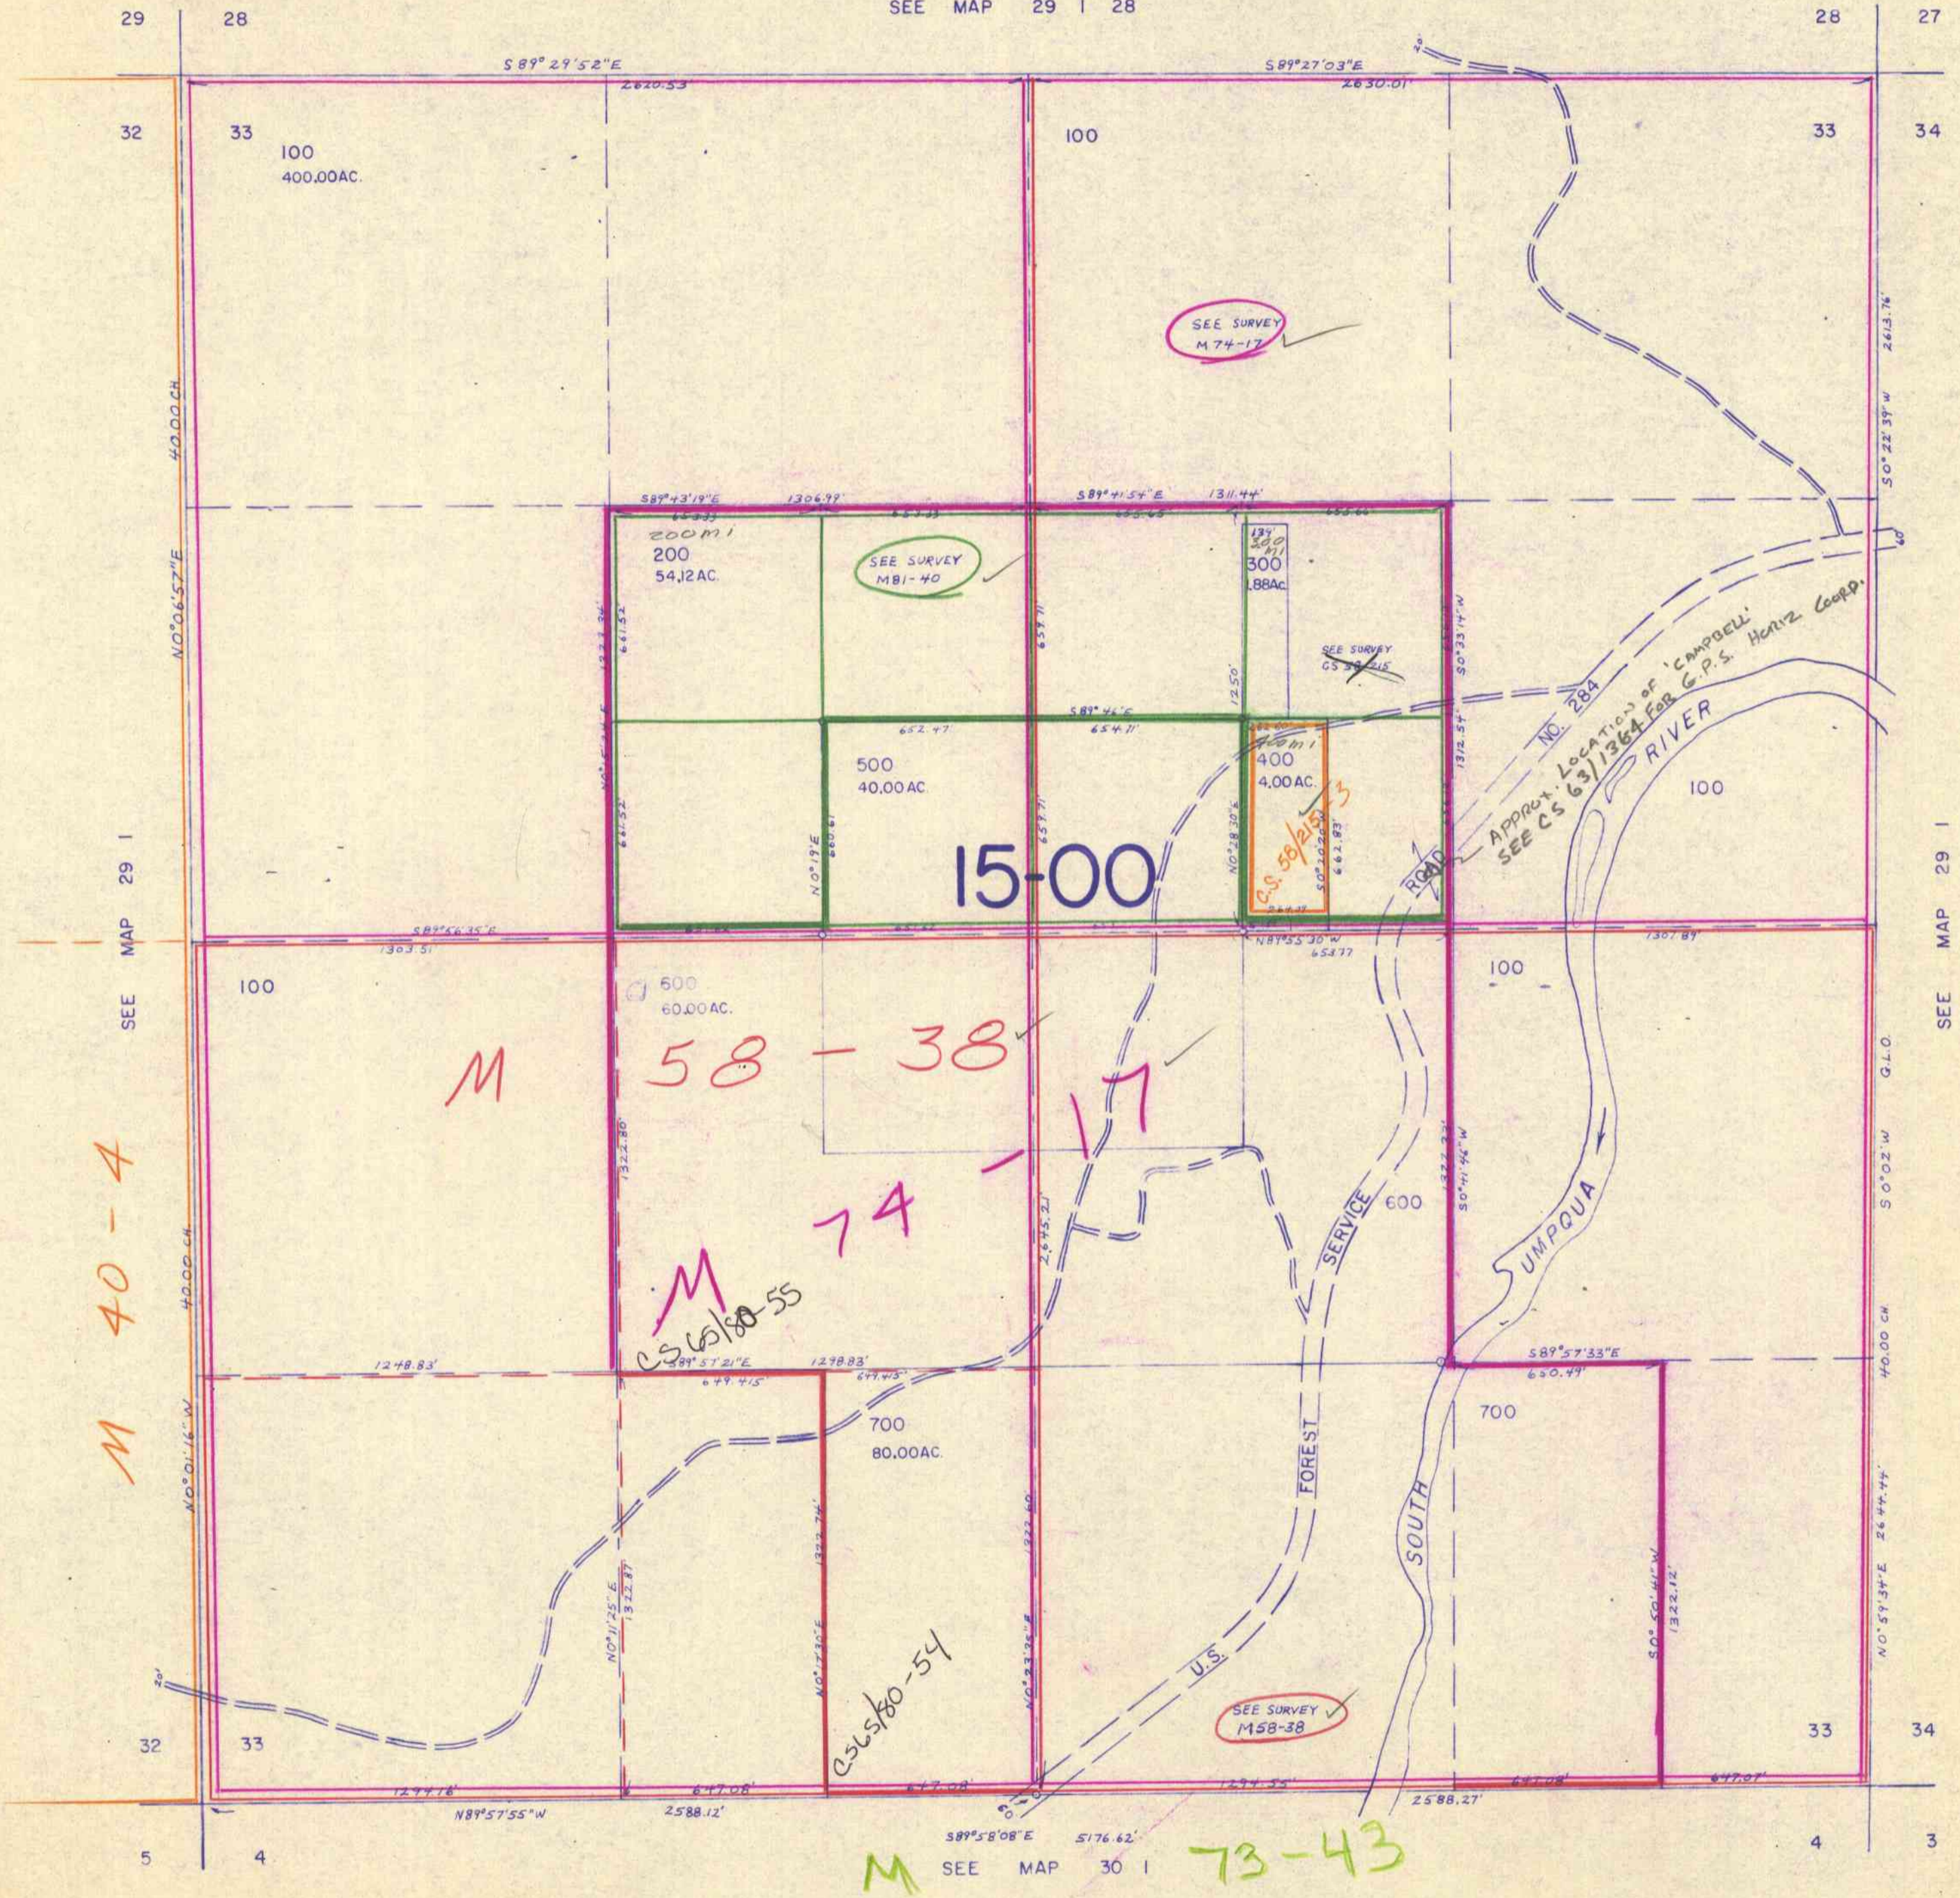

10/84
B2