


THIS MAP WAS PREPARED FOR ASSESSMENT PURPOSE ONLY.

T.29S. R.2W. W.M.
DOUGLAS COUNTY

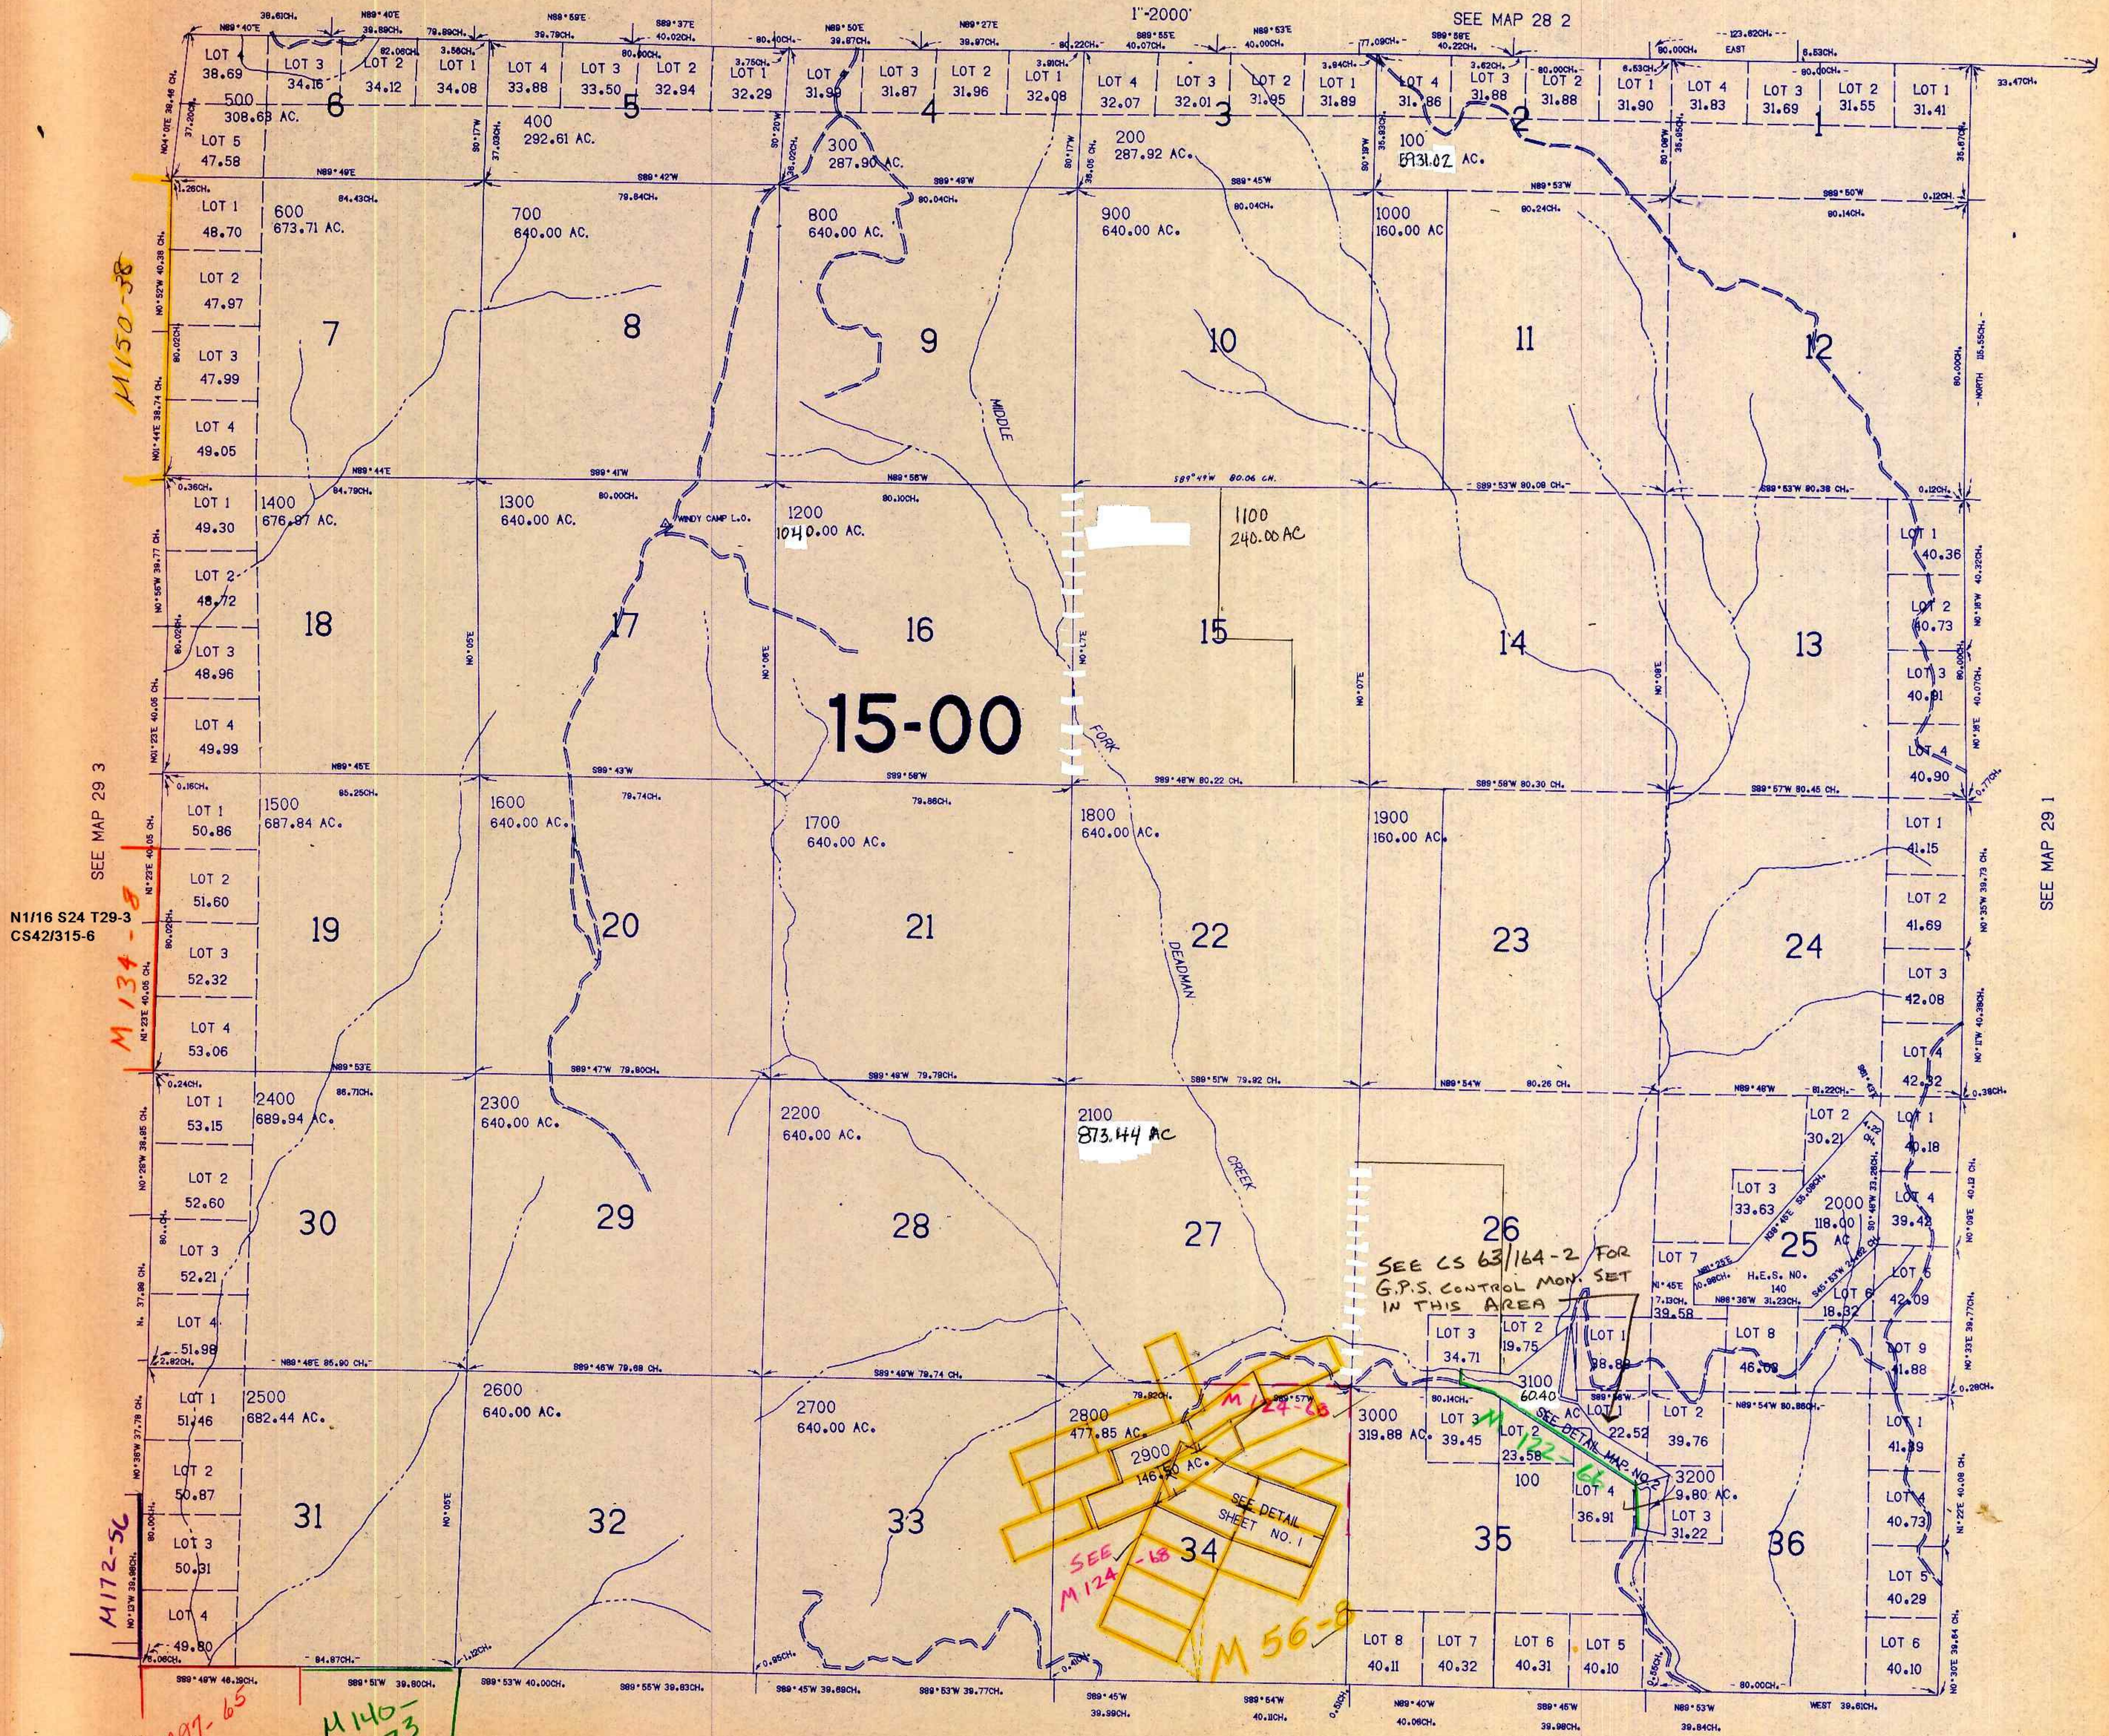

SEE MAP 30 2

10/84 BS