


THIS MAP WAS PREPARED FOR ASSESSMENT PURPOSE ONLY.

DETAIL SHEET NO. 2
T.29S. R.2W. W.M.
DOUGLAS COUNTY
1" = 400'

REVISED ON
4-14-04

29 2 00
DETAIL SHEET
NO. 2 OF 2

27 26
34 35

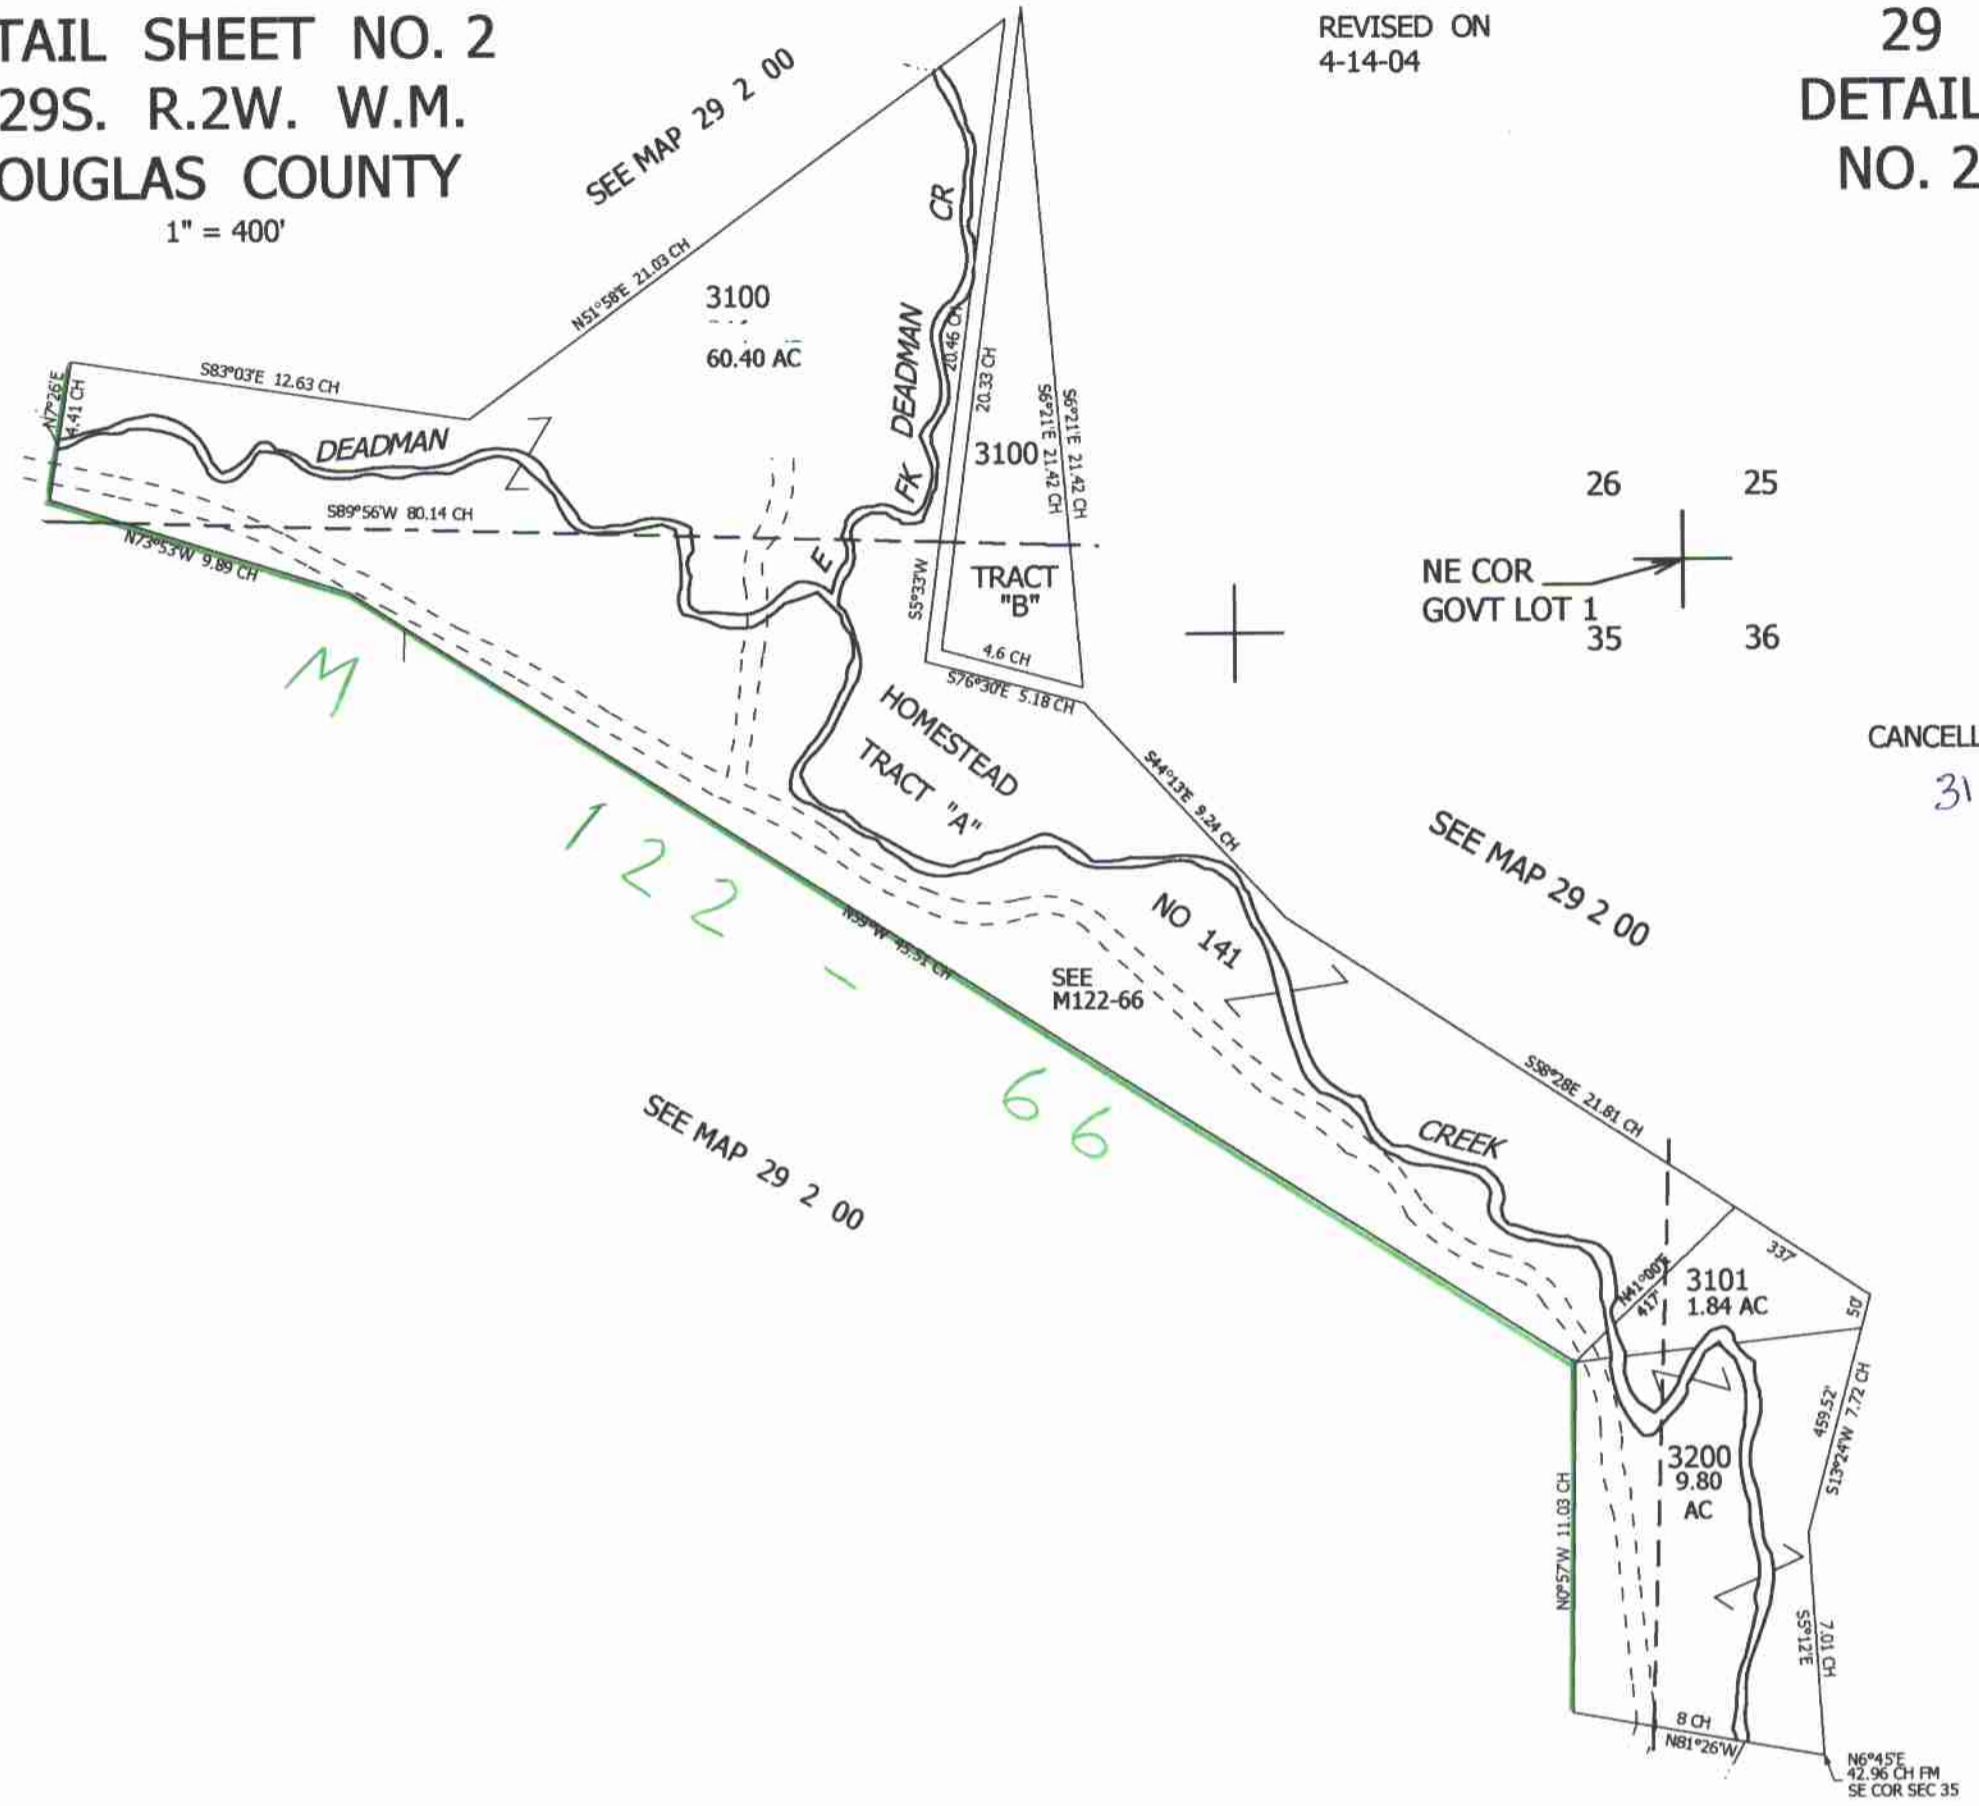

26 25
NE COR
GOVT LOT 1
35 36

CANCELLED NO'S
31 00 41

SEE MAP 29 2 00

34 35
3 2



35 36
2 1

4,278,000

497,000

29 2 00
DETAIL SHEET
NO. 2 OF 2

4/04 JP No