THIS MAP WAS PREPARED FOR ASSESSMENT PURPOSE ONLY.

SECTION 2 T.29S. R.3W. W.M.
DOUGLAS COUNTY

1"=400'

REVISED ON 6-11-92
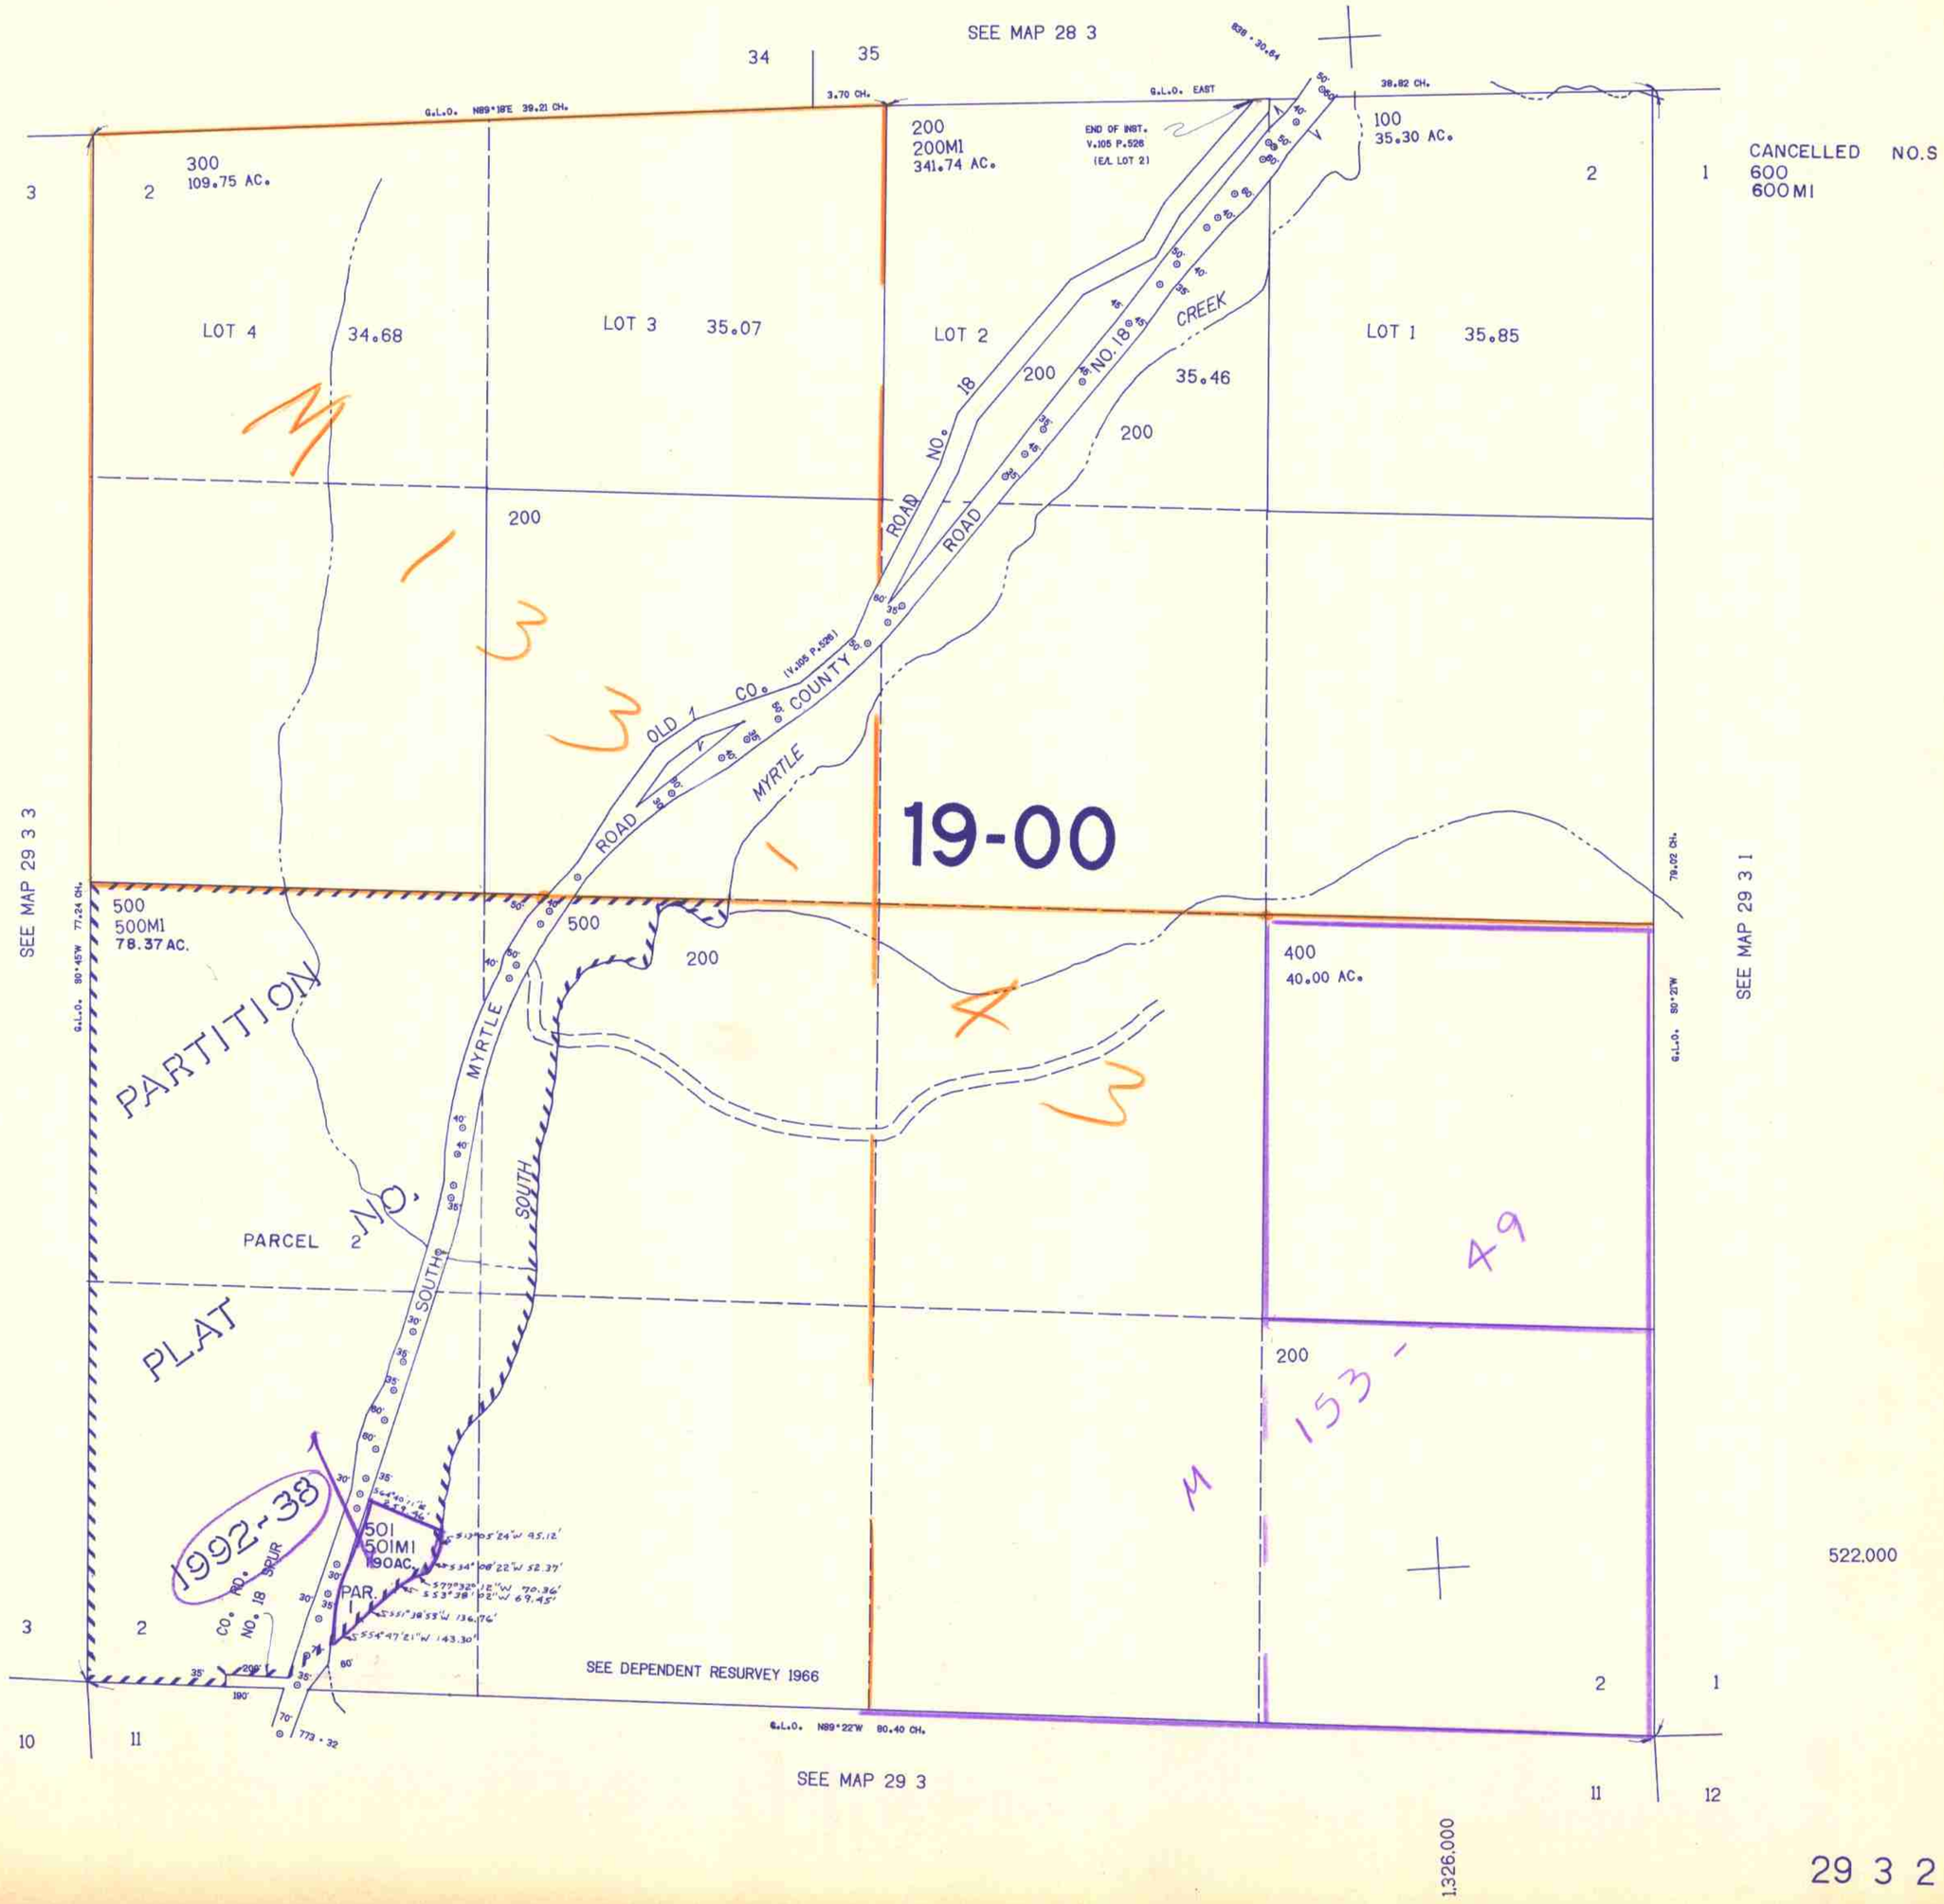
29 3 2