SECTION 33 T.29S. R.3W. W.M.
DOUGLAS COUNTY

1"=400'

THIS MAP WAS PREPARED FOR ASSESSMENT PURPOSE ONLY.

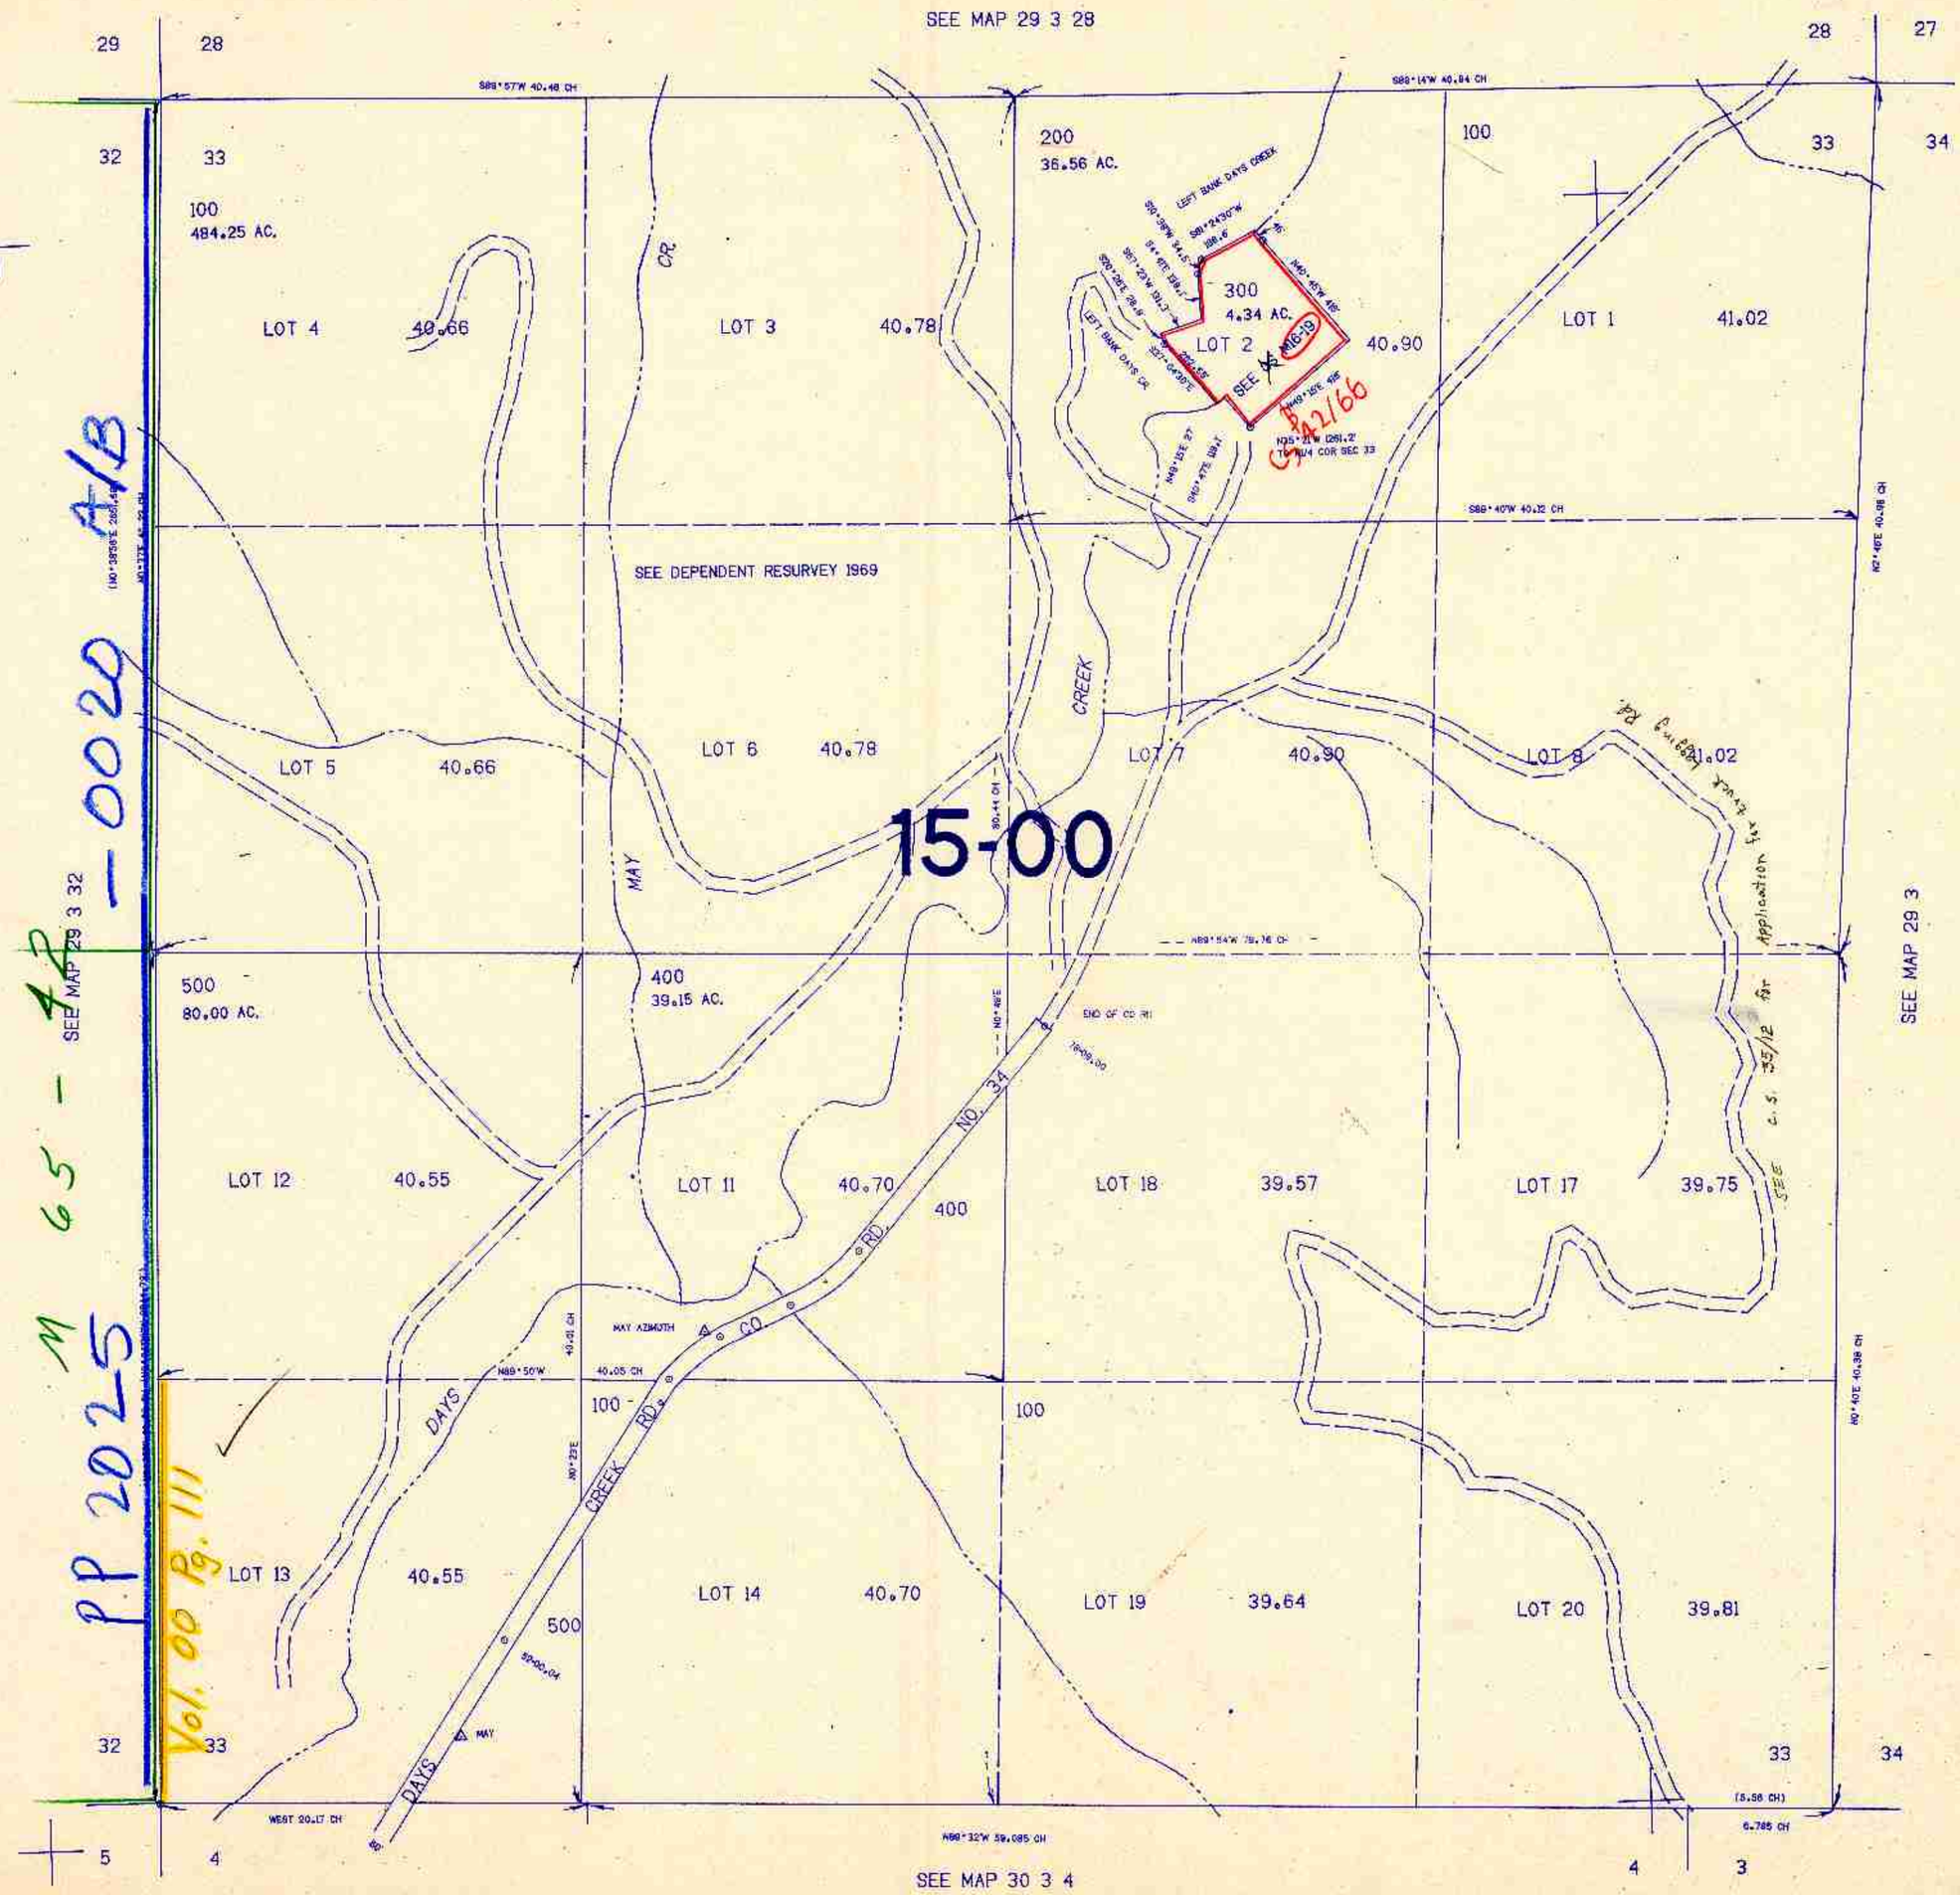

15-00

PP 2025 M 65 - 42

Vol. 00 Pg. 111

A/B

-0020

10/84 BS