

T.29S. R.4W. W.M.
DOUGLAS COUNTY


1" = 2000'

SEE MAP 28 4

M185-29 A-D

29 4
& INDEX

THIS MAP WAS PREPARED FOR
ASSESSMENT PURPOSE ONLY.

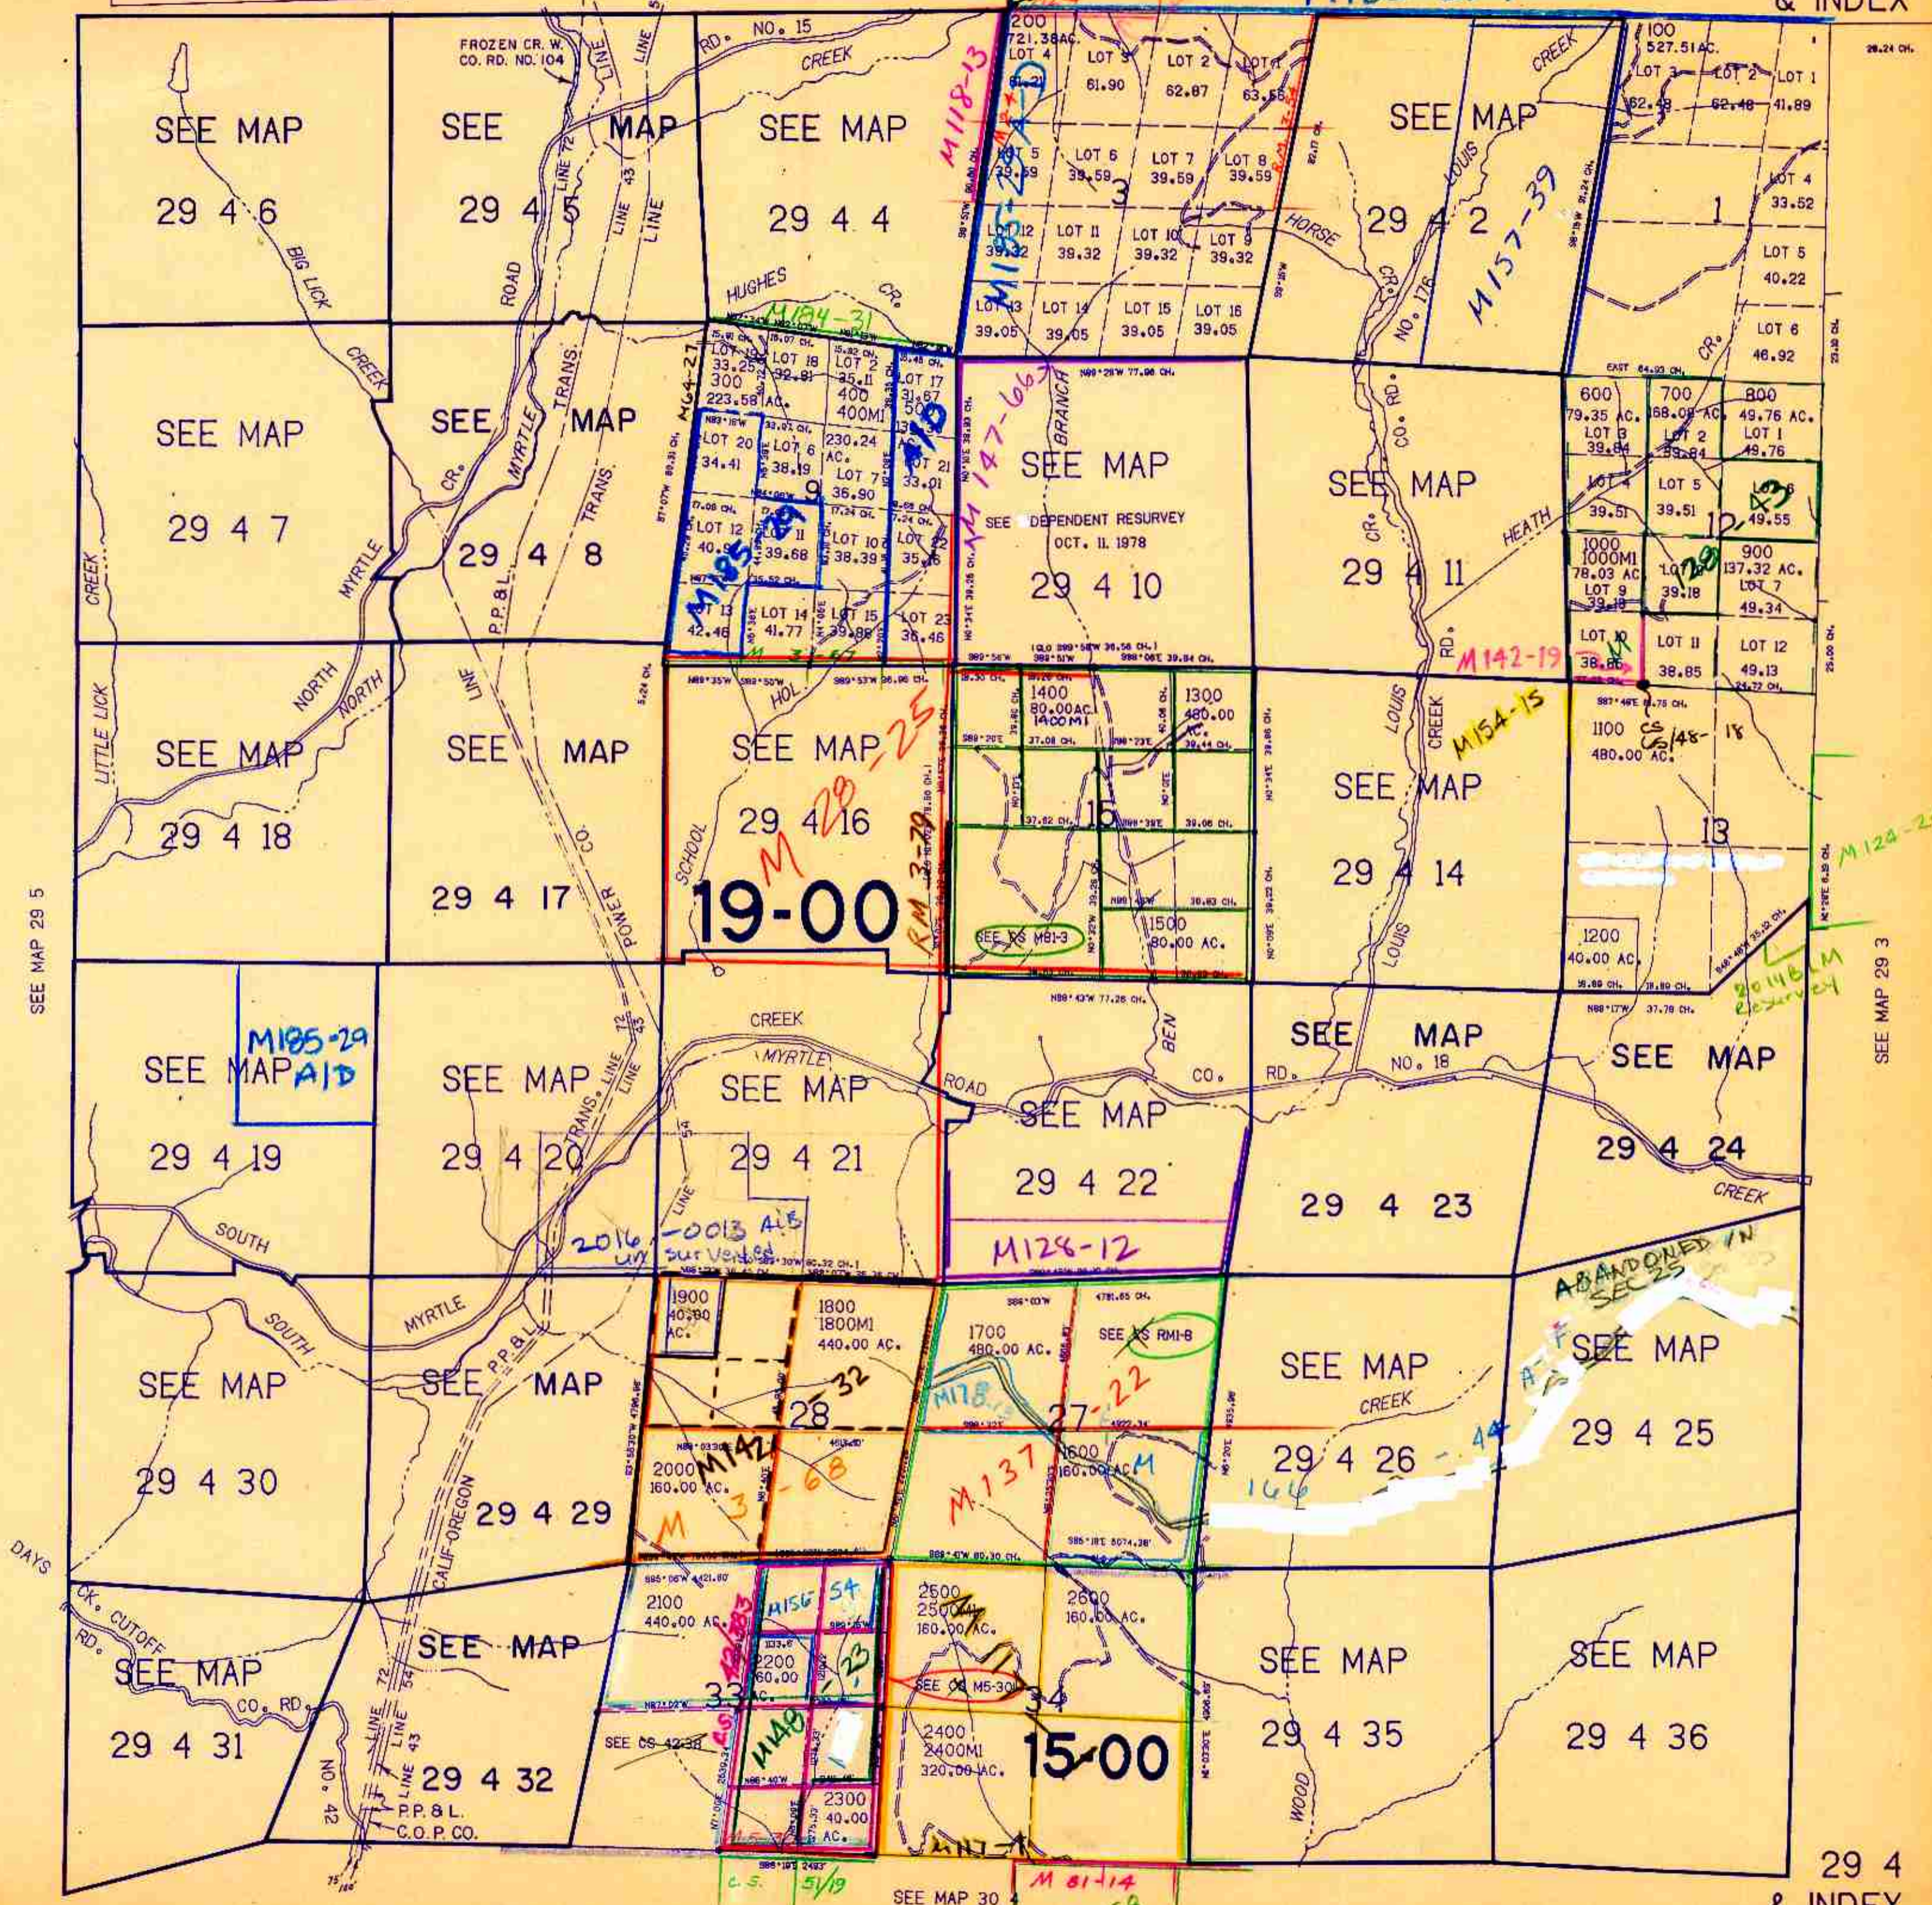

29 4
& INDEX

10/84 B8