THIS MAP WAS PREPARED FOR ASSESSMENT PURPOSE ONLY.

SECTION 16 T.29S. R.4W. W.M.
DOUGLAS COUNTY

1"=400'

REVISED ON 10-14-93

29 4 16

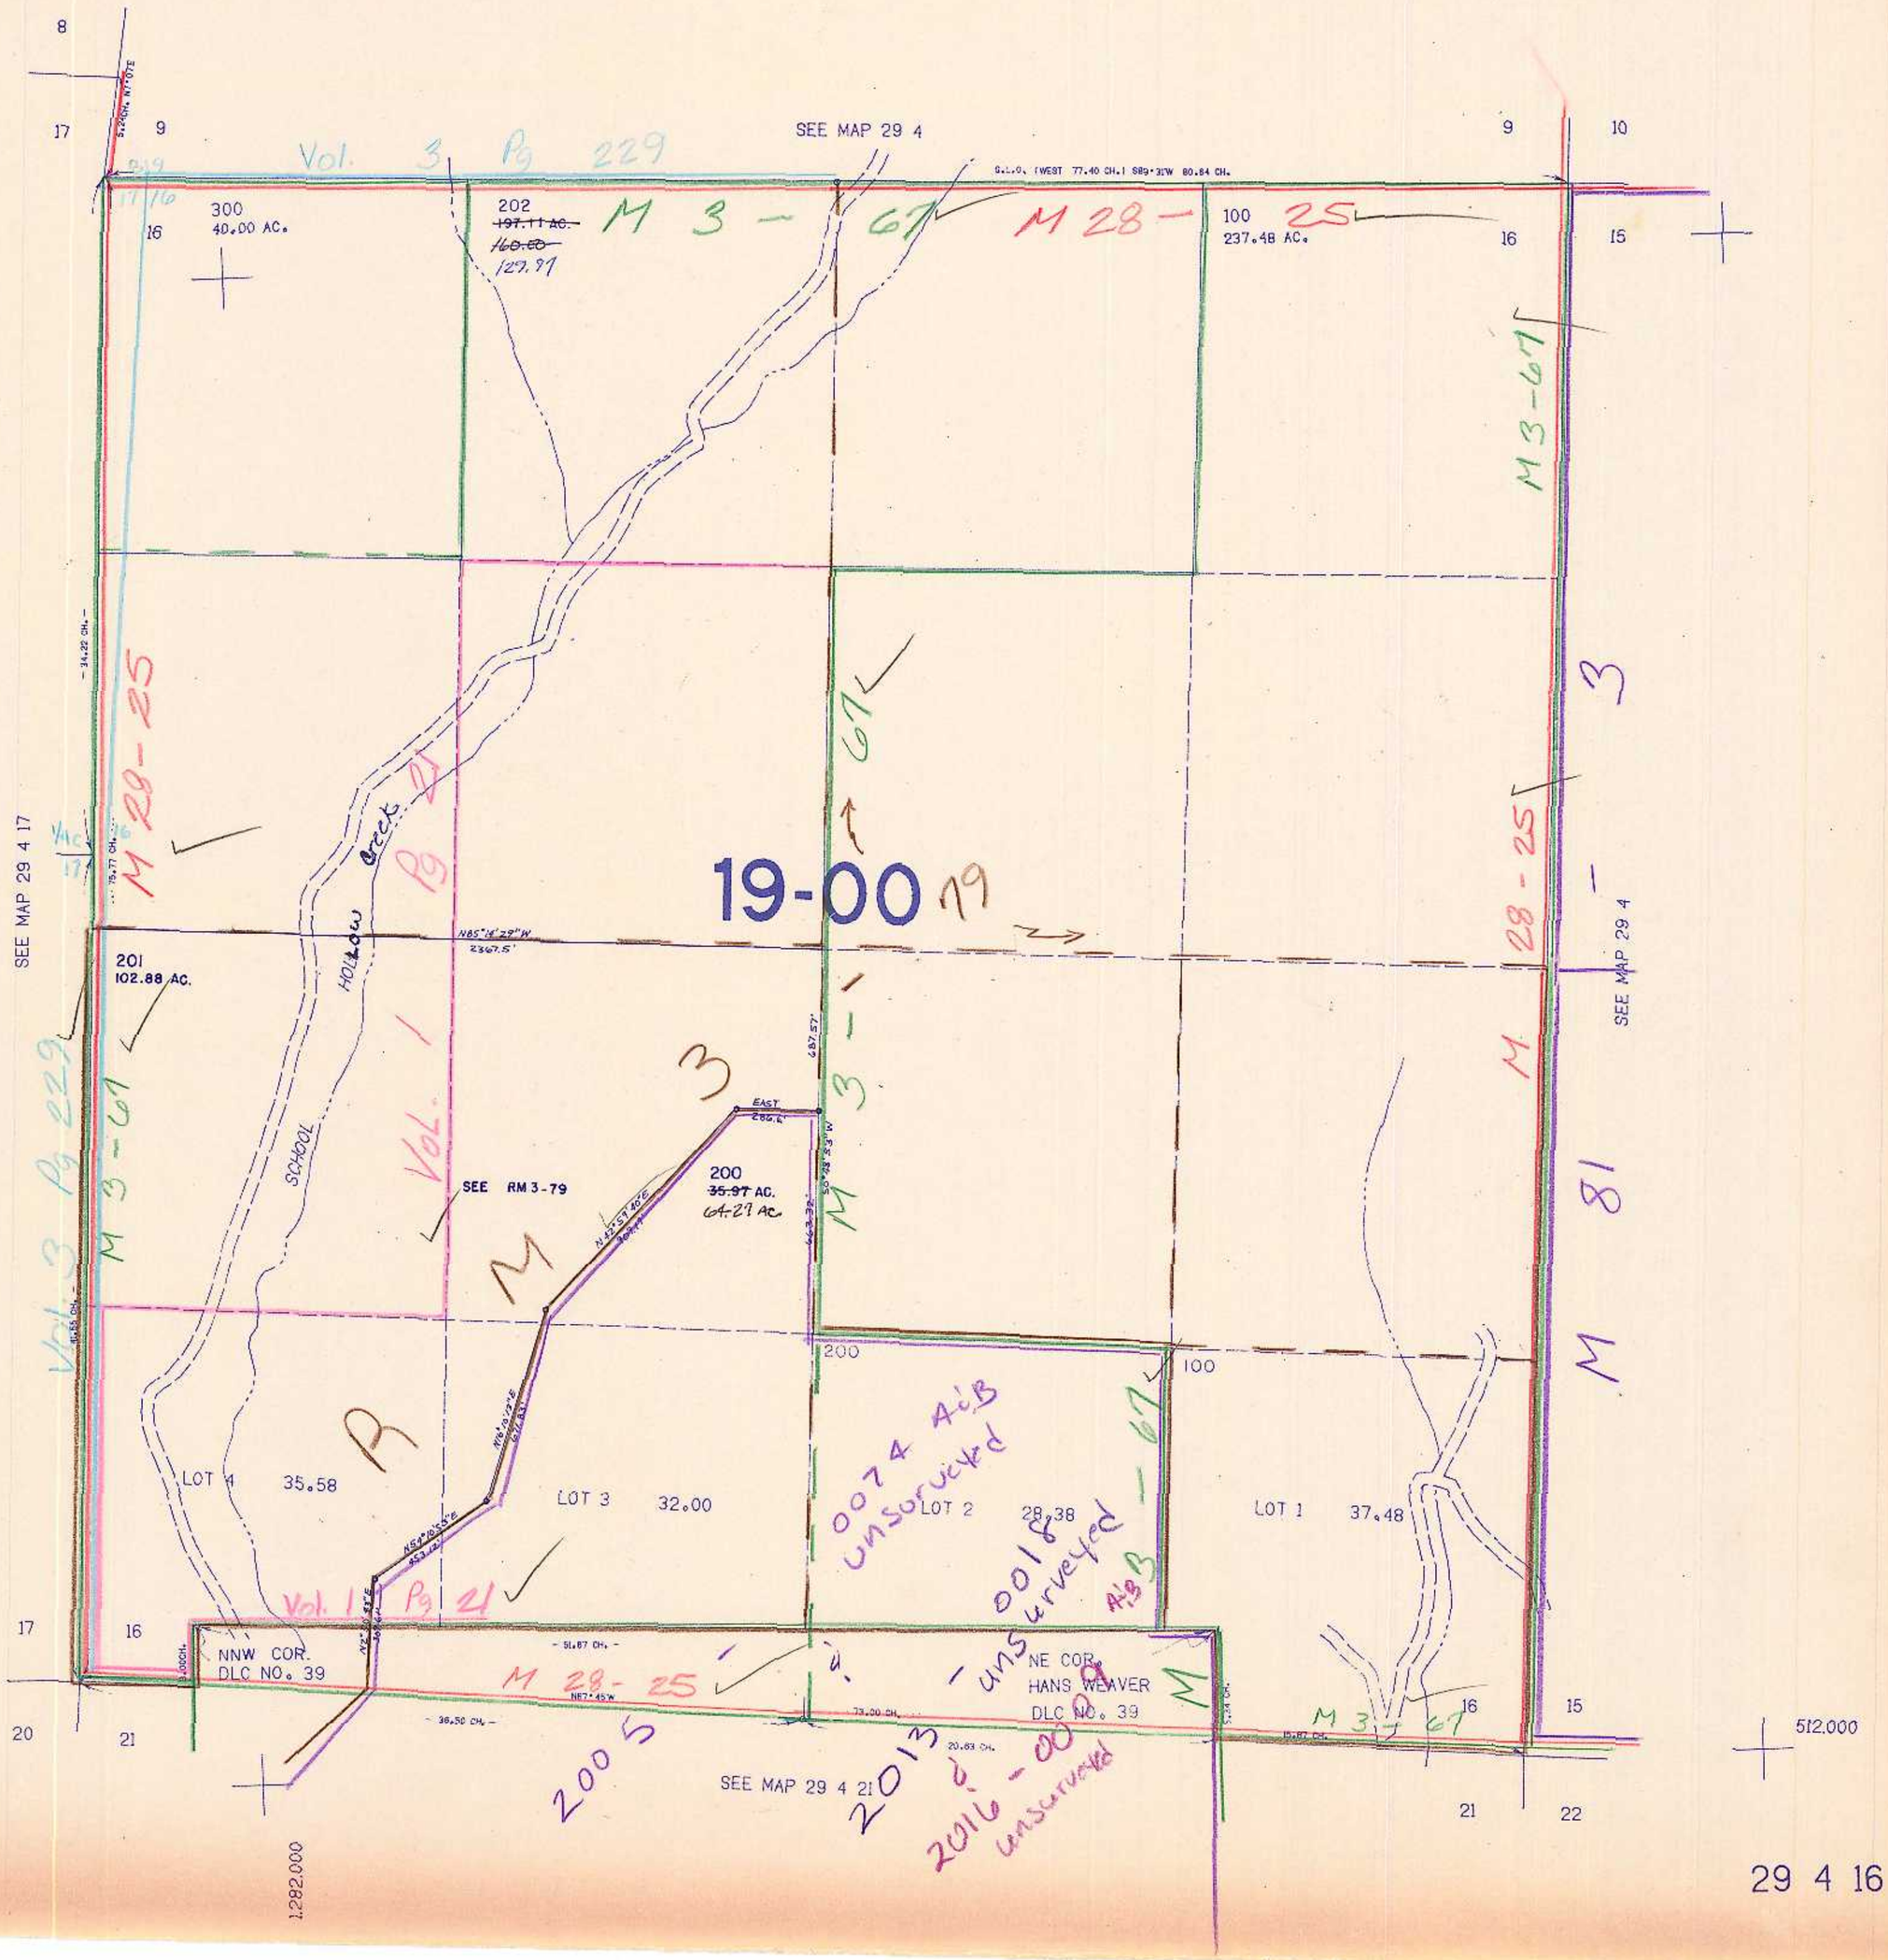

29 4 16