


SECTION 30 T.29S. R.4 W. W.M.
DOUGLAS COUNTY

29 4 30

THIS MAP WAS PREPARED FOR
ASSESSMENT PURPOSE ONLY.

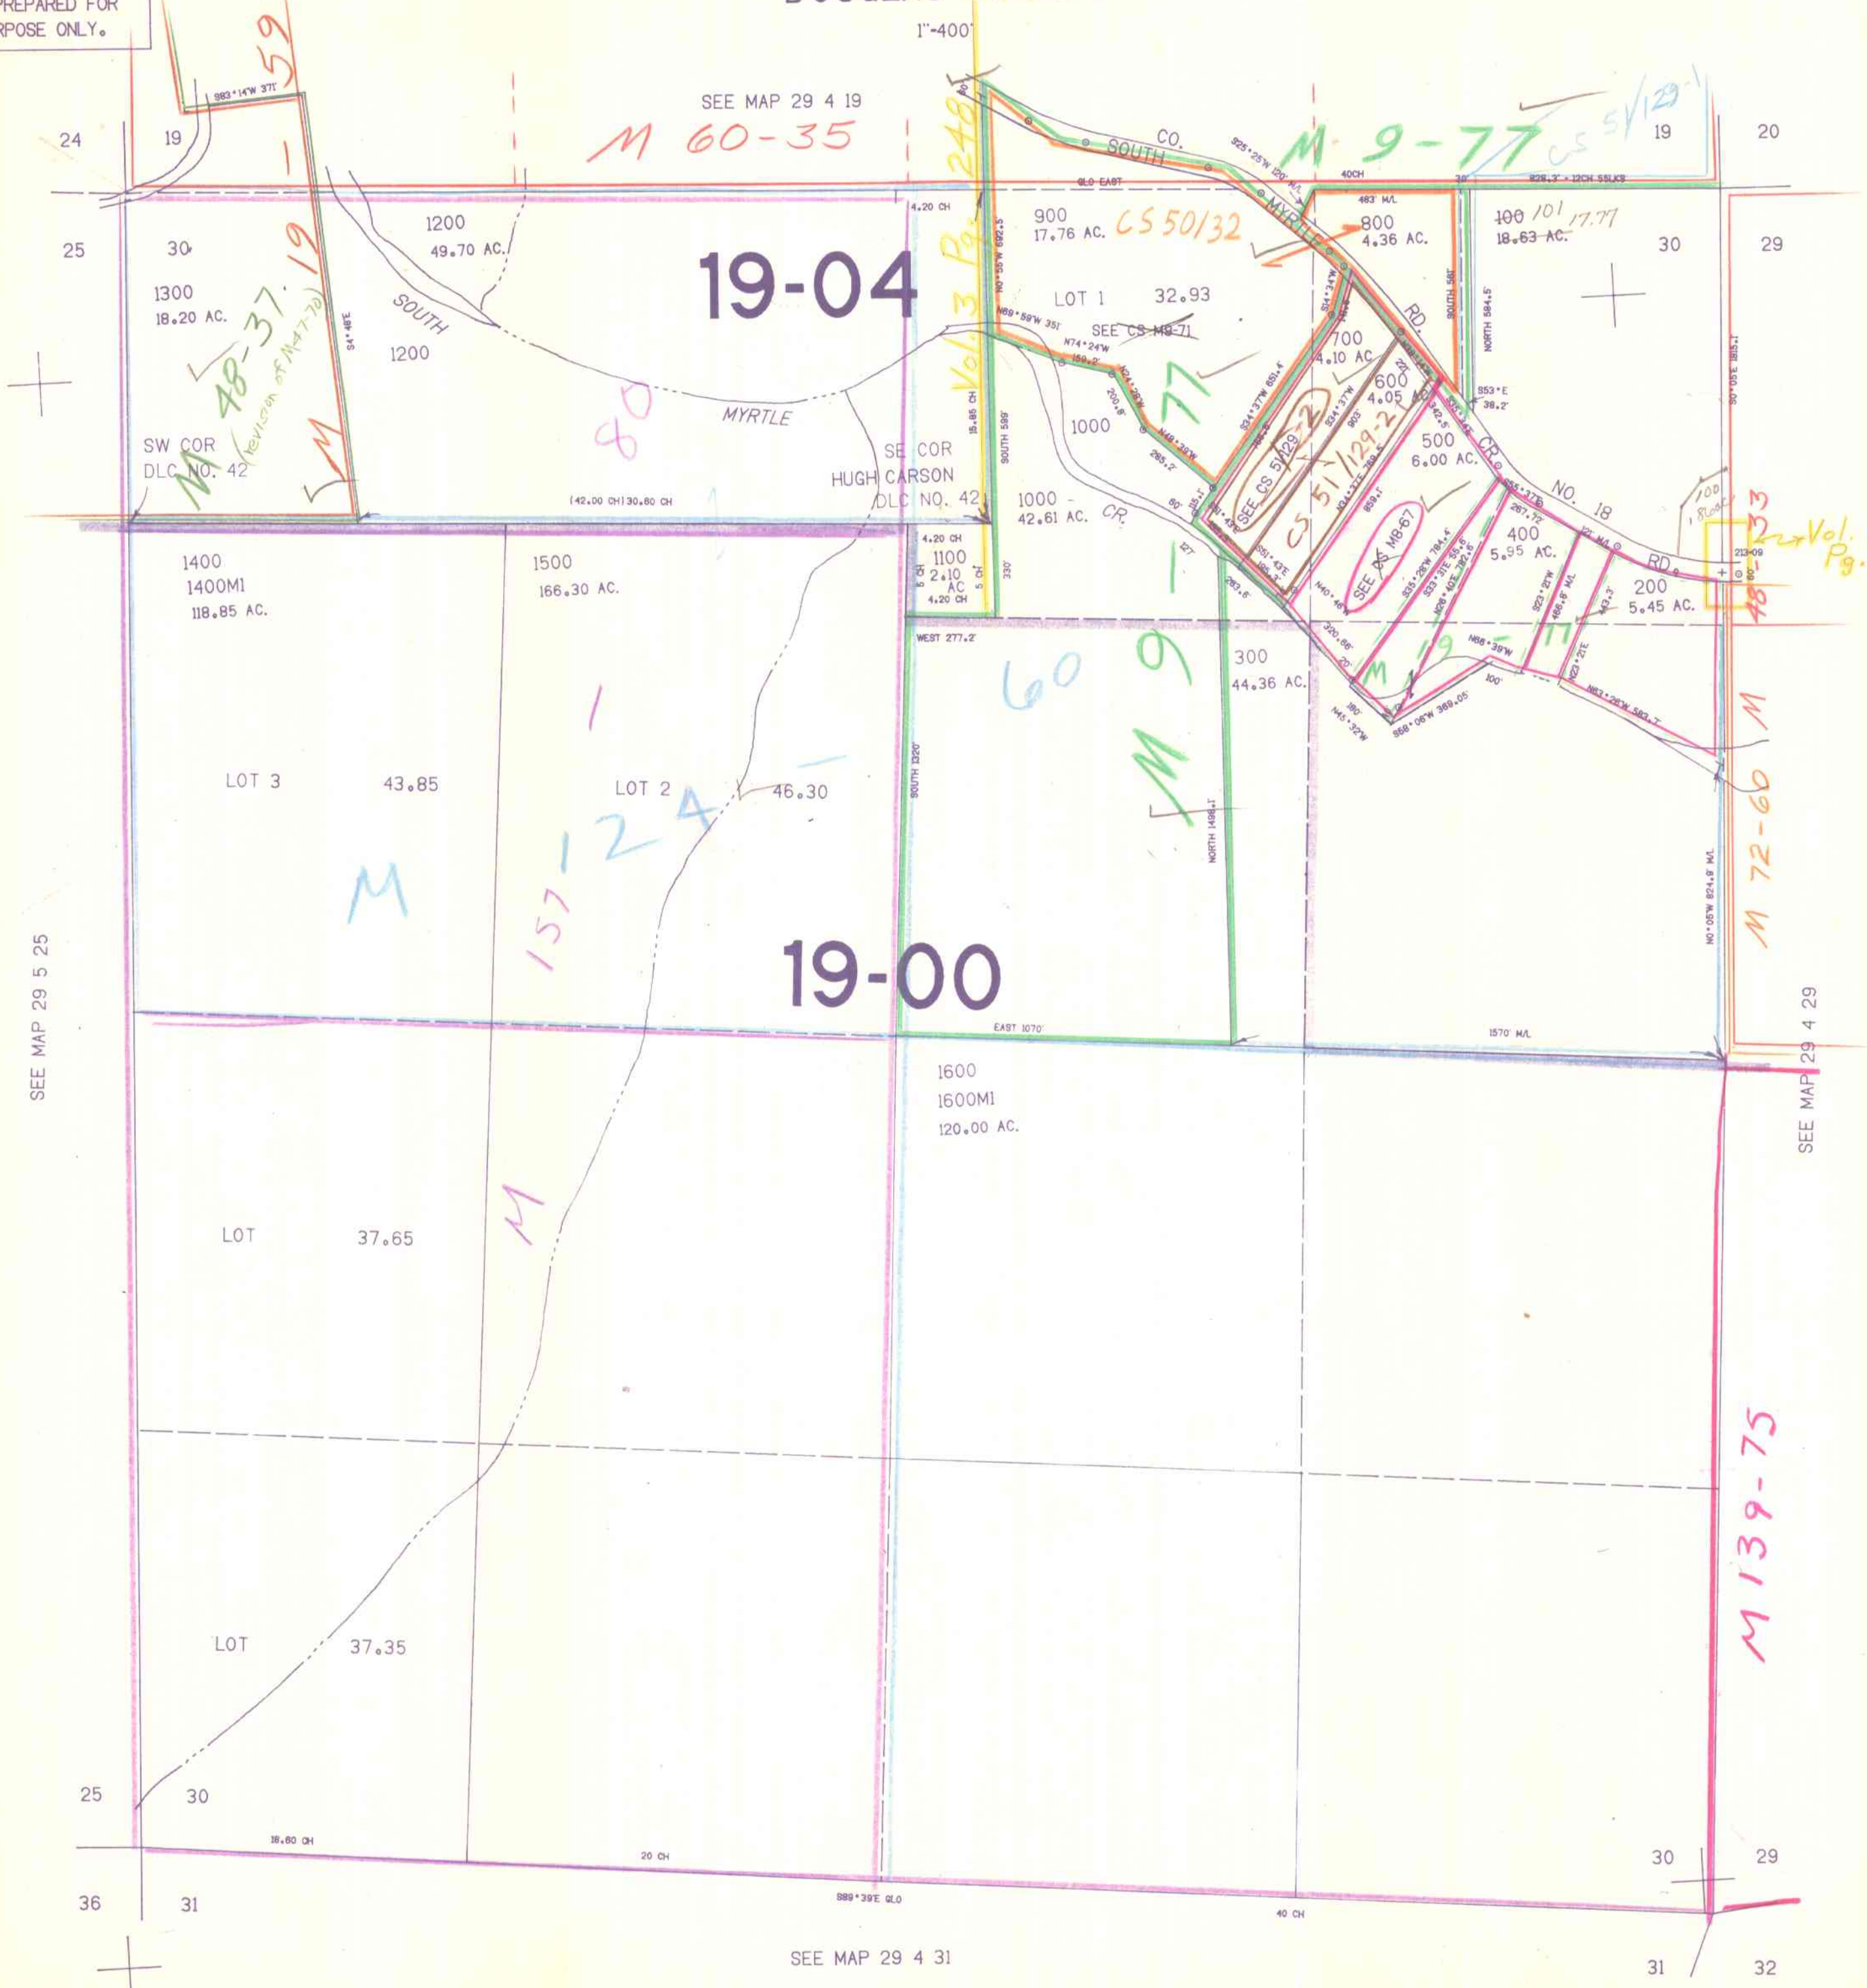

SEE MAP 29 5 25

SEE MAP 29 4 29

SEE MAP 29 4 31

1.276.000

502.000

29 4 30

10/84 BS

SEE MAP 29 4 19
M 60-35

M 9-77

M 48-37
M 19

Vol 3 Pg. 248

Vol. 1
Pg. 166

M 72-60

M 139-75

M

M 157-24

M 60-9

19-04

19-00