


T.29S. R.51/2E. W.M.
DOUGLAS COUNTY

29 5V

THIS MAP WAS PREPARED FOR
ASSESSMENT PURPOSE ONLY.

1"=2000'

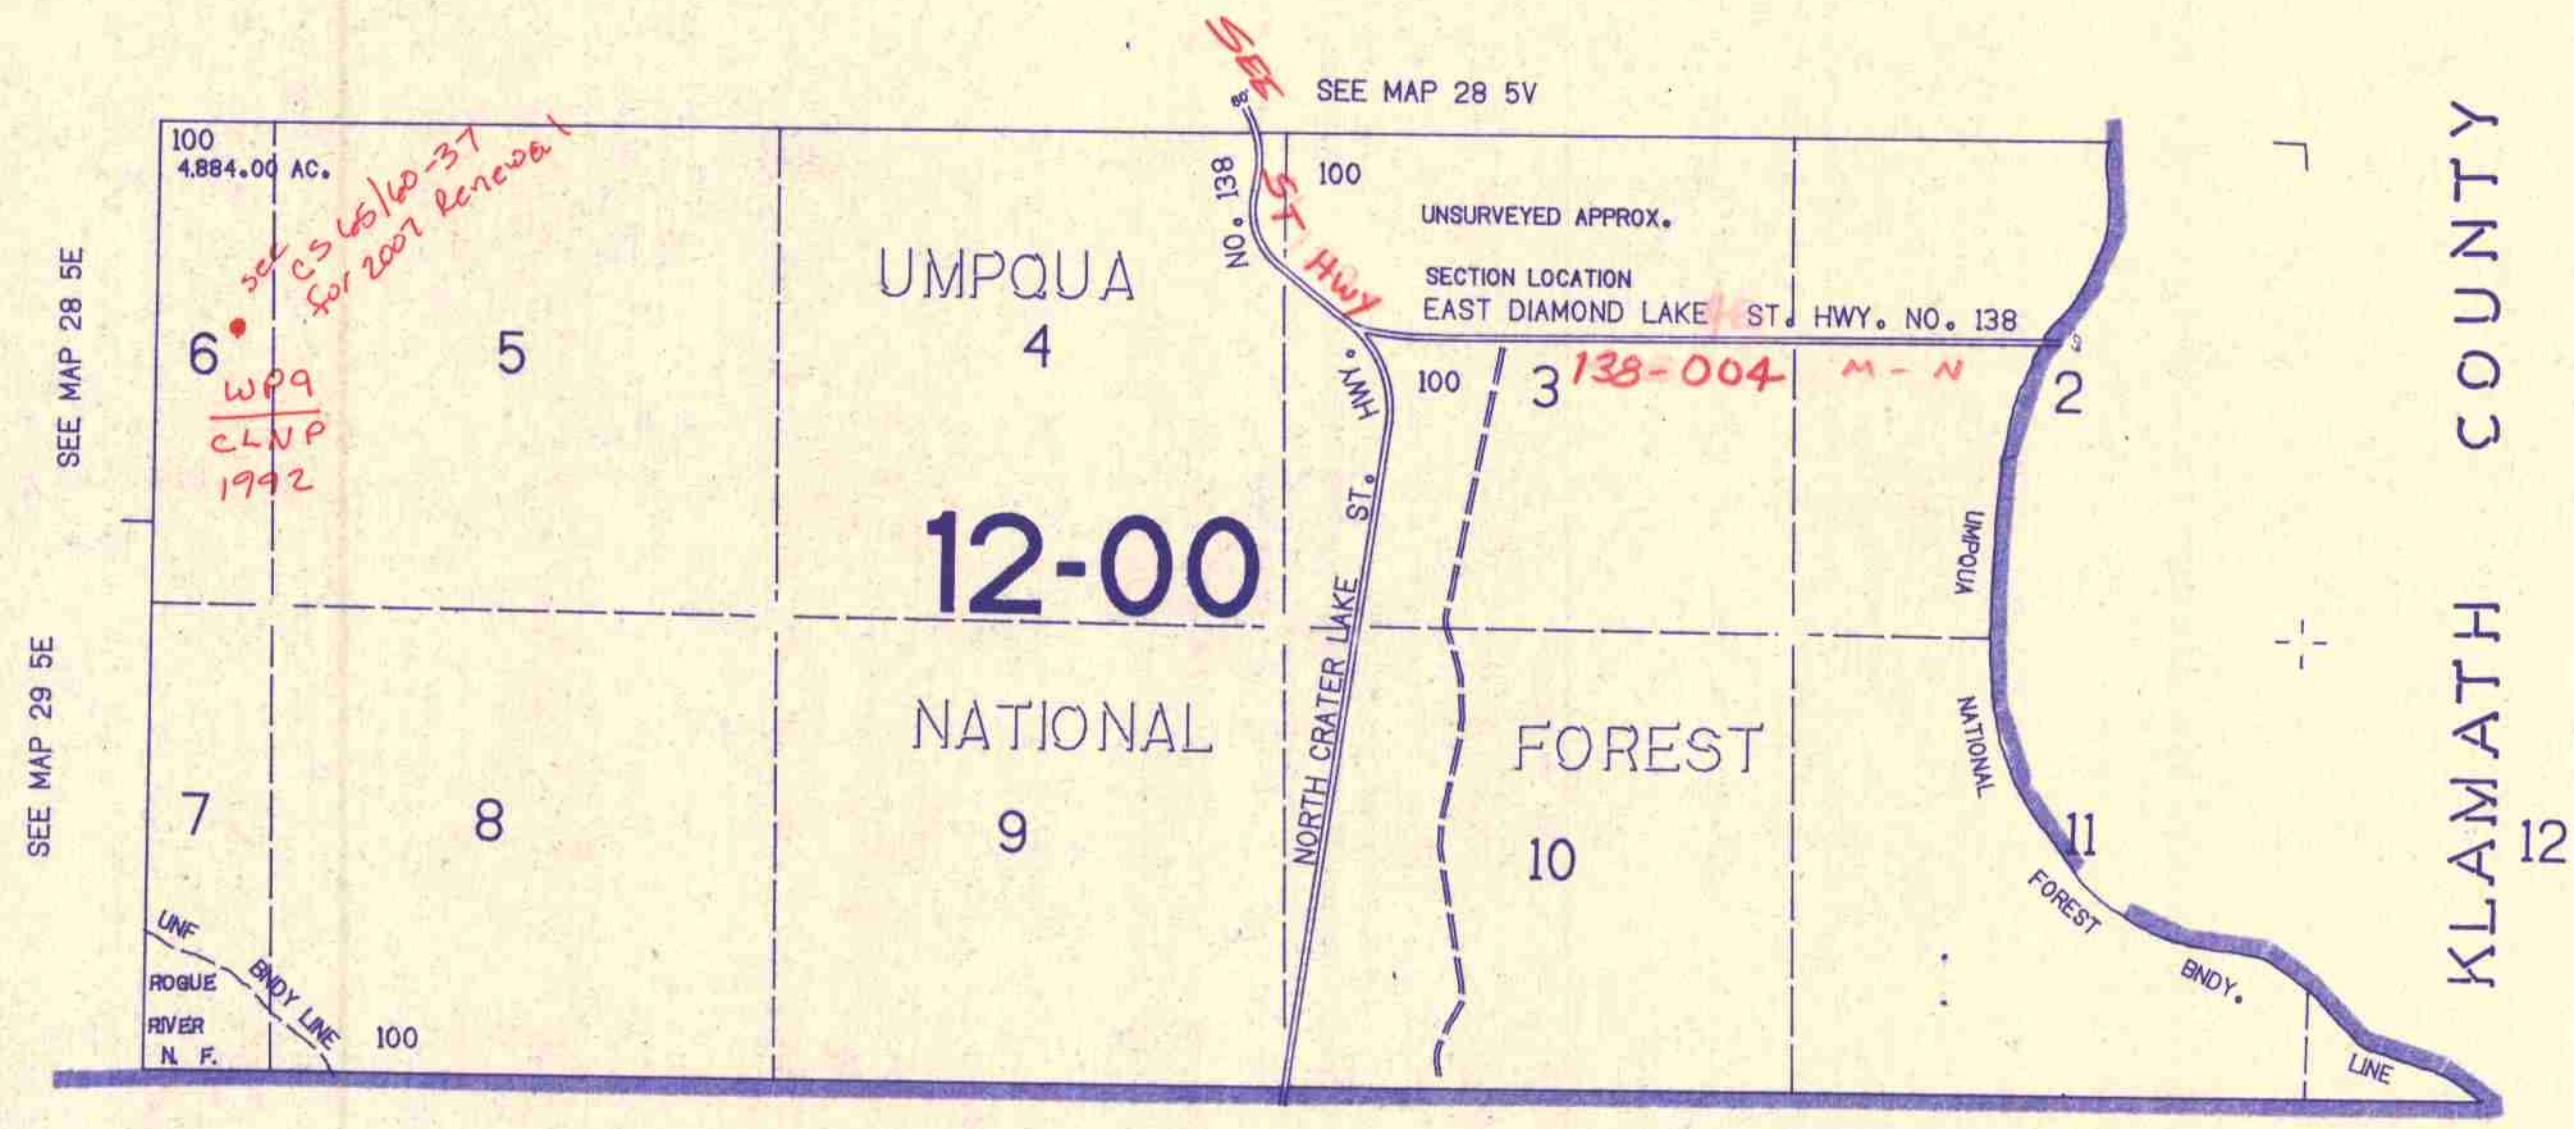

KLAMATH

COUNTY

29 5V