


SECTION 2 T.29S. R.5W. WM.
DOUGLAS COUNTY

This map was prepared for
assessment purpose only

1" = 400'

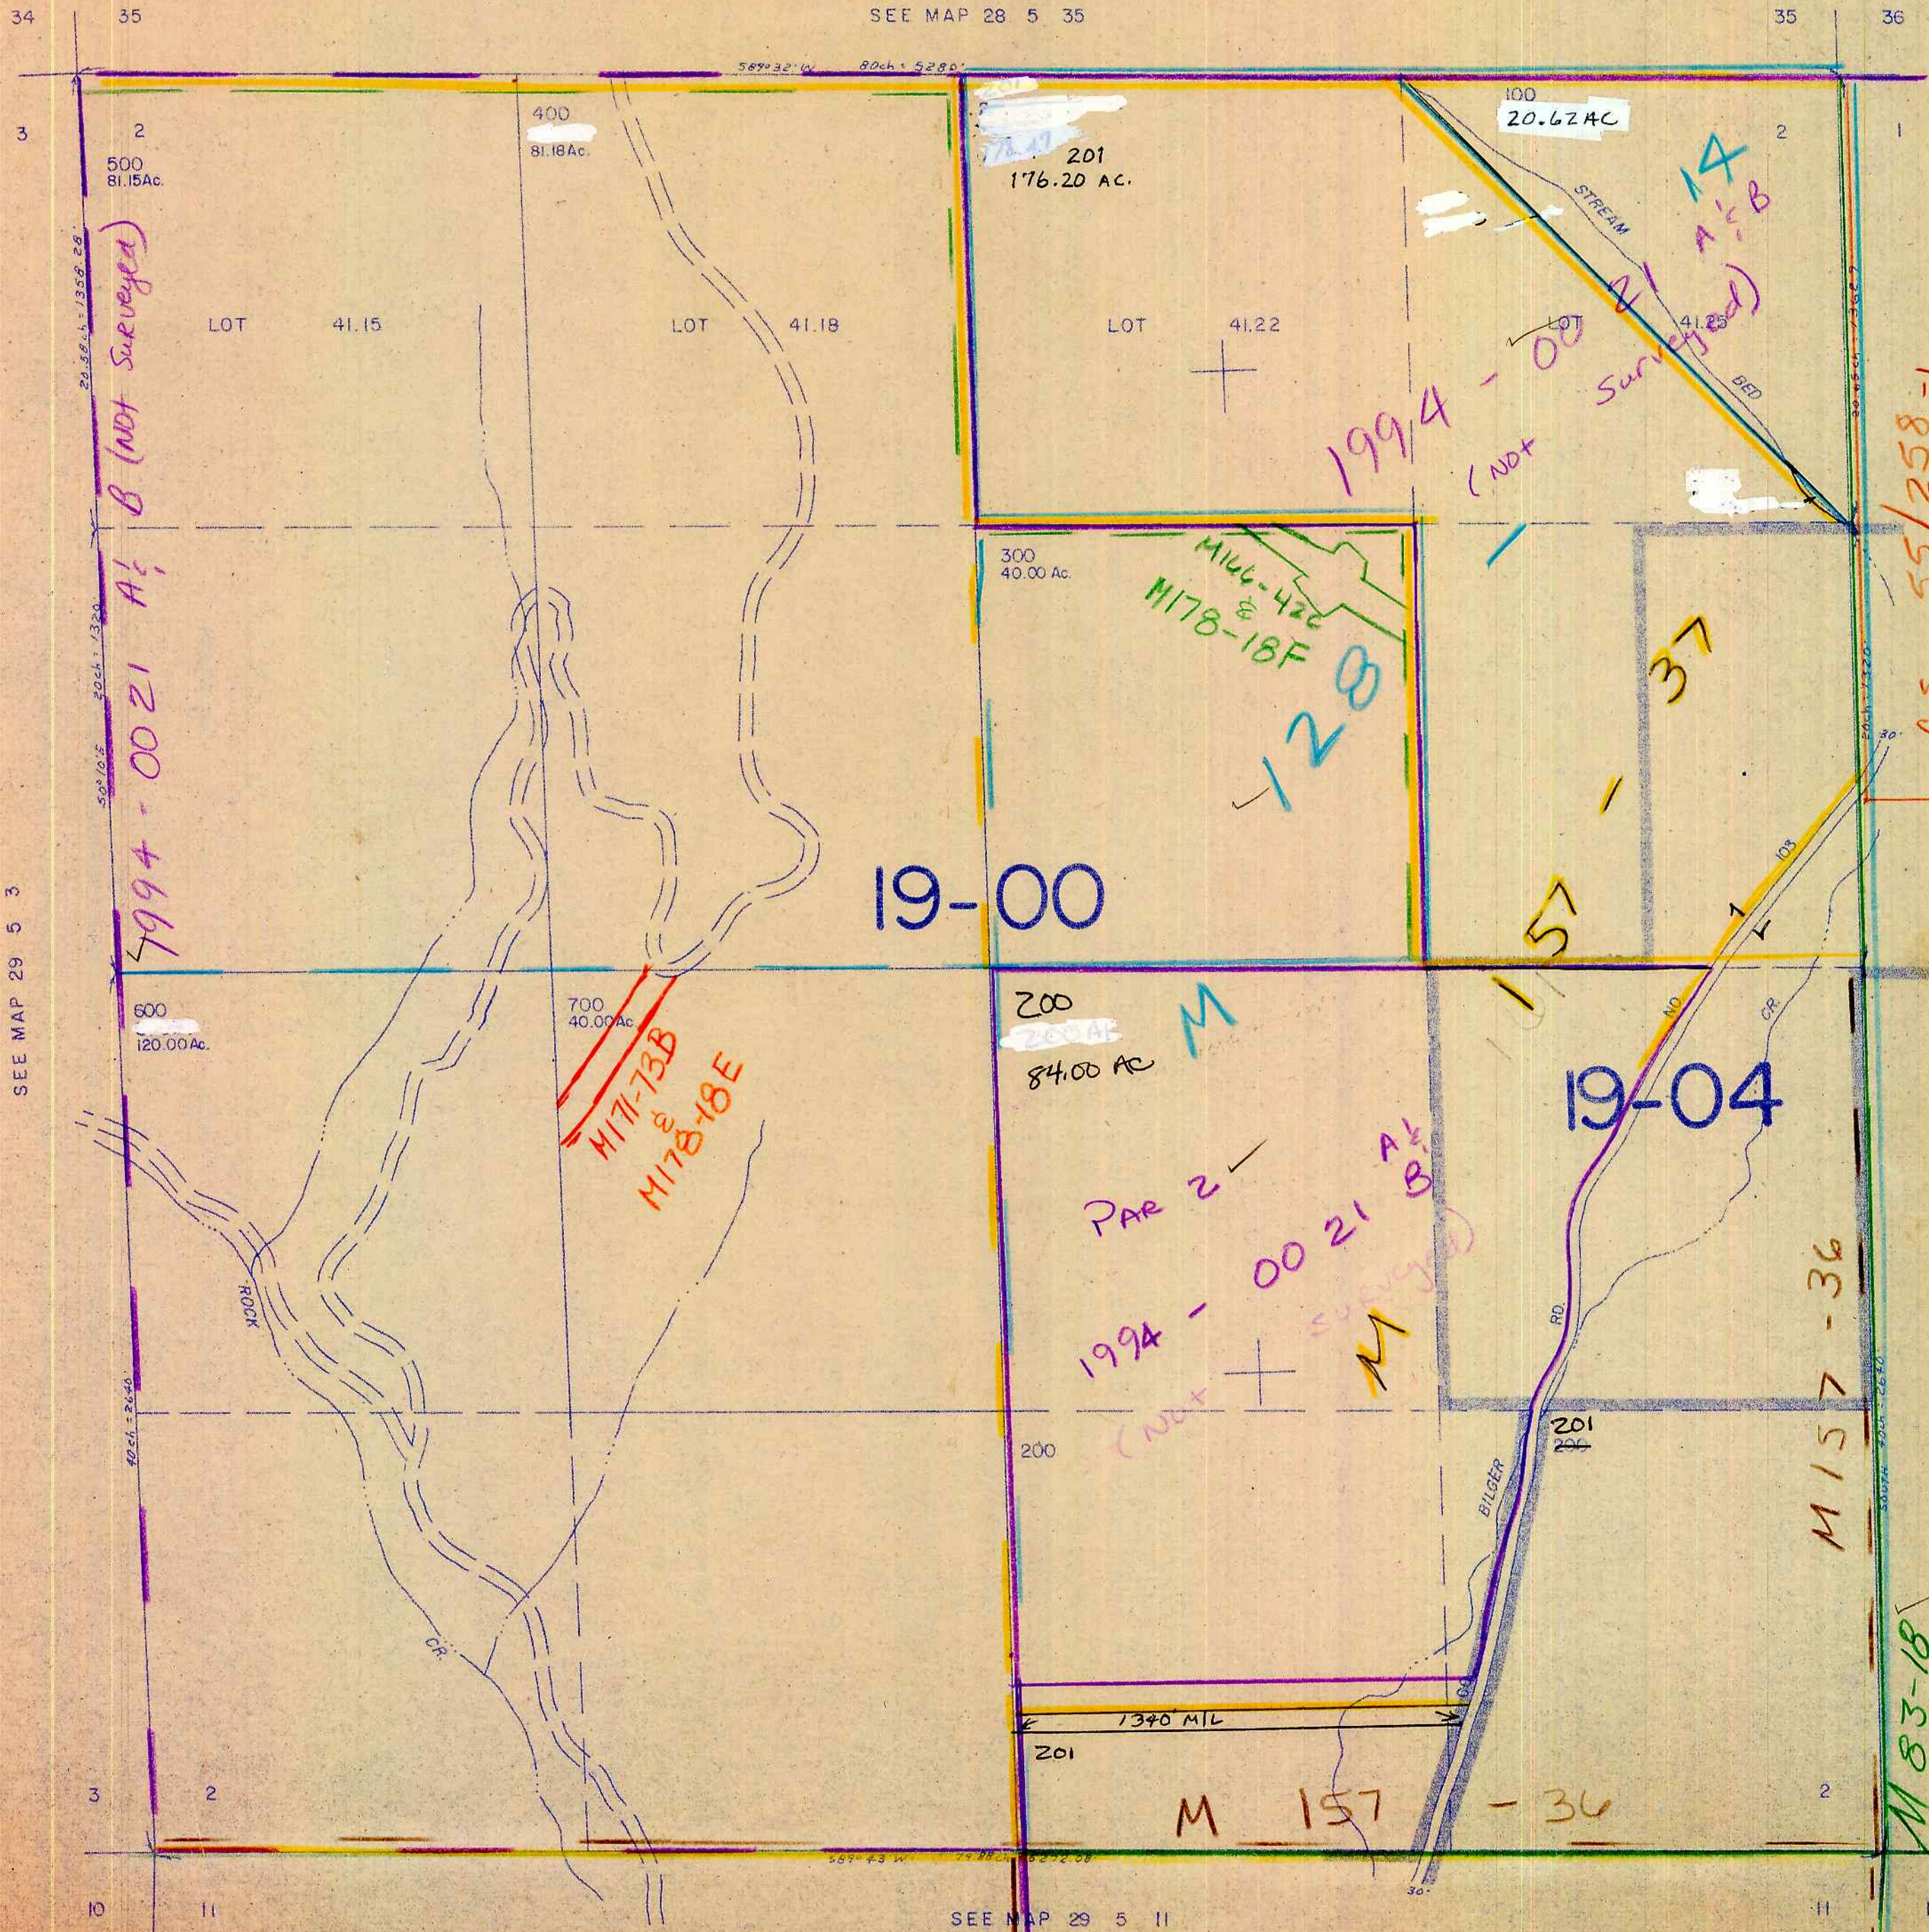

CANCELLED NOS
400 MI 600 MI 202
101 200 A1

C.S. 55/258-1

SEE MAP 29 5 1

525,000