THIS MAP WAS PREPARED FOR ASSESSMENT PURPOSE ONLY.

SEC.13 T29S. R.5W. W.M.
DOUGLAS COUNTY

1" = 400'

29 5 13 & INDEX

REVISED ON 6-14-07

CANCELLED NO'S

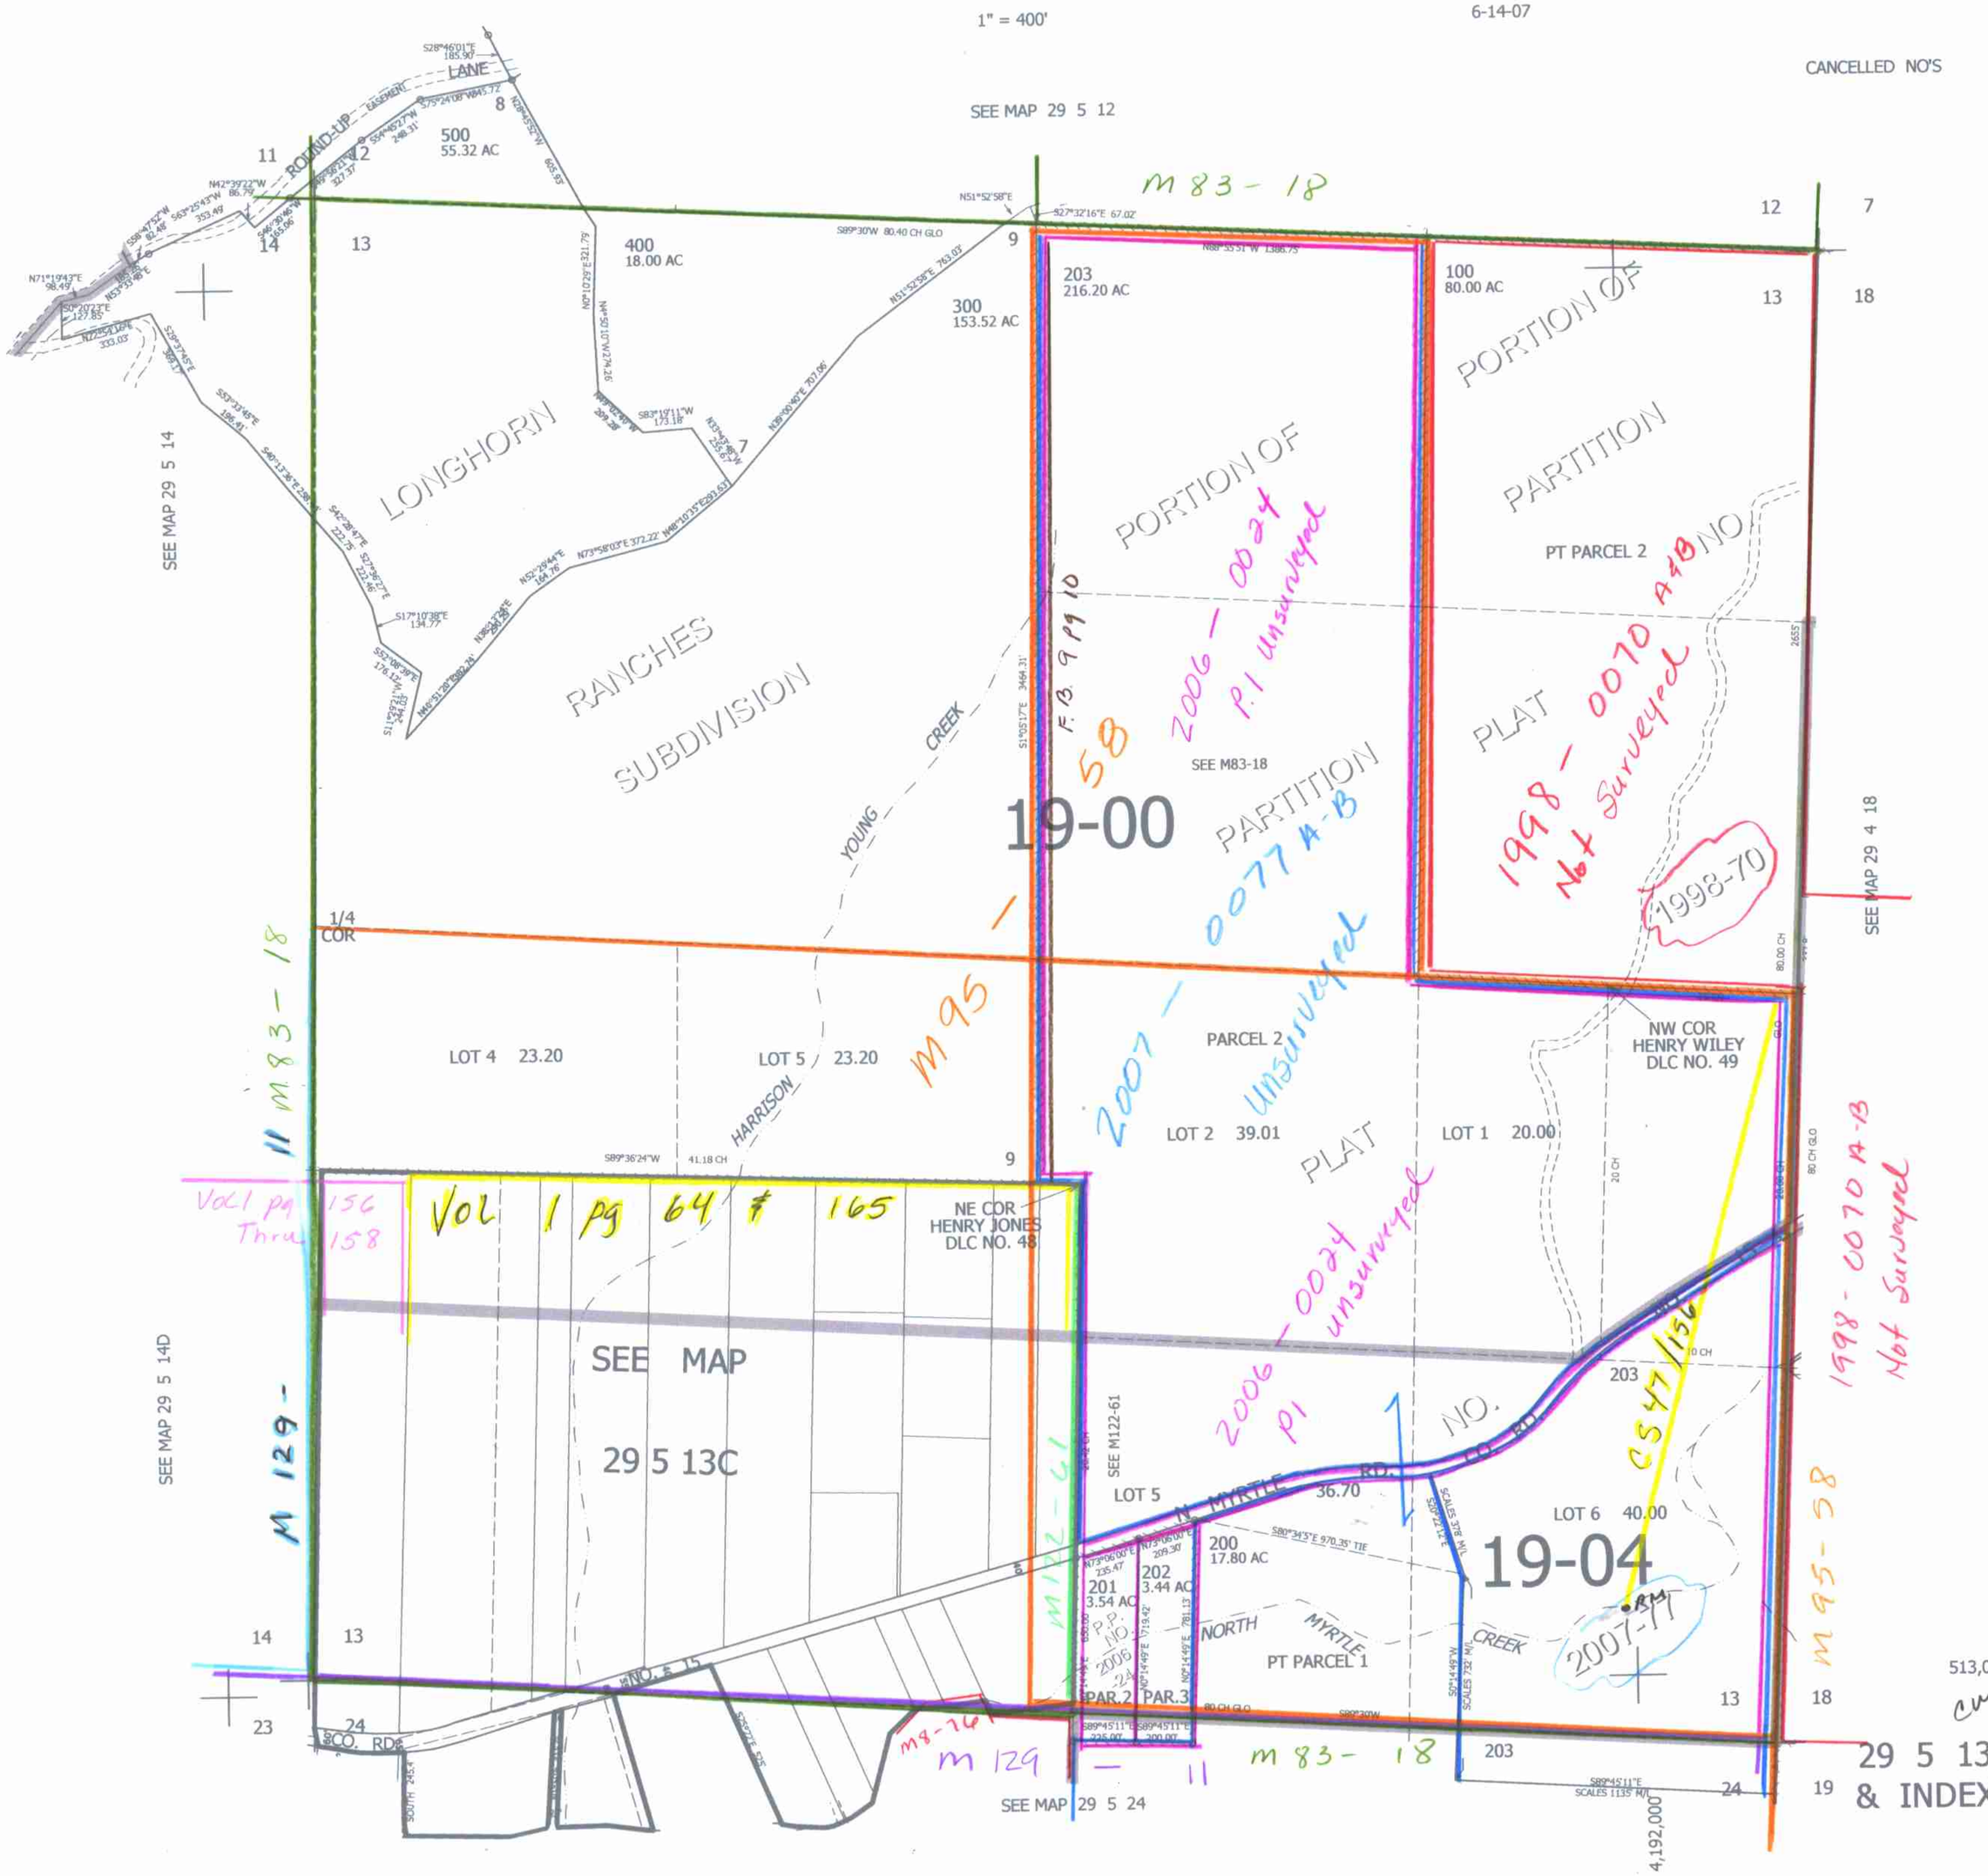

29 5 13 & INDEX