

THIS MAP WAS PREPARED FOR ASSESSMENT PURPOSE ONLY.

SEC.20 T29S. R.5W. W.M.
DOUGLAS COUNTY
1" = 400'

REVISED ON
6-17-20

29 5 20

SEE MAP 29 5 17


CANCELLED NO'S
300M1

SEE MAP 29 5 19

SEE MAP 29 5 21

SEE MAP 29 5 19D

509,000

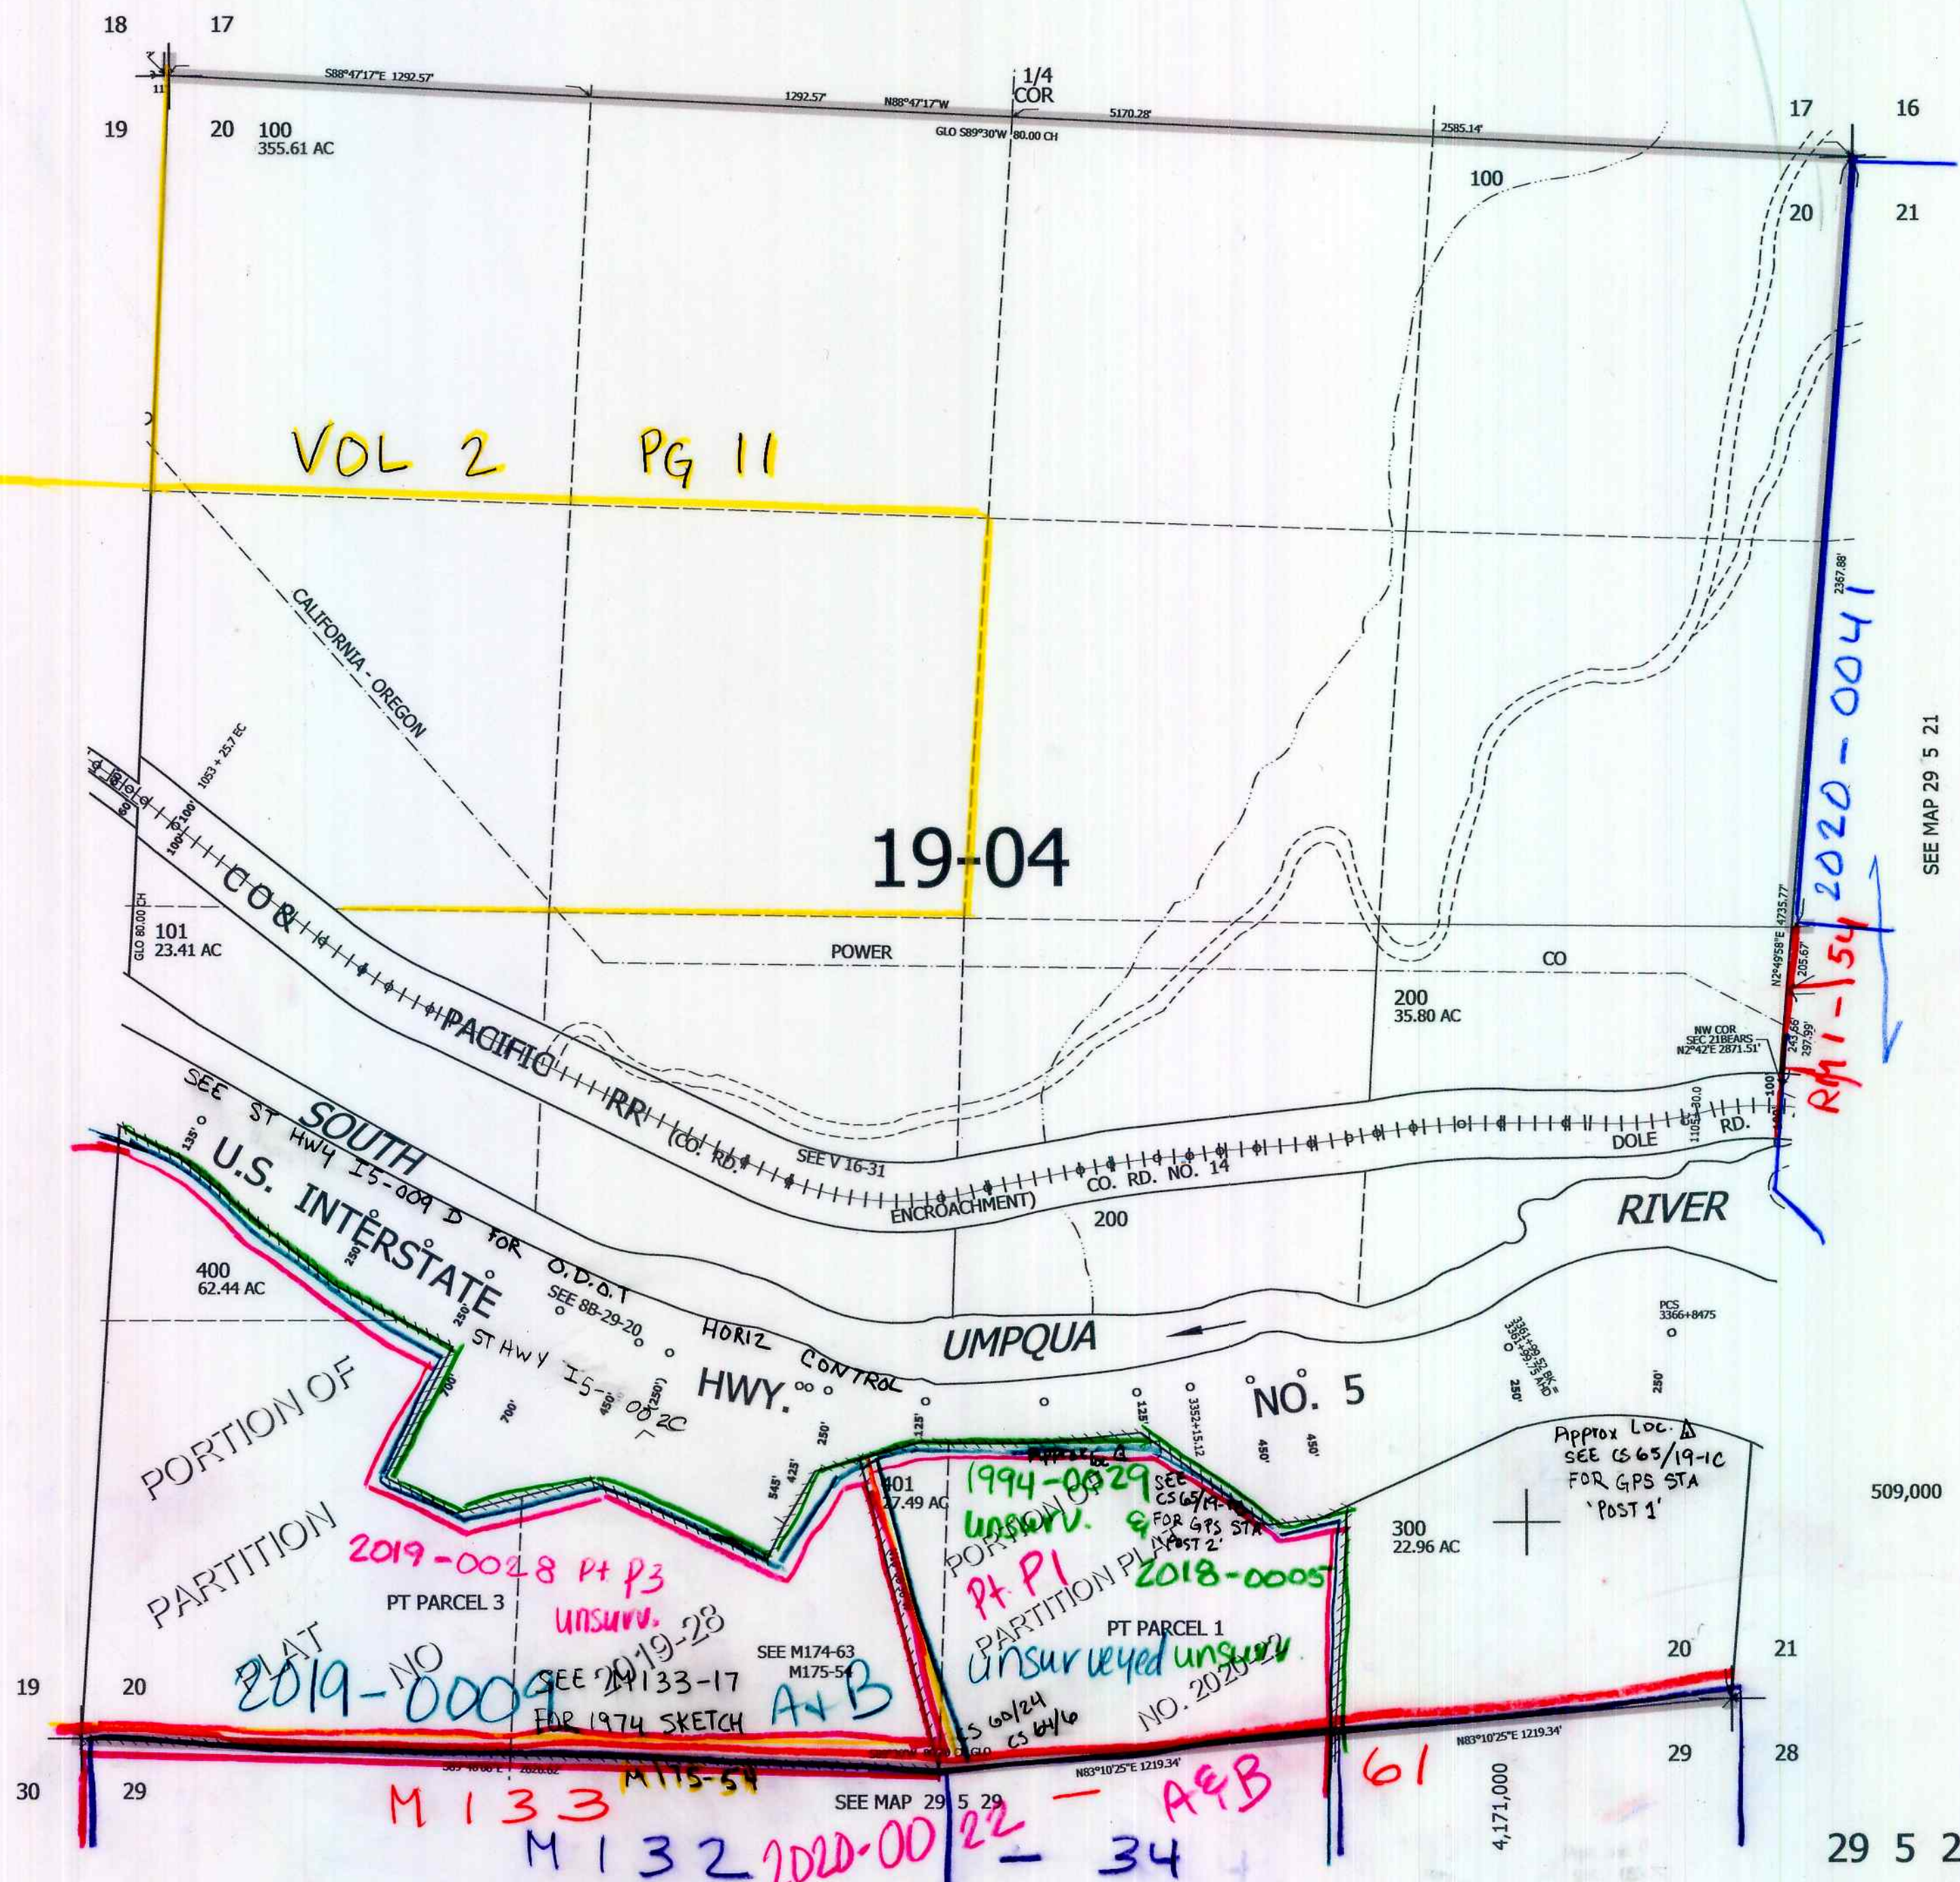

29 5 20

4/24/10
scv 8