


NW1/4 SE1/4 SEC.22 T.29S. R.5W. W.M.
DOUGLAS COUNTY

29 5 22DB
MYRTLE CREEK

THIS MAP WAS PREPARED FOR
ASSESSMENT PURPOSE ONLY.

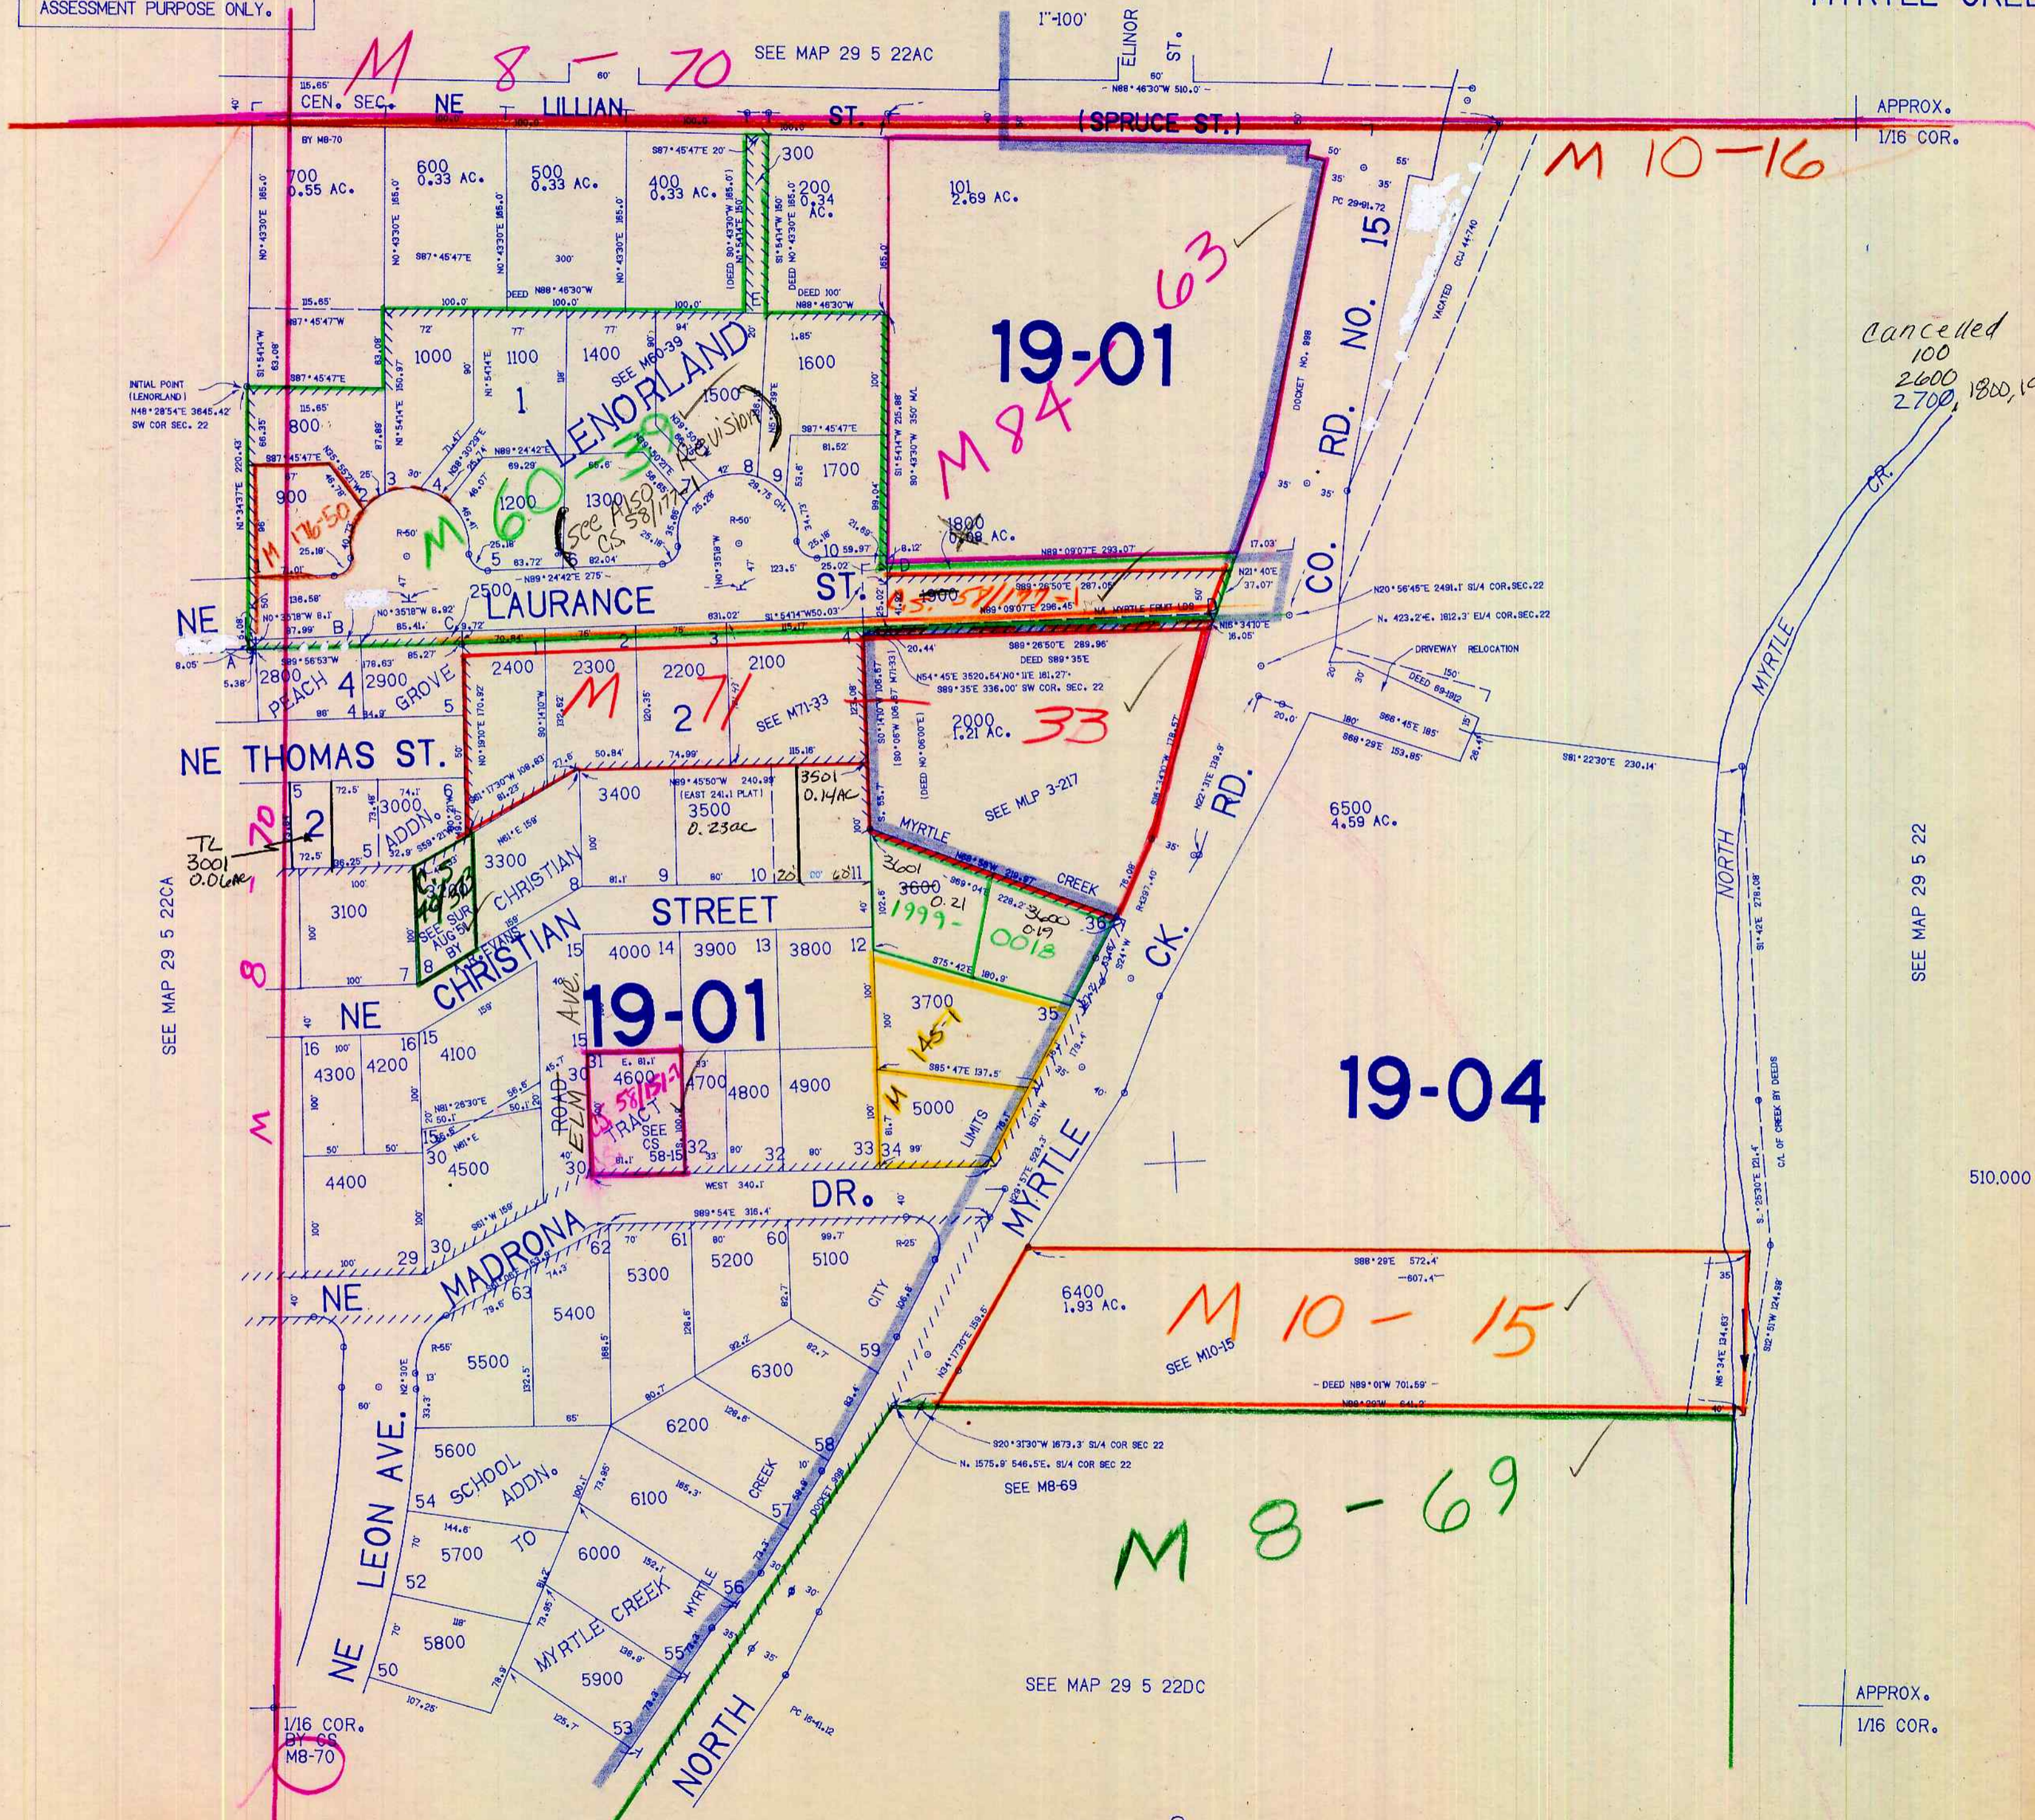

APPROX.
1/16 COR.

SEE MAP 29 5 22

510.000

APPROX.
1/16 COR.

29 5 22DB
MYRTLE CREEK

1.259,000

3/89
Su.