THIS MAP WAS PREPARED FOR ASSESSMENT PURPOSE ONLY.

SE1/4 SEC. 23 T.29S. R.5W. W.M.
DOUGLAS COUNTY

1"=200'
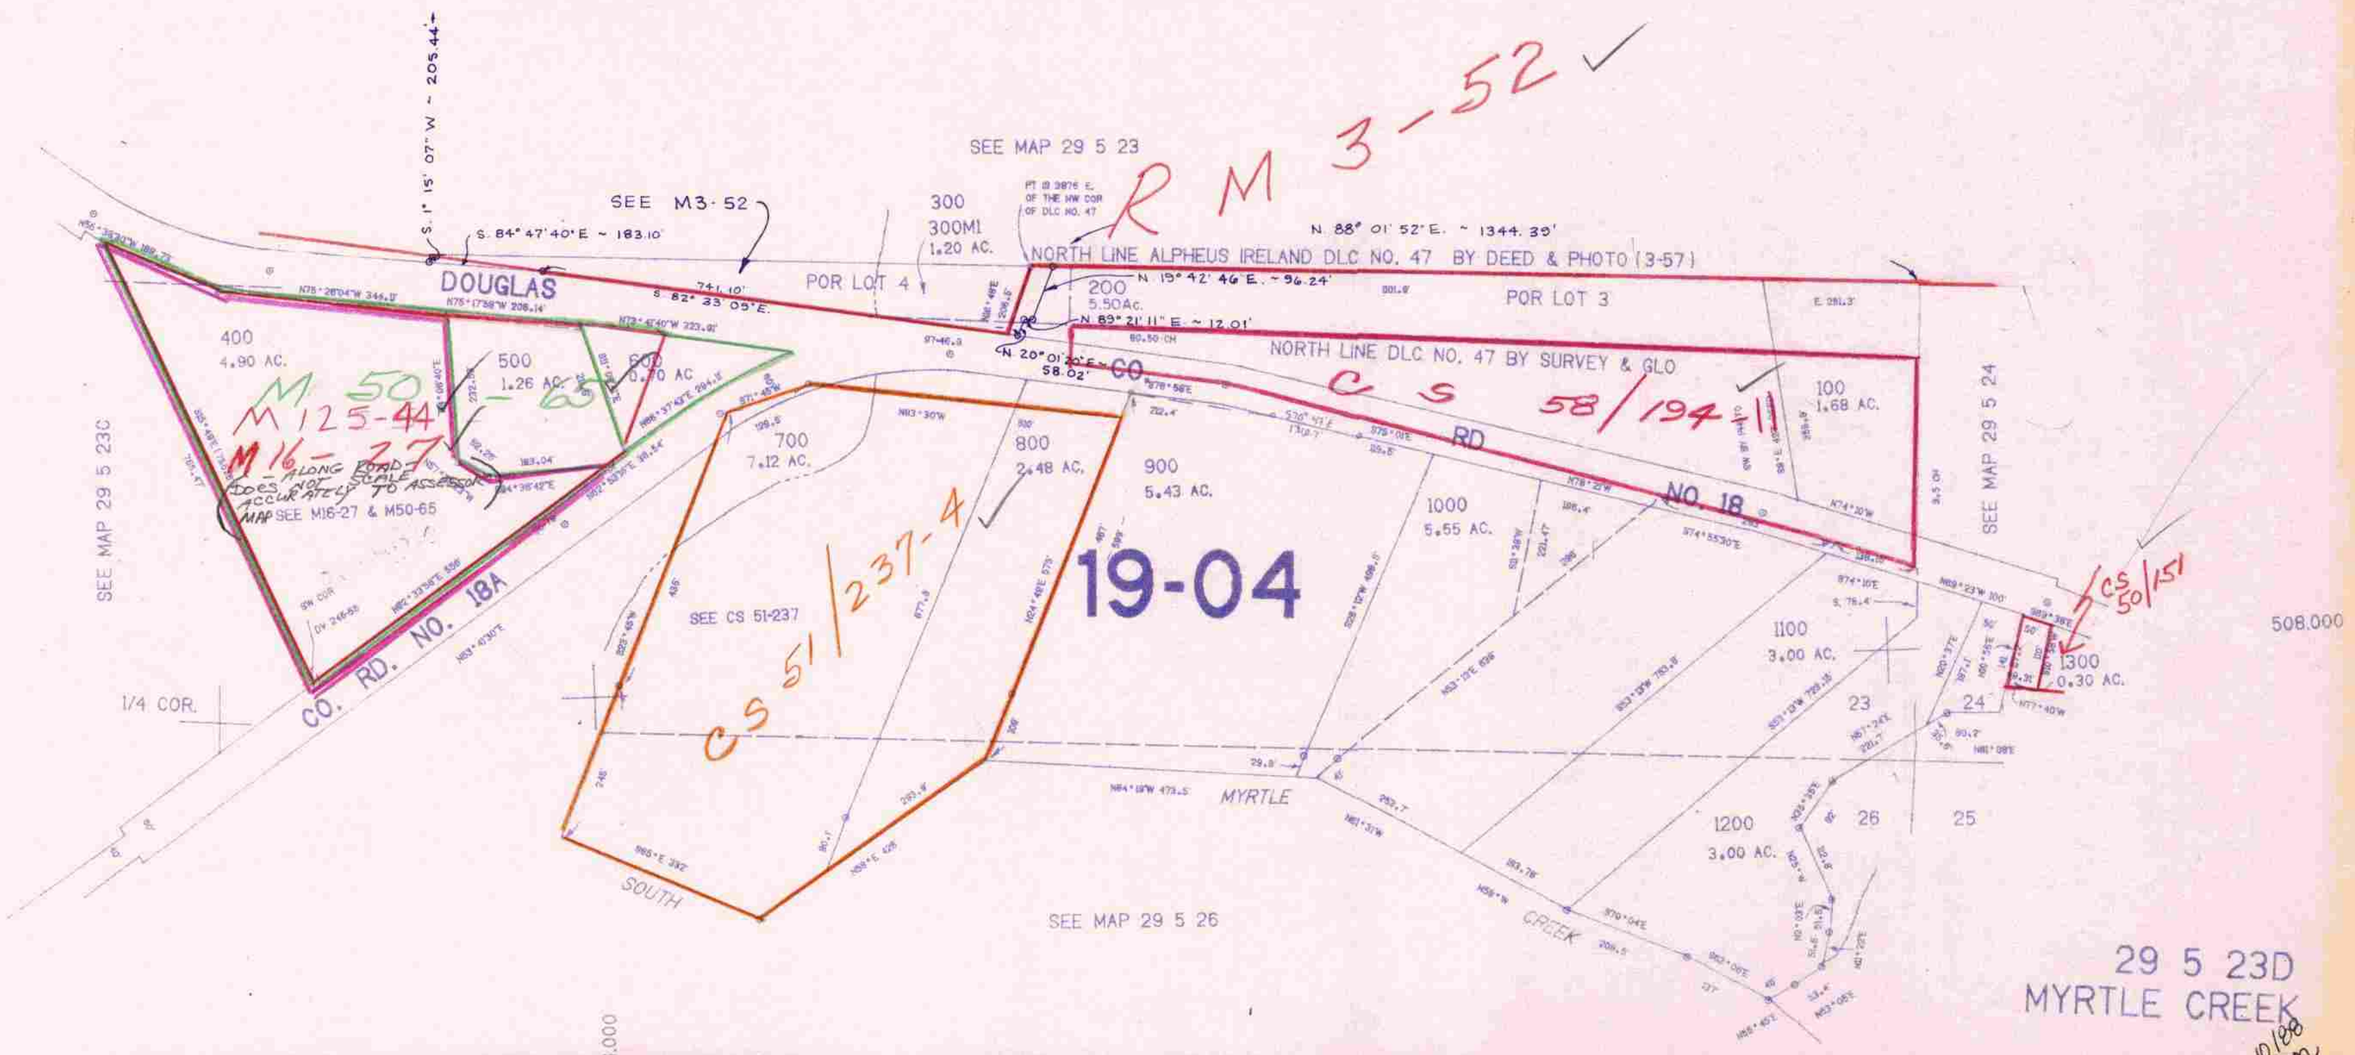
29 5 23D
MYRTLE CREEK