THIS MAP WAS PREPARED FOR ASSESSMENT PURPOSE ONLY.

SW1/4 NW1/4 SEC.27 T29S. R.5W. W.M.
DOUGLAS COUNTY

1" = 100'

REVISED ON 6-1-11

29 5 27BC
MYRTLE CREEK

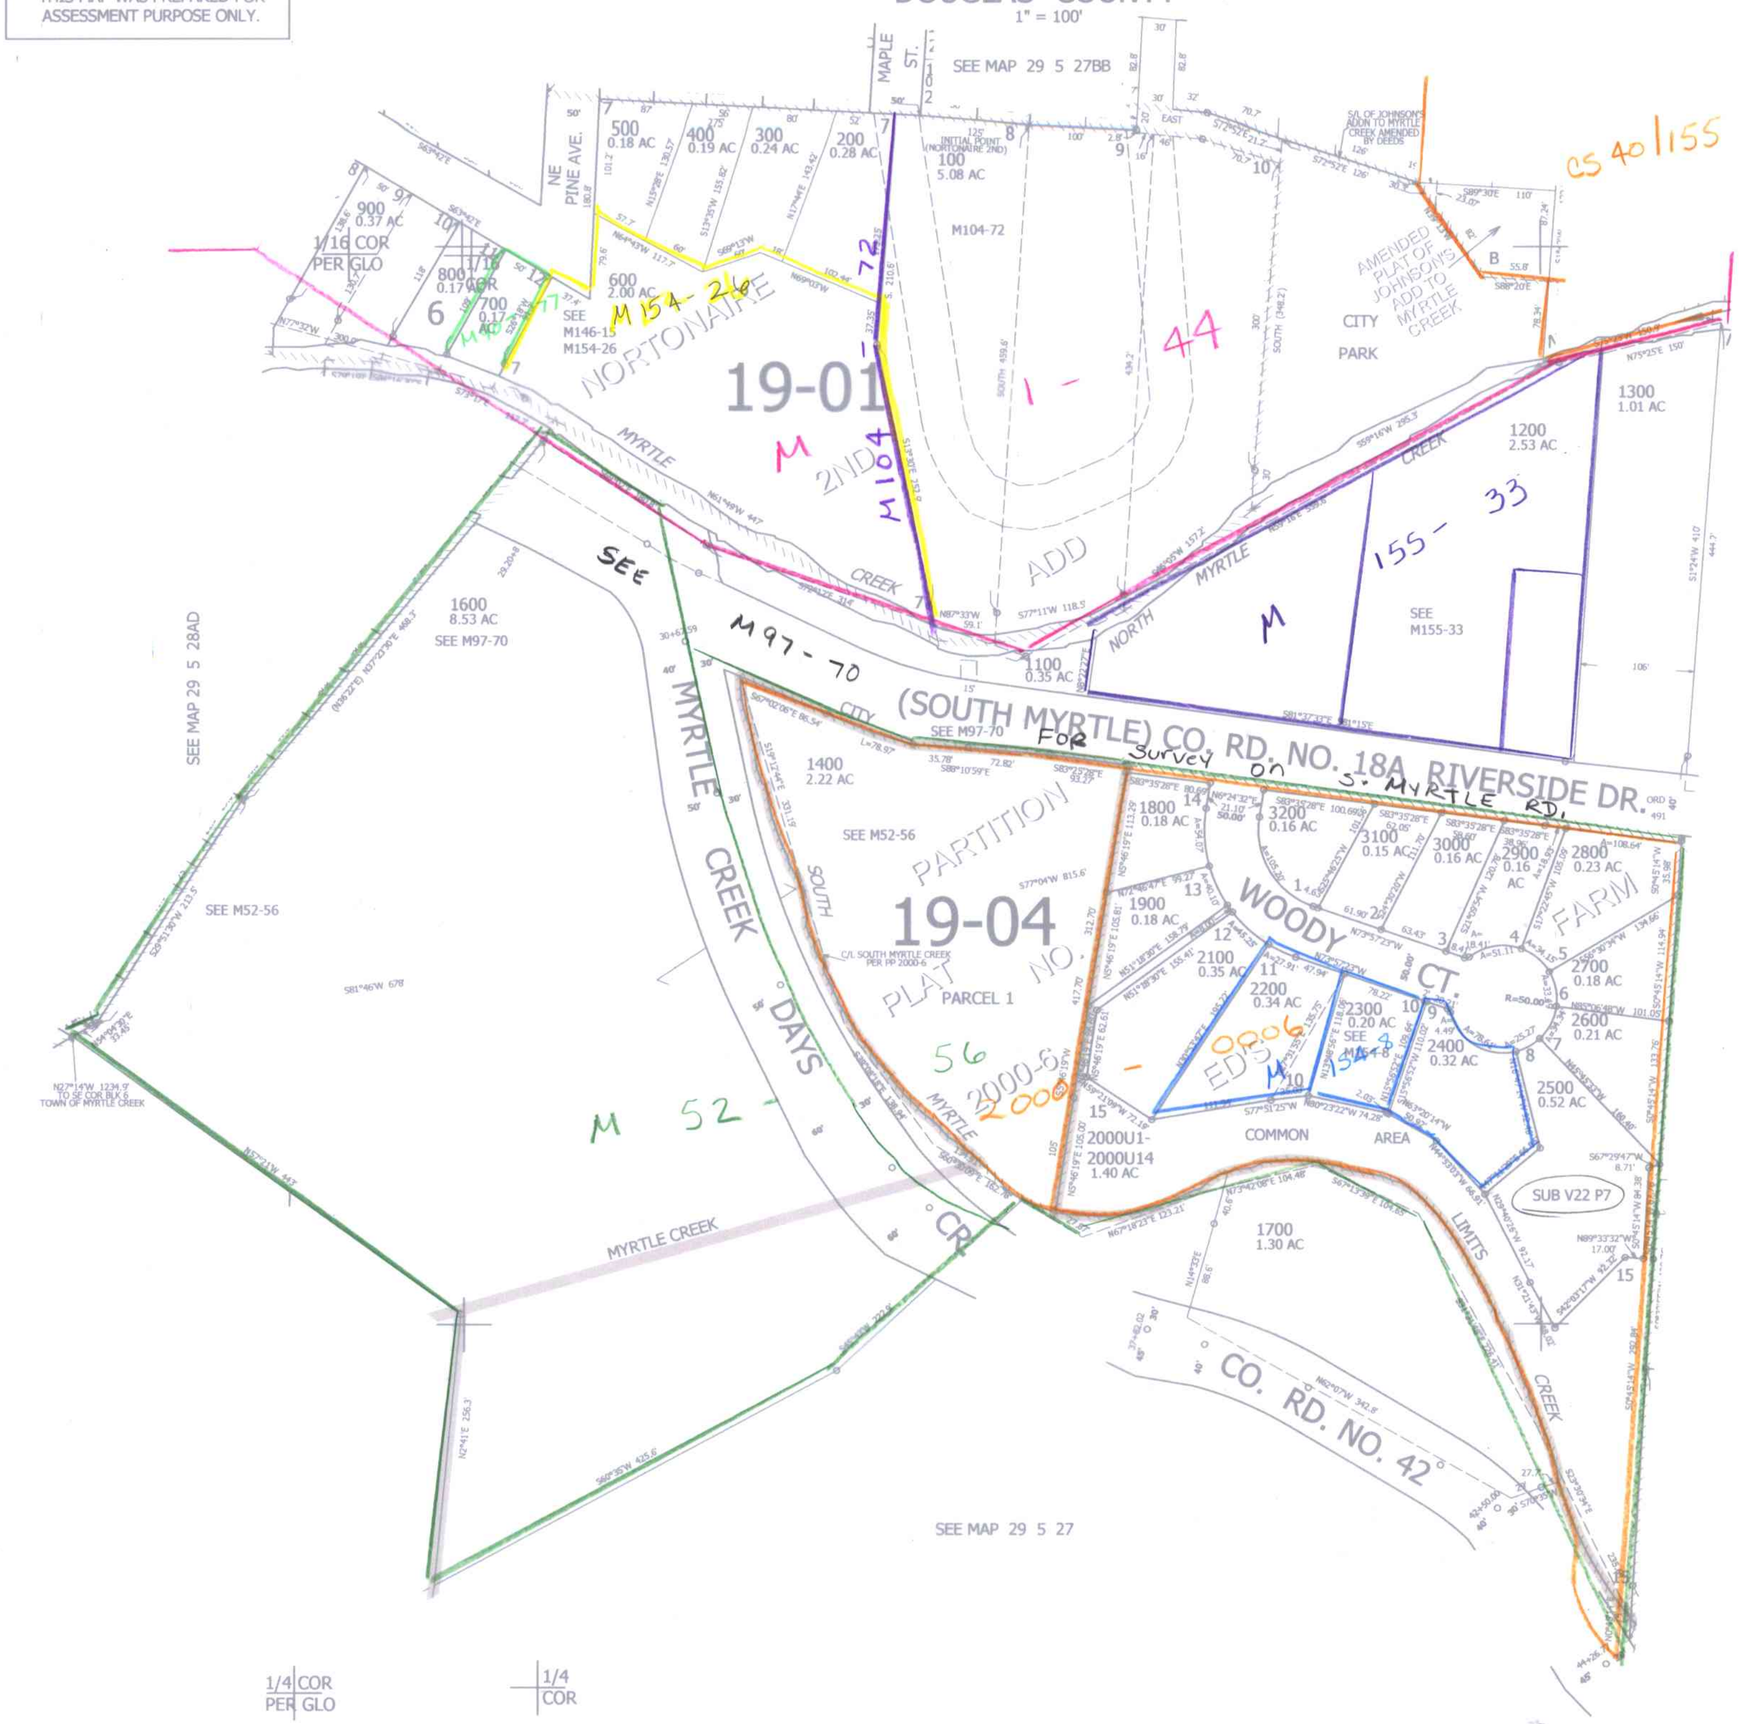

JC 5/2006 JP

29 5 27BC
MYRTLE CREEK