THIS MAP WAS PREPARED FOR ASSESSMENT PURPOSE ONLY.

NW1/4 SE1/4 SEC.28 T29S. R.5W. W.M.
DOUGLAS COUNTY
1" = 100'

REVISED ON 2-10-15

29 5 28DB
MYRTLE CREEK

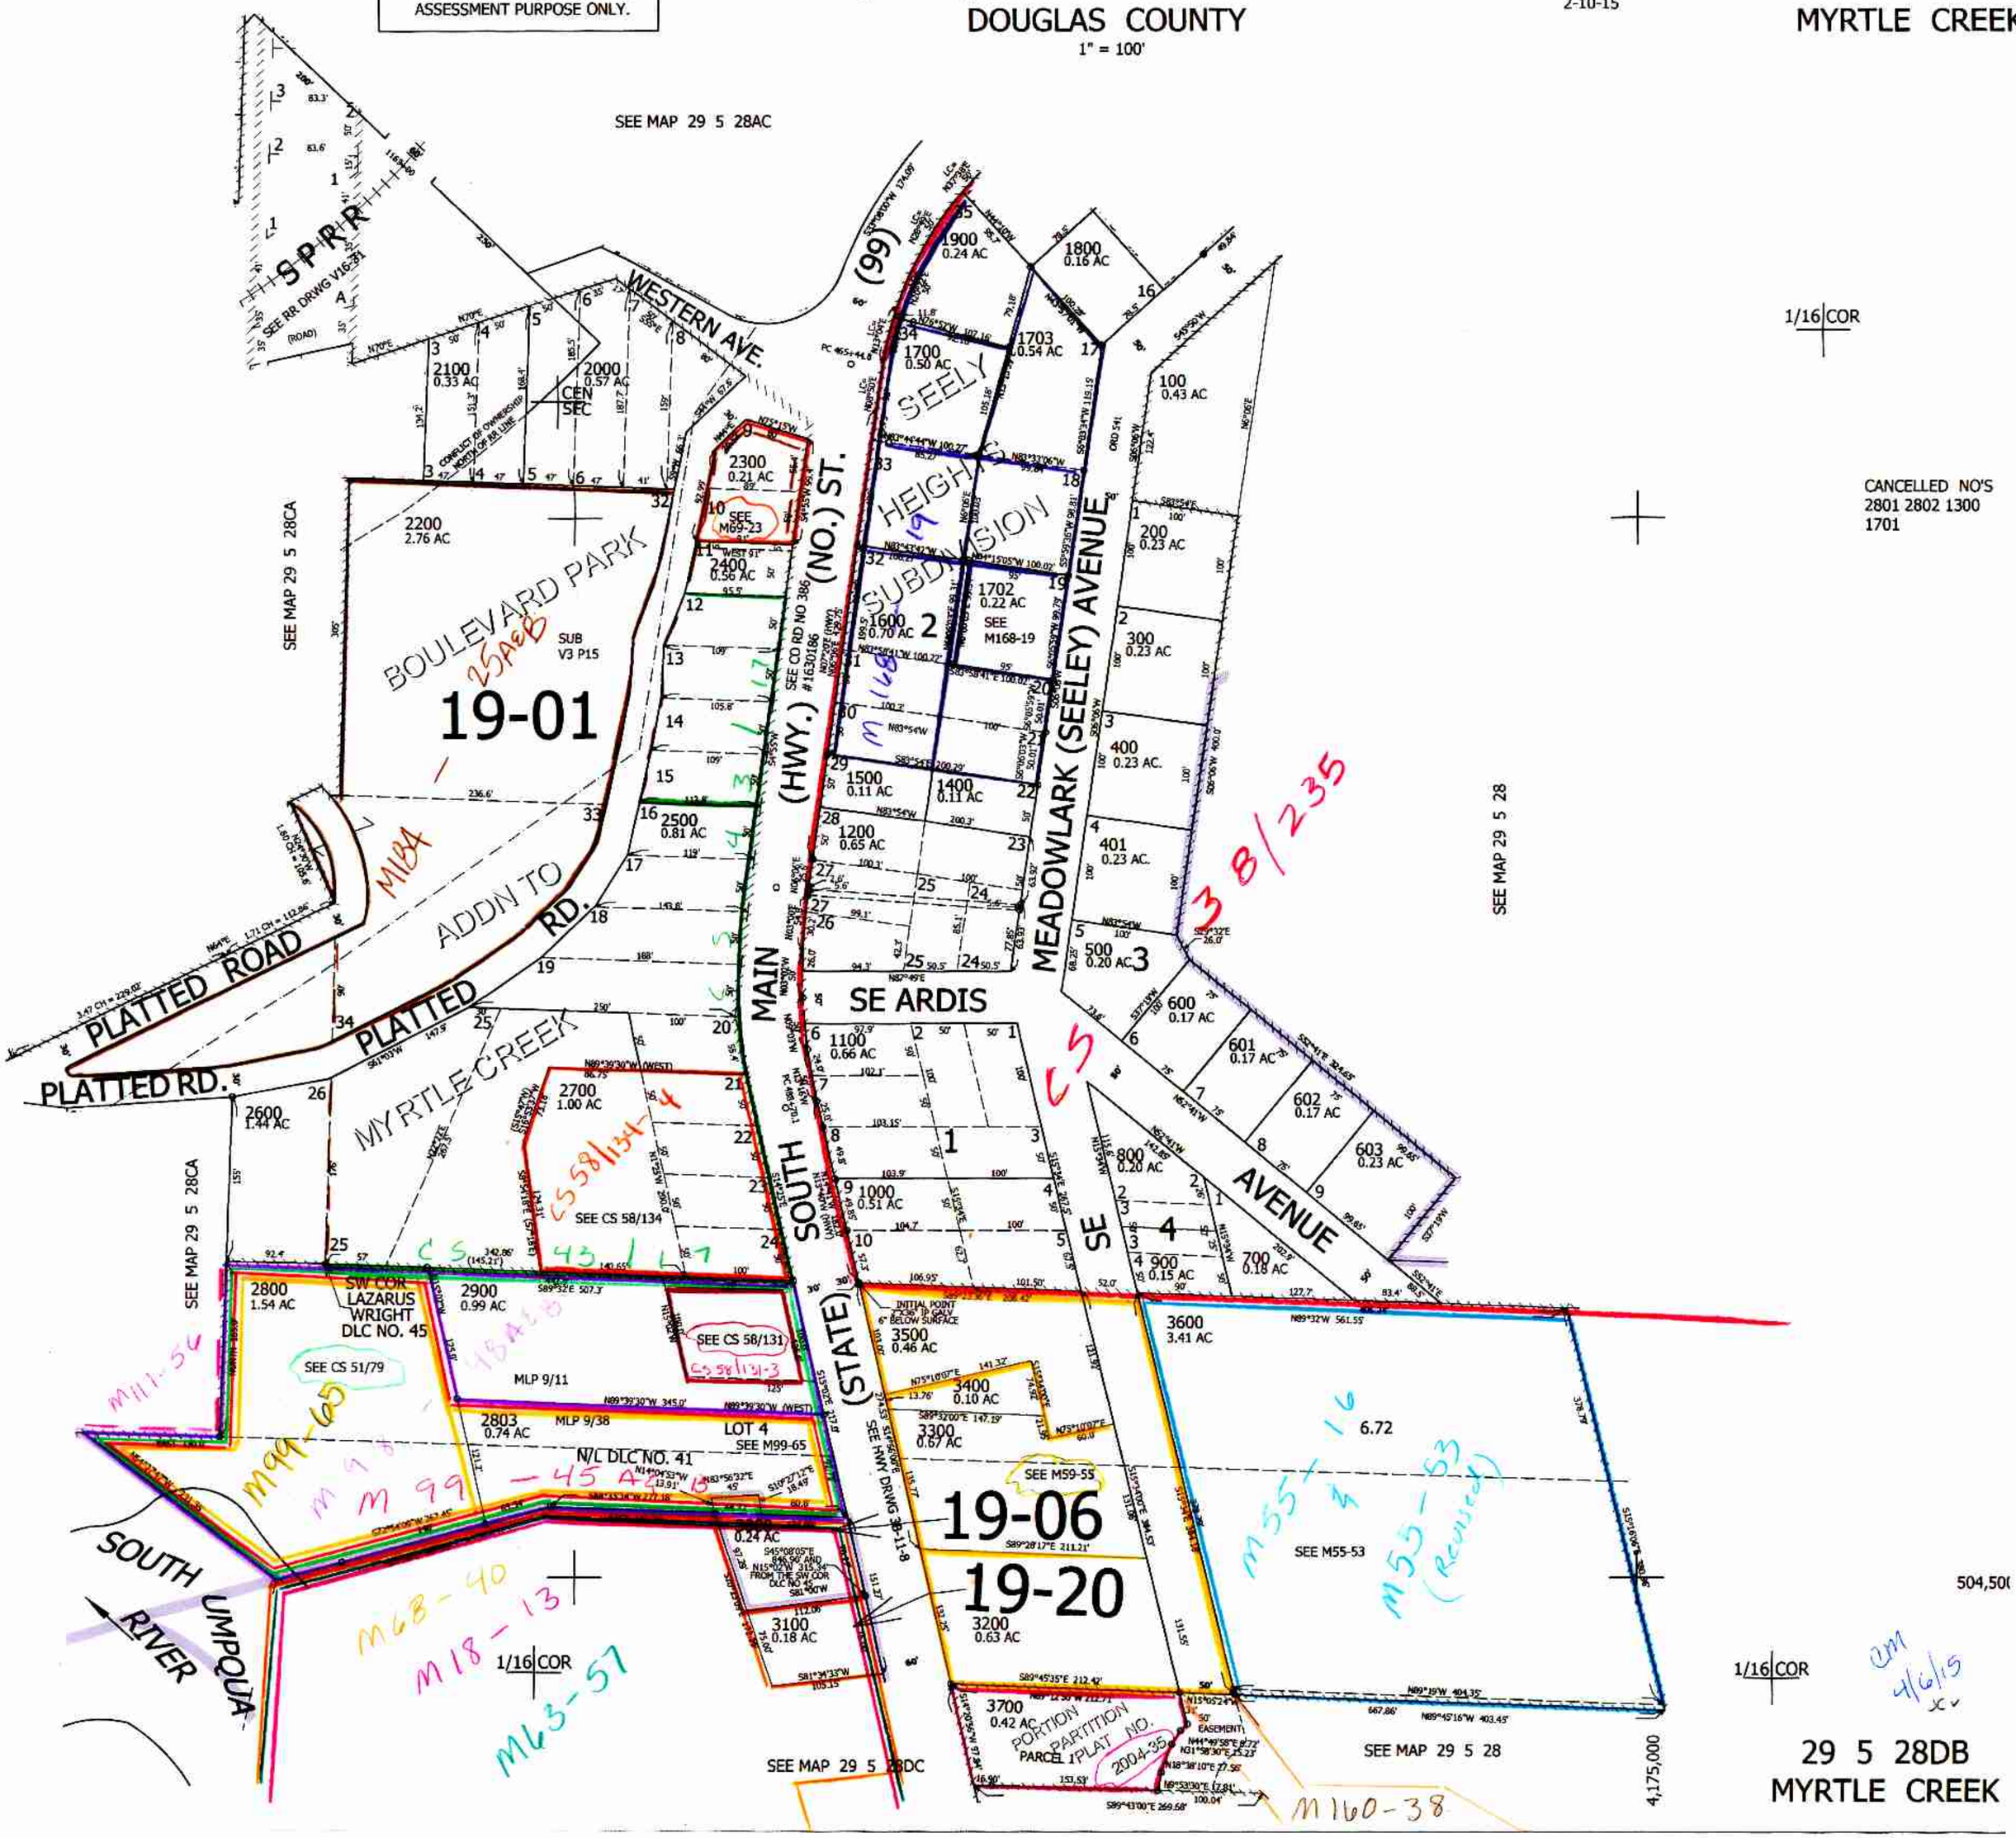

CANCELLED NO'S
2801 2802 1300
1701

29 5 28DB
MYRTLE CREEK