THIS MAP WAS PREPARED FOR ASSESSMENT PURPOSE ONLY.

SW1/4 SE1/4 SEC.28 T29S. R.5W. W.M.
DOUGLAS COUNTY

1" = 100'

REVISED ON 3-17-20
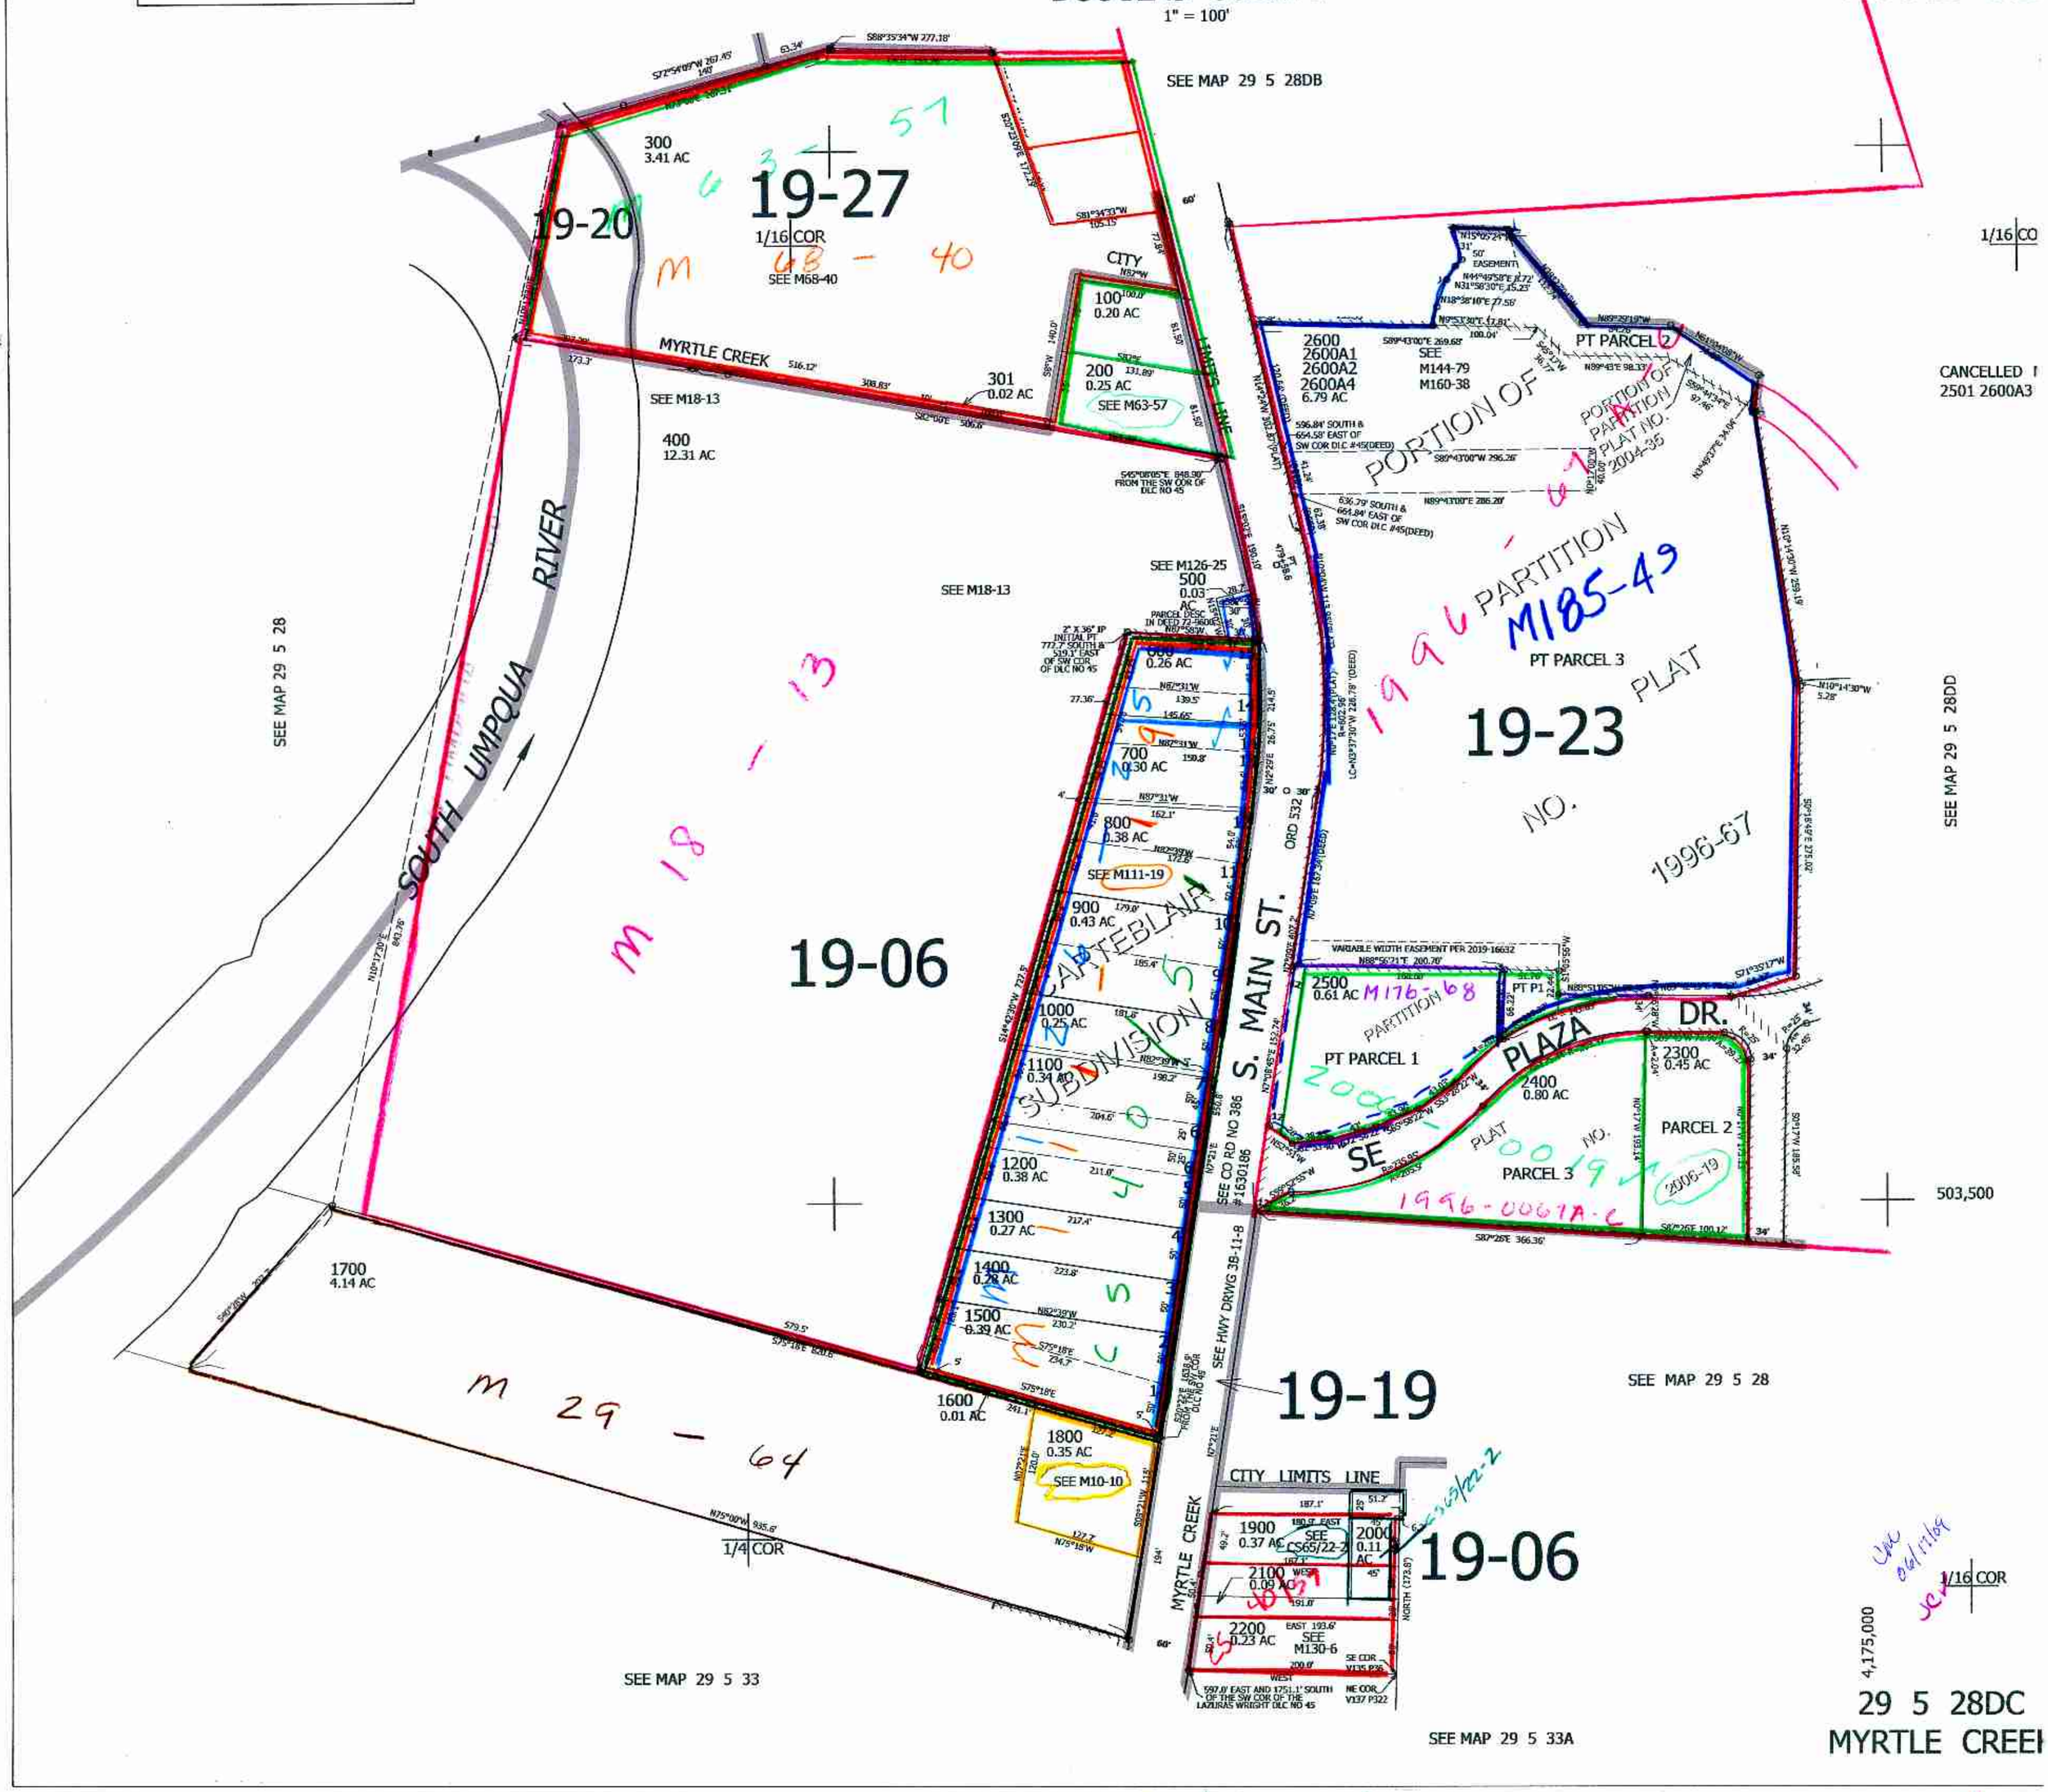
29 5 28DC
MYRTLE CREE