

THIS MAP WAS PREPARED FOR ASSESSMENT PURPOSE ONLY.

SW1/4 SEC.32 T.29S. R.5W. W.M.
DOUGLAS COUNTY
1" = 200'

REVISED ON
4-8-11

29 5 32C
MYRTLE CREEK

1/4
COR


CANCELLED NO'S
400U3 400U7 400U9
400V1 400V3 400V4
400V5 400V6 400V5
3101 2901 2700A1
2200 3200
400V1 400V4
400V6 400V8
400V2

SEE MAP 29 5 32

SEE MAP 29 5 32A

SEE MAP 29 5 31

SEE MAP 29 5 32D

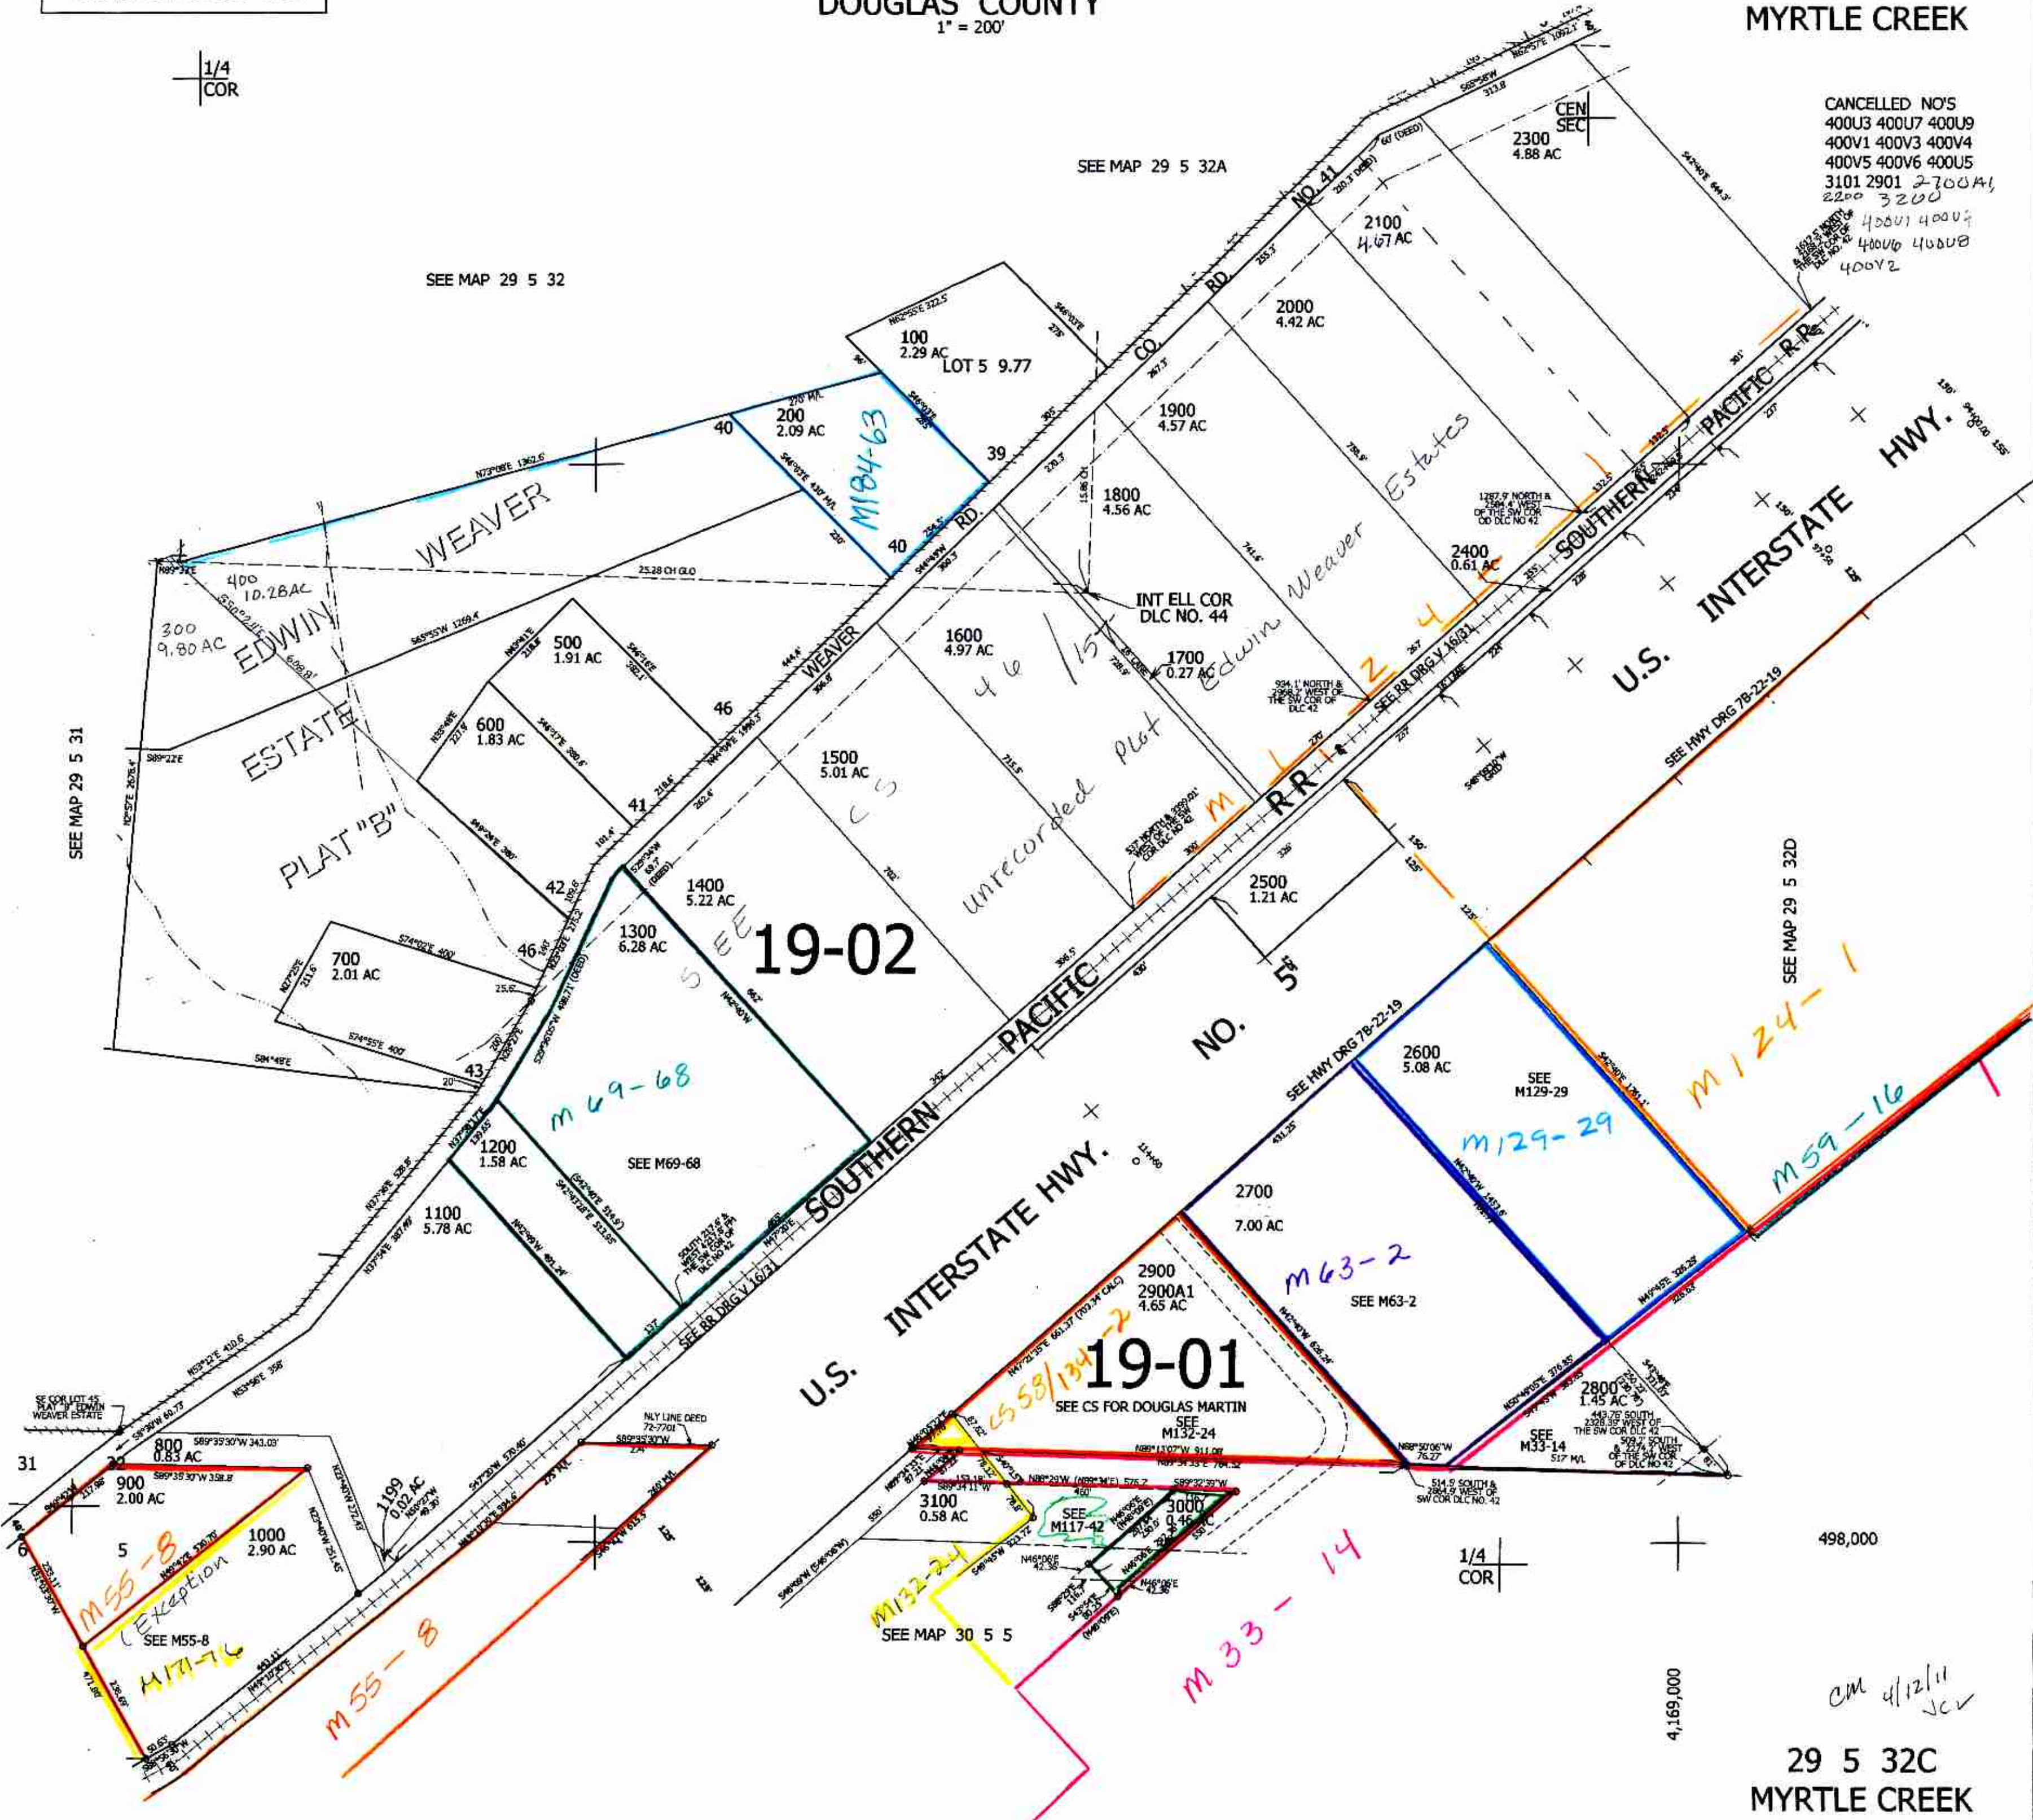

cm 4/12/11
JCV

29 5 32C
MYRTLE CREEK