


This map was prepared for assessment purpose only.

SECTION 20 T.29S. R. 6 W. W.M.
DOUGLAS COUNTY

29 6 20

1" = 400'

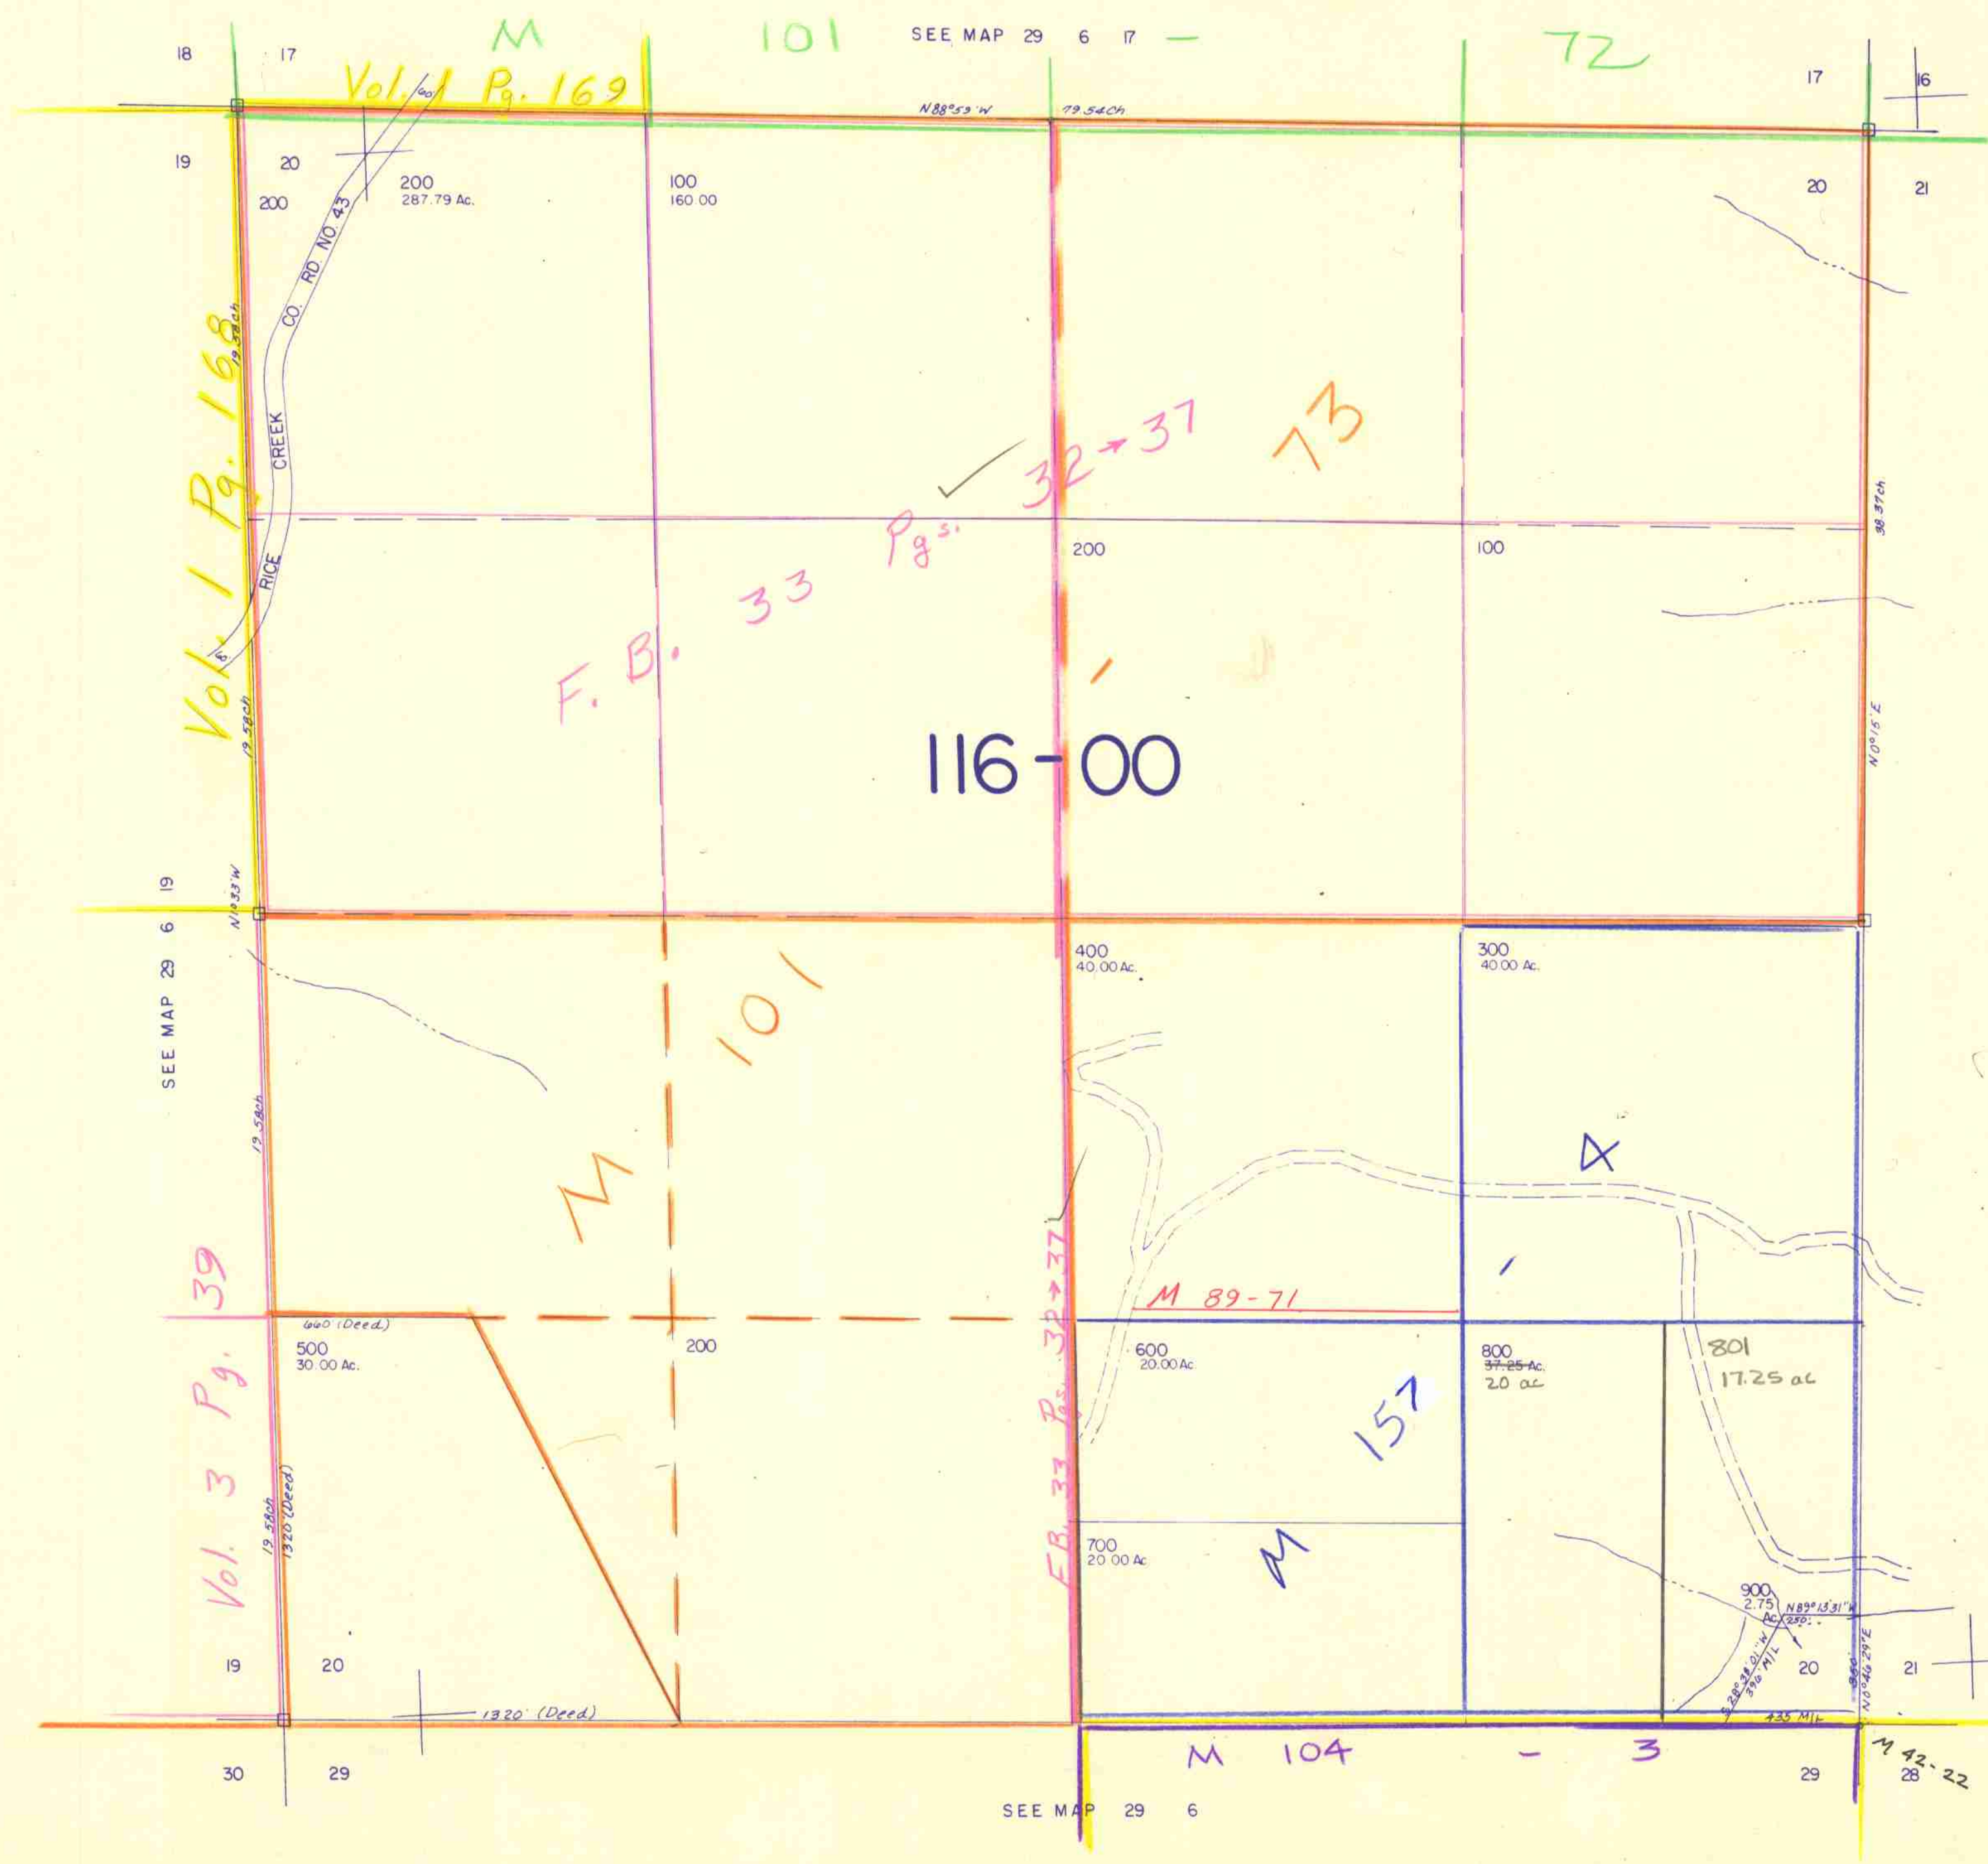

SEE MAP 29 6 21

510,000

29 6 20
12/84 BS