THIS MAP WAS PREPARED FOR ASSESSMENT PURPOSE ONLY.

SEC.27 T.29S. R.6W. W.M.
DOUGLAS COUNTY

1" = 400'

REVISED ON

29 6 27

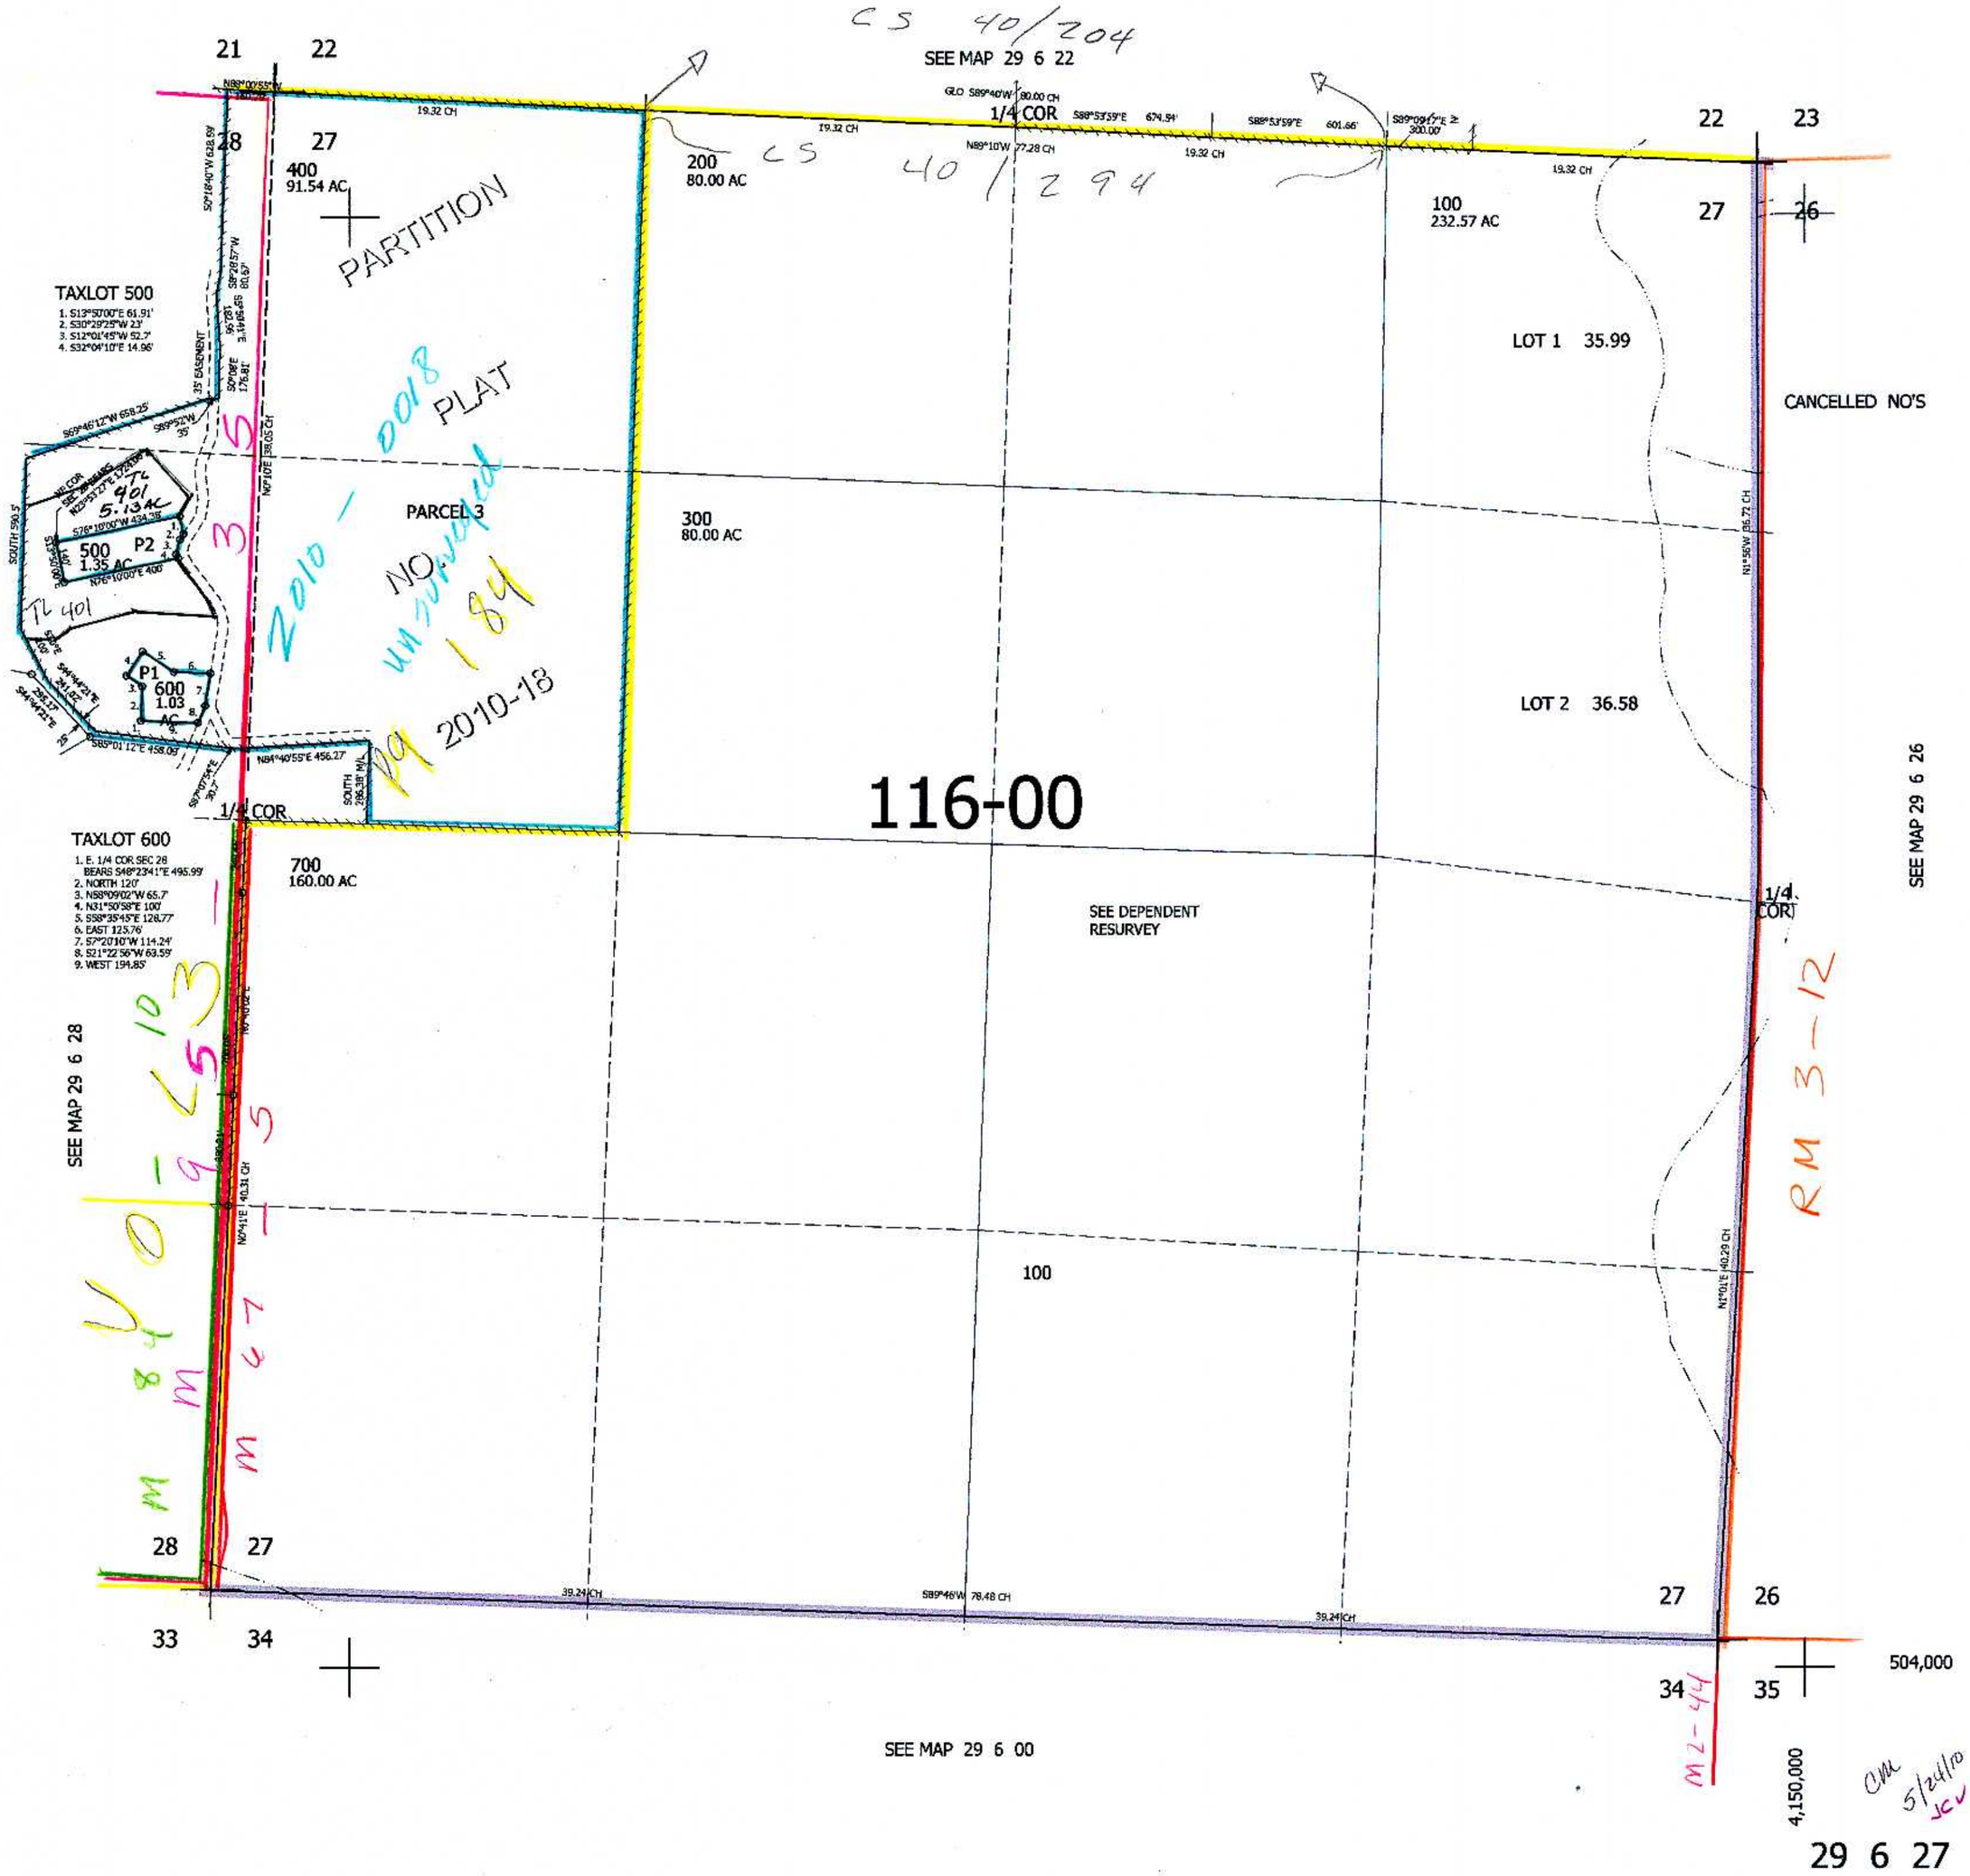

29 6 27