This map was prepared for assessment purpose only.

SECTION 36 T.29 S. R. 6 W. W.M.
DOUGLAS COUNTY

1" = 400'

REVISED ON 1-9-92
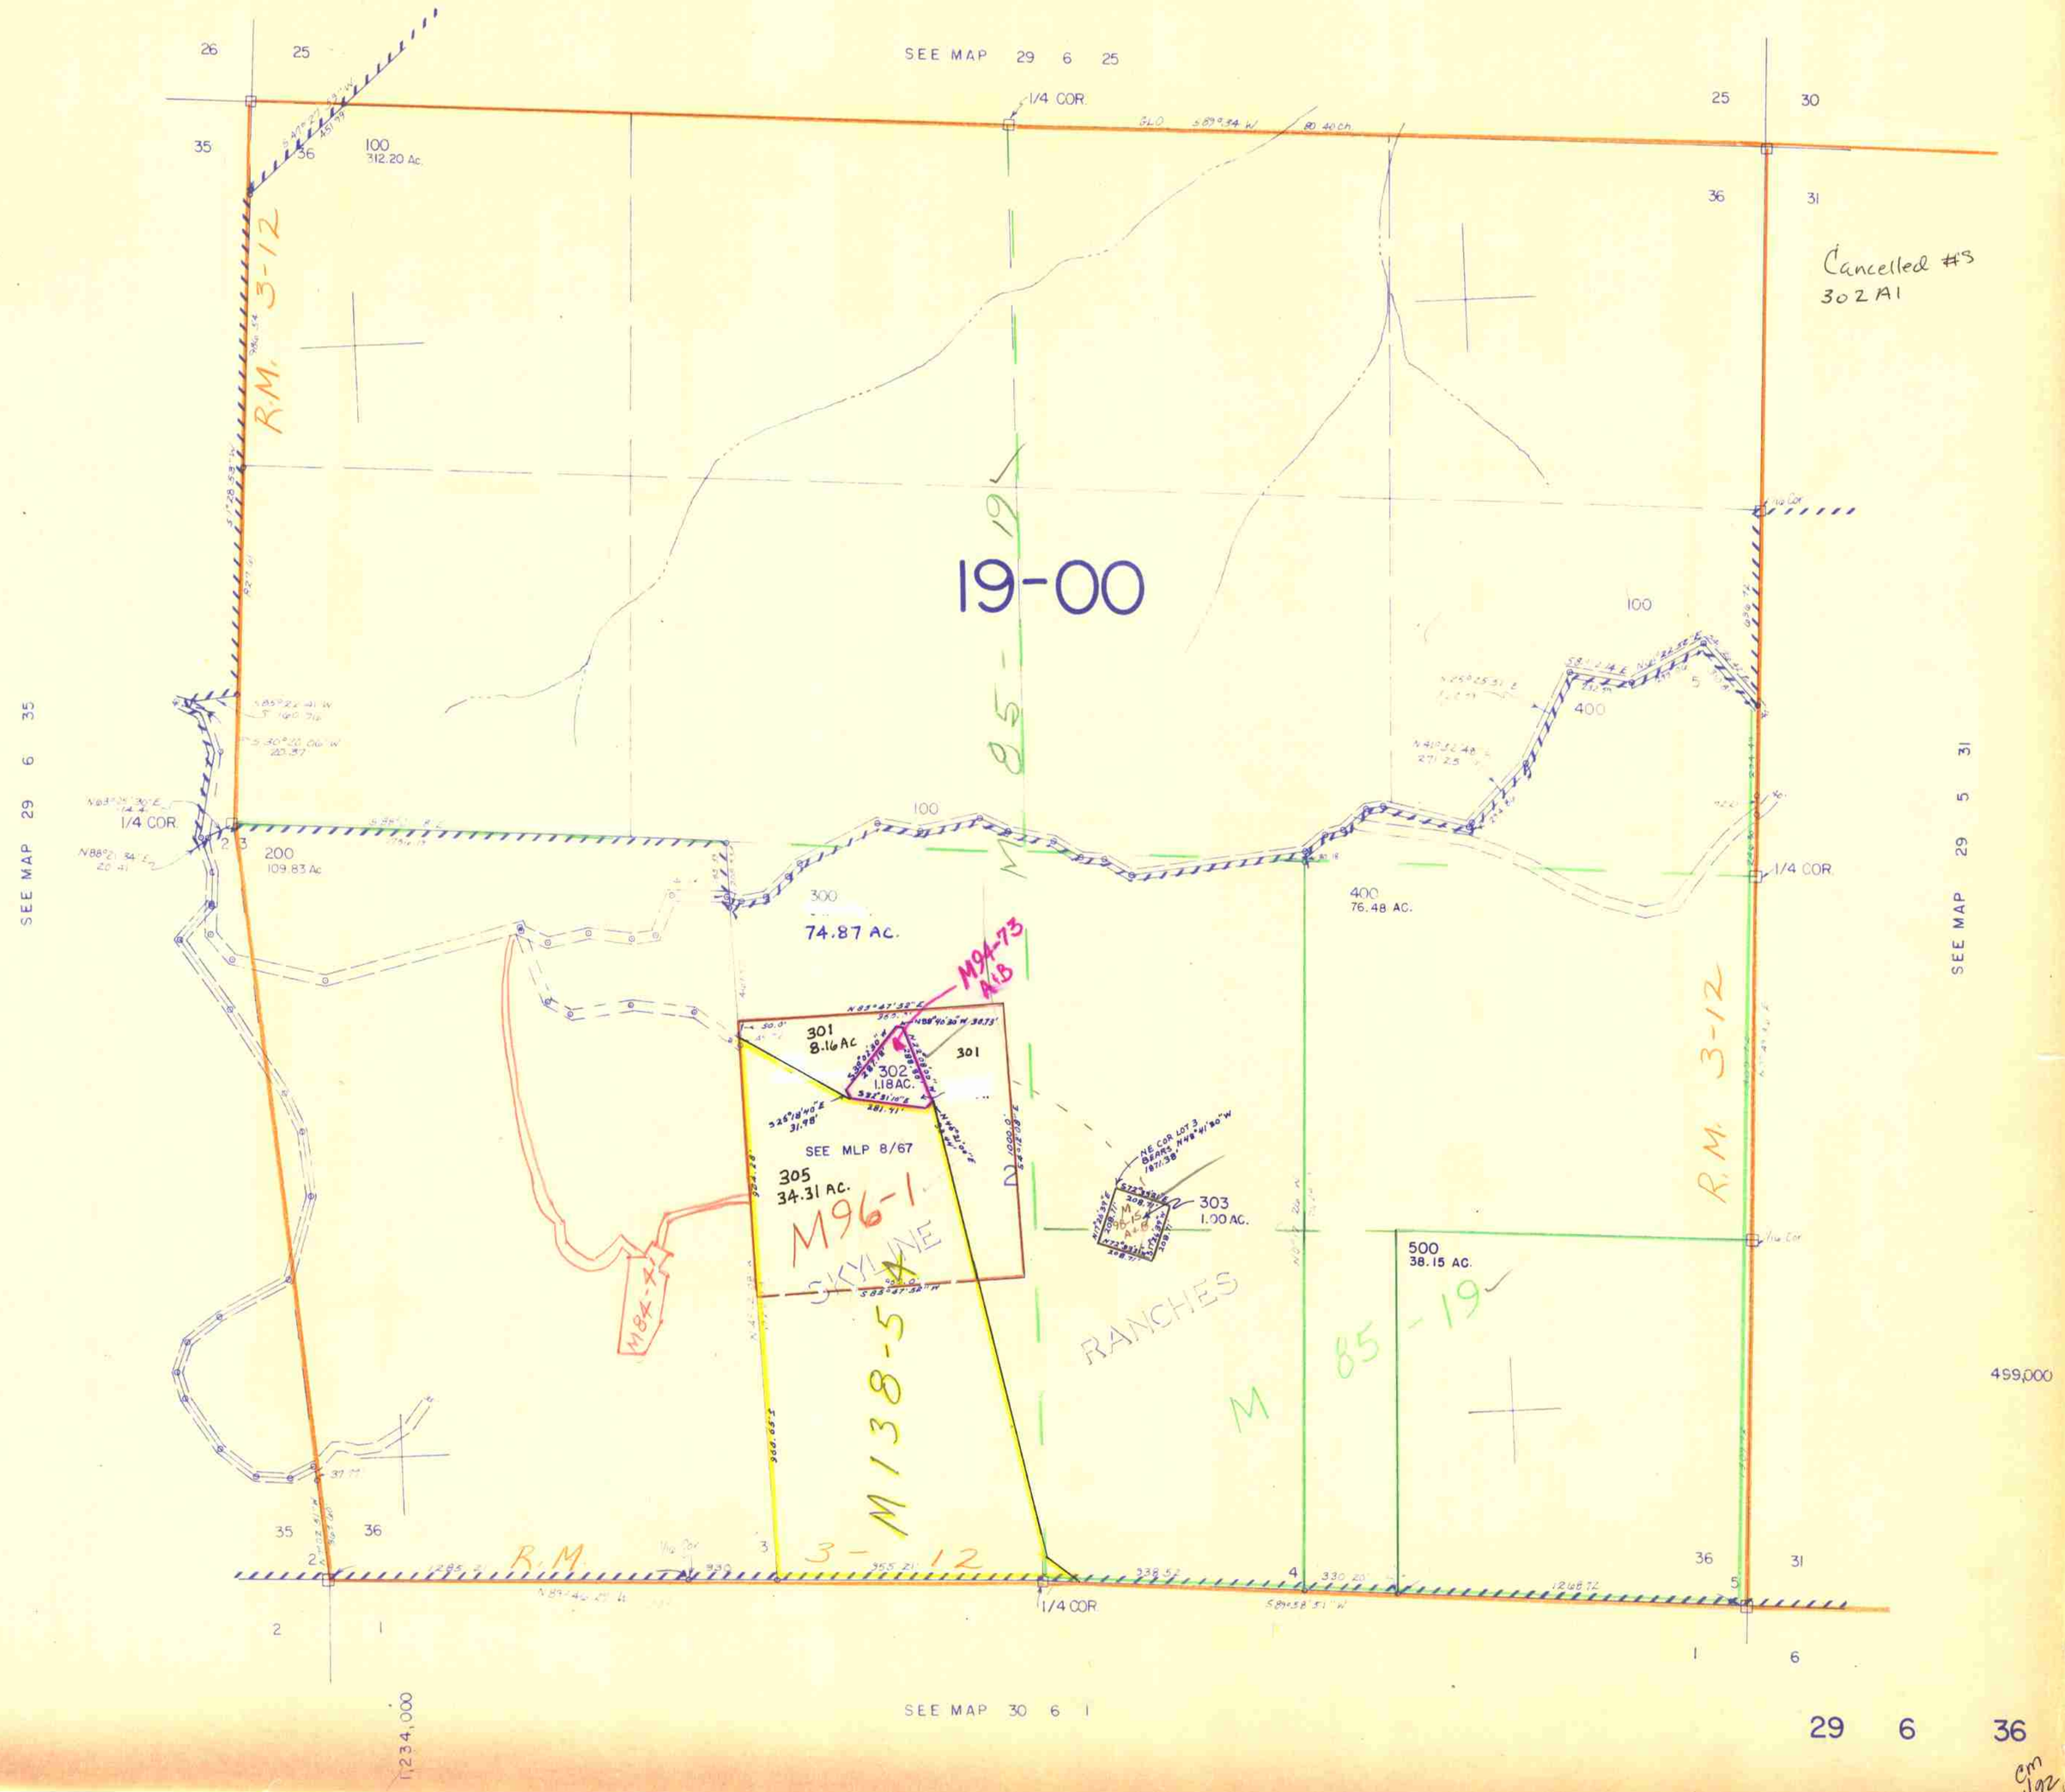
29 6 36