THIS MAP WAS PREPARED FOR ASSESSMENT PURPOSE ONLY.

SEC.20 T.29S. R.7W. W.M.
DOUGLAS COUNTY

1" = 400'

REVISED ON 6-3-20

29 7 20

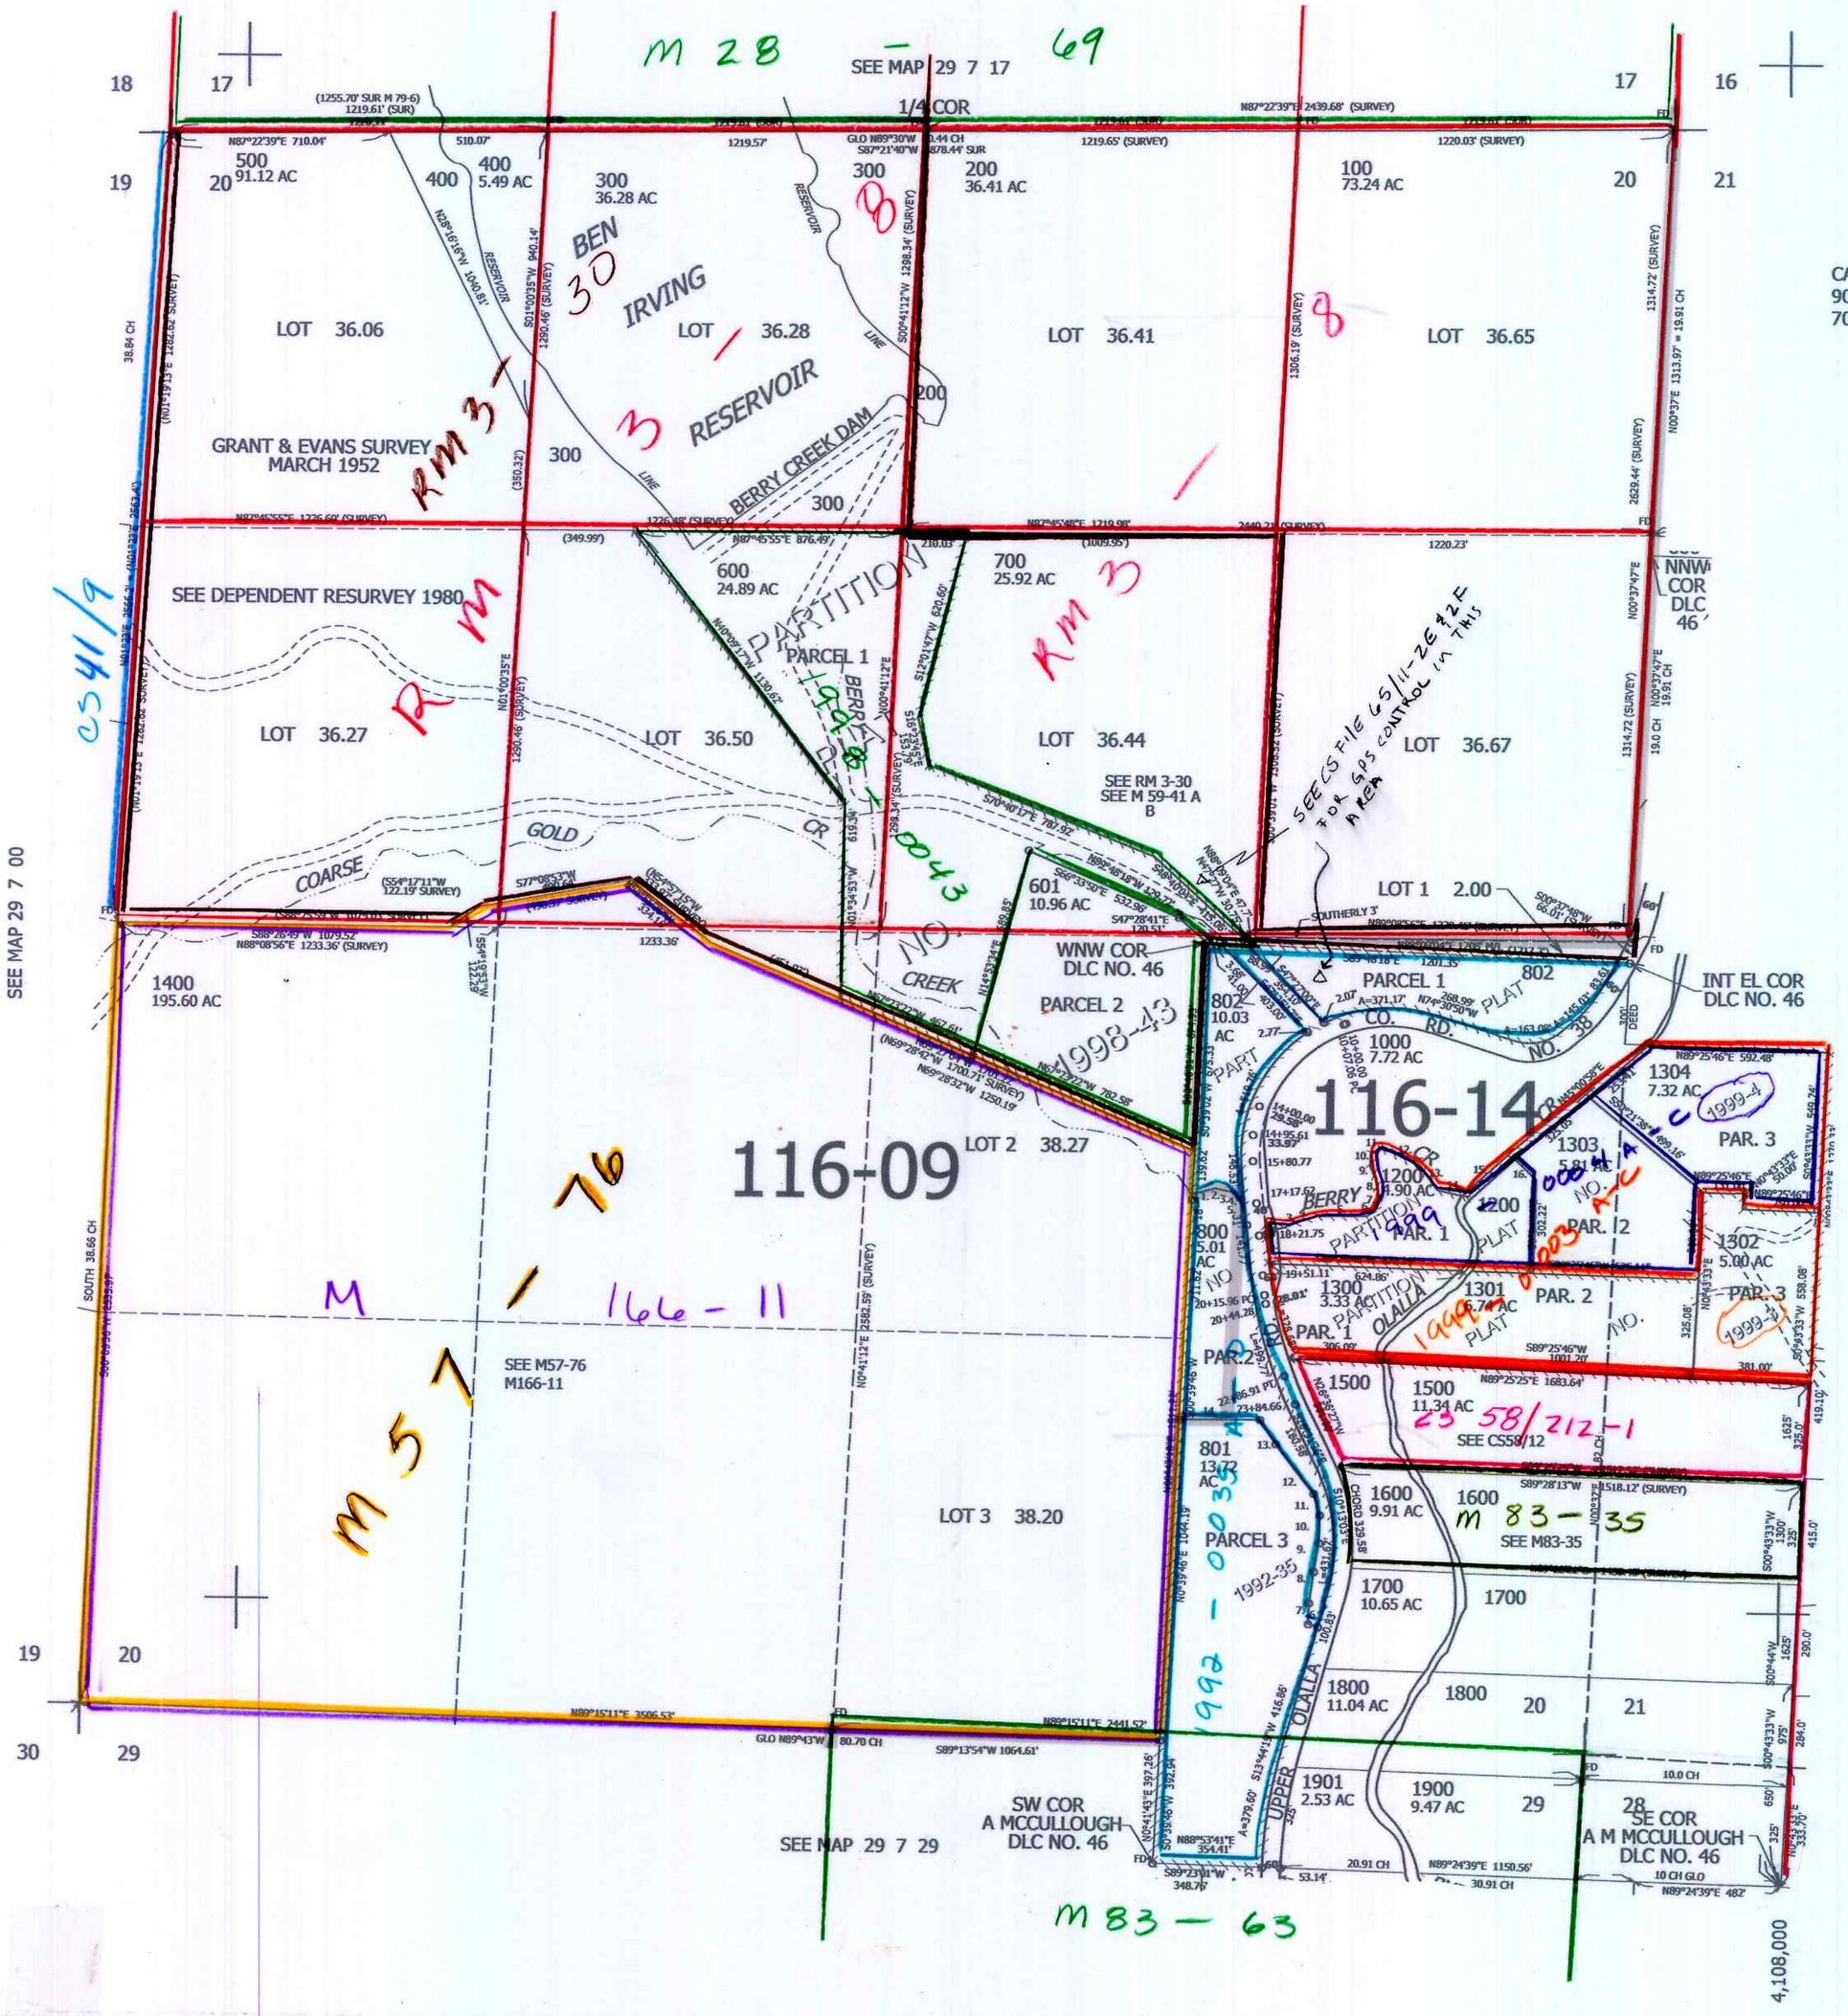

CANCELLED NO'S
900 1100 1201
701 101

PARCEL 1200

1. N7°56'27"W 128.78'
2. S84°04'03"E 75.68'
3. N67°55'44"E 60.72'
4. N69°49'12"E 53.33'
5. N87°38'30"E 159.26'
6. N57°01'36"E 31.9'
7. N19°27'23"E 40.38'
8. N12°28'58"W 67.85'
9. N25°01'34"W 45.14'
10. N0°30'47"W 42.26'
11. N60°26'43"E 39.19'
12. S66°52'07"E 137.2'
13. S39°14'35"E 96.88'
14. S79°19'05"E 97.85'
15. N45°21'51"E 196.35'
16. S49°03'53"E 109.4'

PP 1992-35

1. N73°44'25"E 78.26'
2. S81°01'51"E 47.75'
3. S73°27'07"E 25.05'
4. S22°18'53"E 46.36'
5. S26°54'54"E 28.13'
6. S76°15'41"E 32.71'
7. S0°48'14"E 67.36'
8. S5°59'55"W 101.98'
9. S8°22'43"W 94.37'
10. S1°56'42"E 90.13'
11. S18°27'43"E 72.18'
12. S40°09'37"E 204.01'
13. S35°48'50"E 93.24'
14. N87°39'E 261.4'

512,000

4,108,000

CM 4/24/13

JCV

29 7 20