


THIS MAP WAS PREPARED FOR ASSESSMENT PURPOSE ONLY.

SEC.21 T.29S. R.7W. W.M. DOUGLAS COUNTY

29 7 21

REVISED ON 8-13-10

1" = 400'

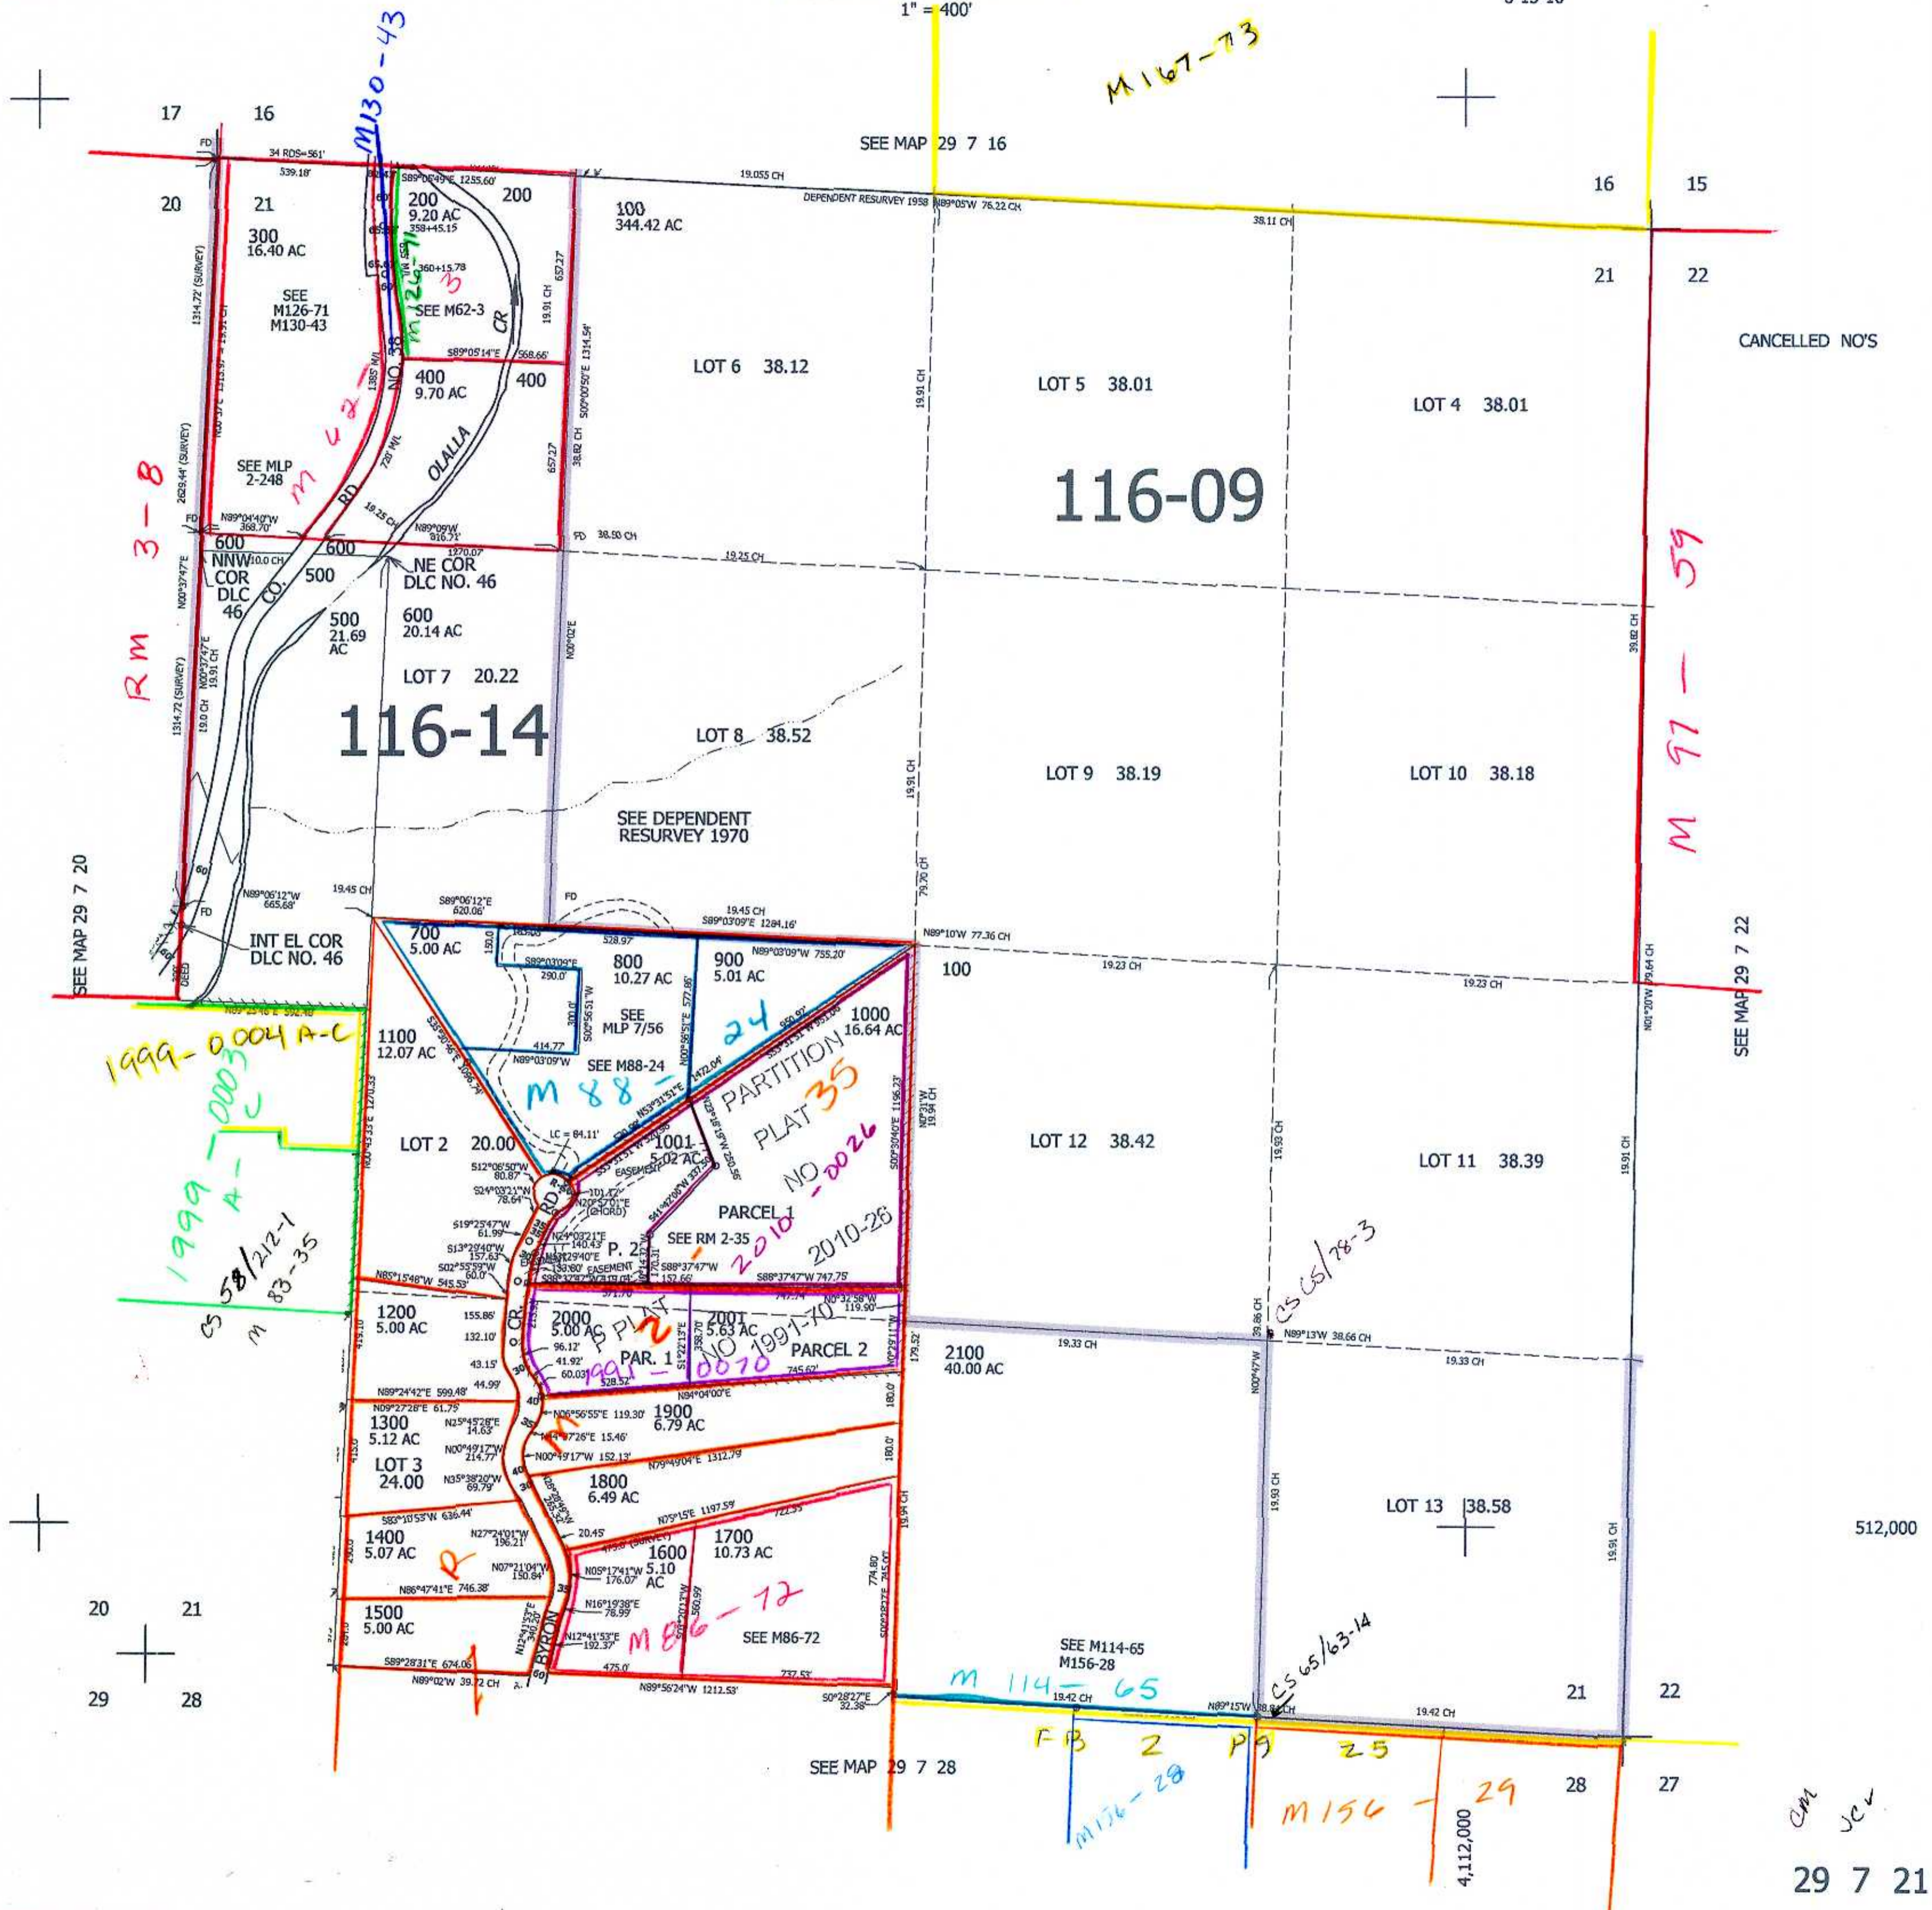

CANCELLED NO'S

116-09

116-14

512,000

CM
Jew

29 7 21