


SECTION 32 T.29S. R.7W. W.M.
DOUGLAS COUNTY

THIS MAP WAS PREPARED FOR
ASSESSMENT PURPOSE ONLY.

1"=400'

REVISED ON
12-23-91

CANCELLED NOS
1001
1101
901
1002
1200A1

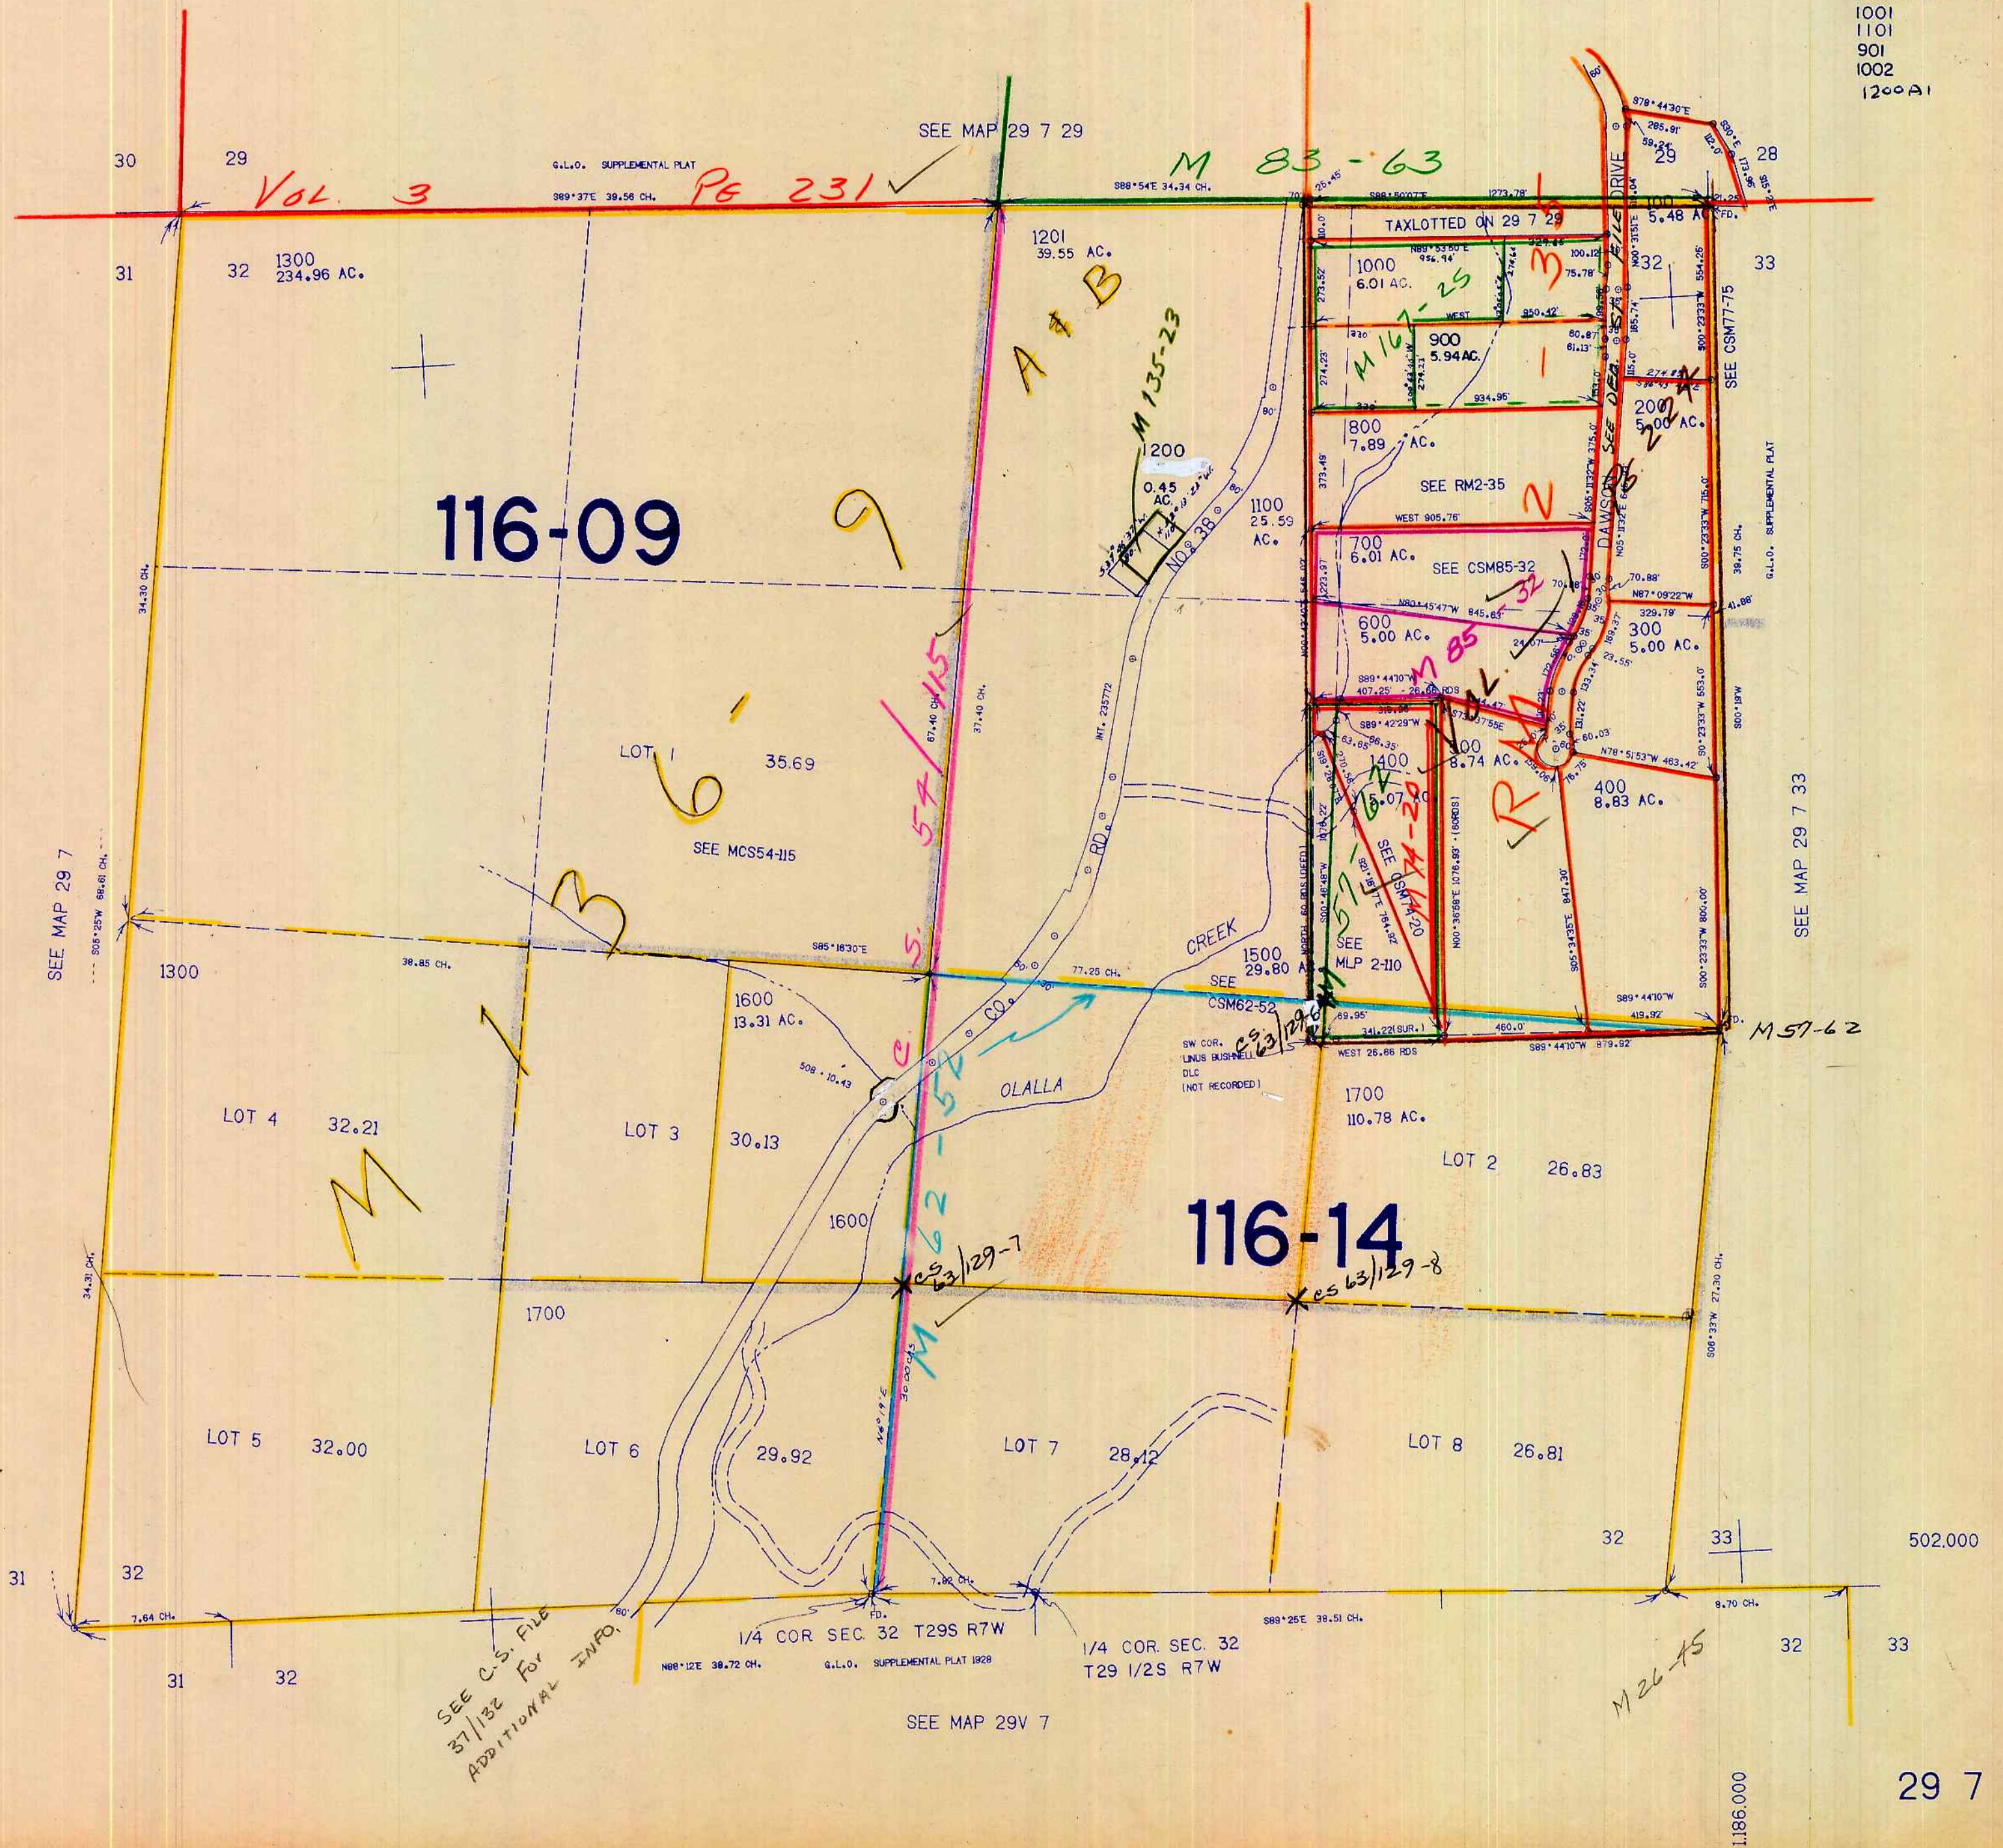

1928