


THIS MAP WAS PREPARED FOR ASSESSMENT PURPOSE ONLY.

T.29S. R.8W.W.M. DOUGLAS COUNTY

1"-2000' SEE MAP 27 8

REVISED ON 5-28-92

29 8 & INDEX

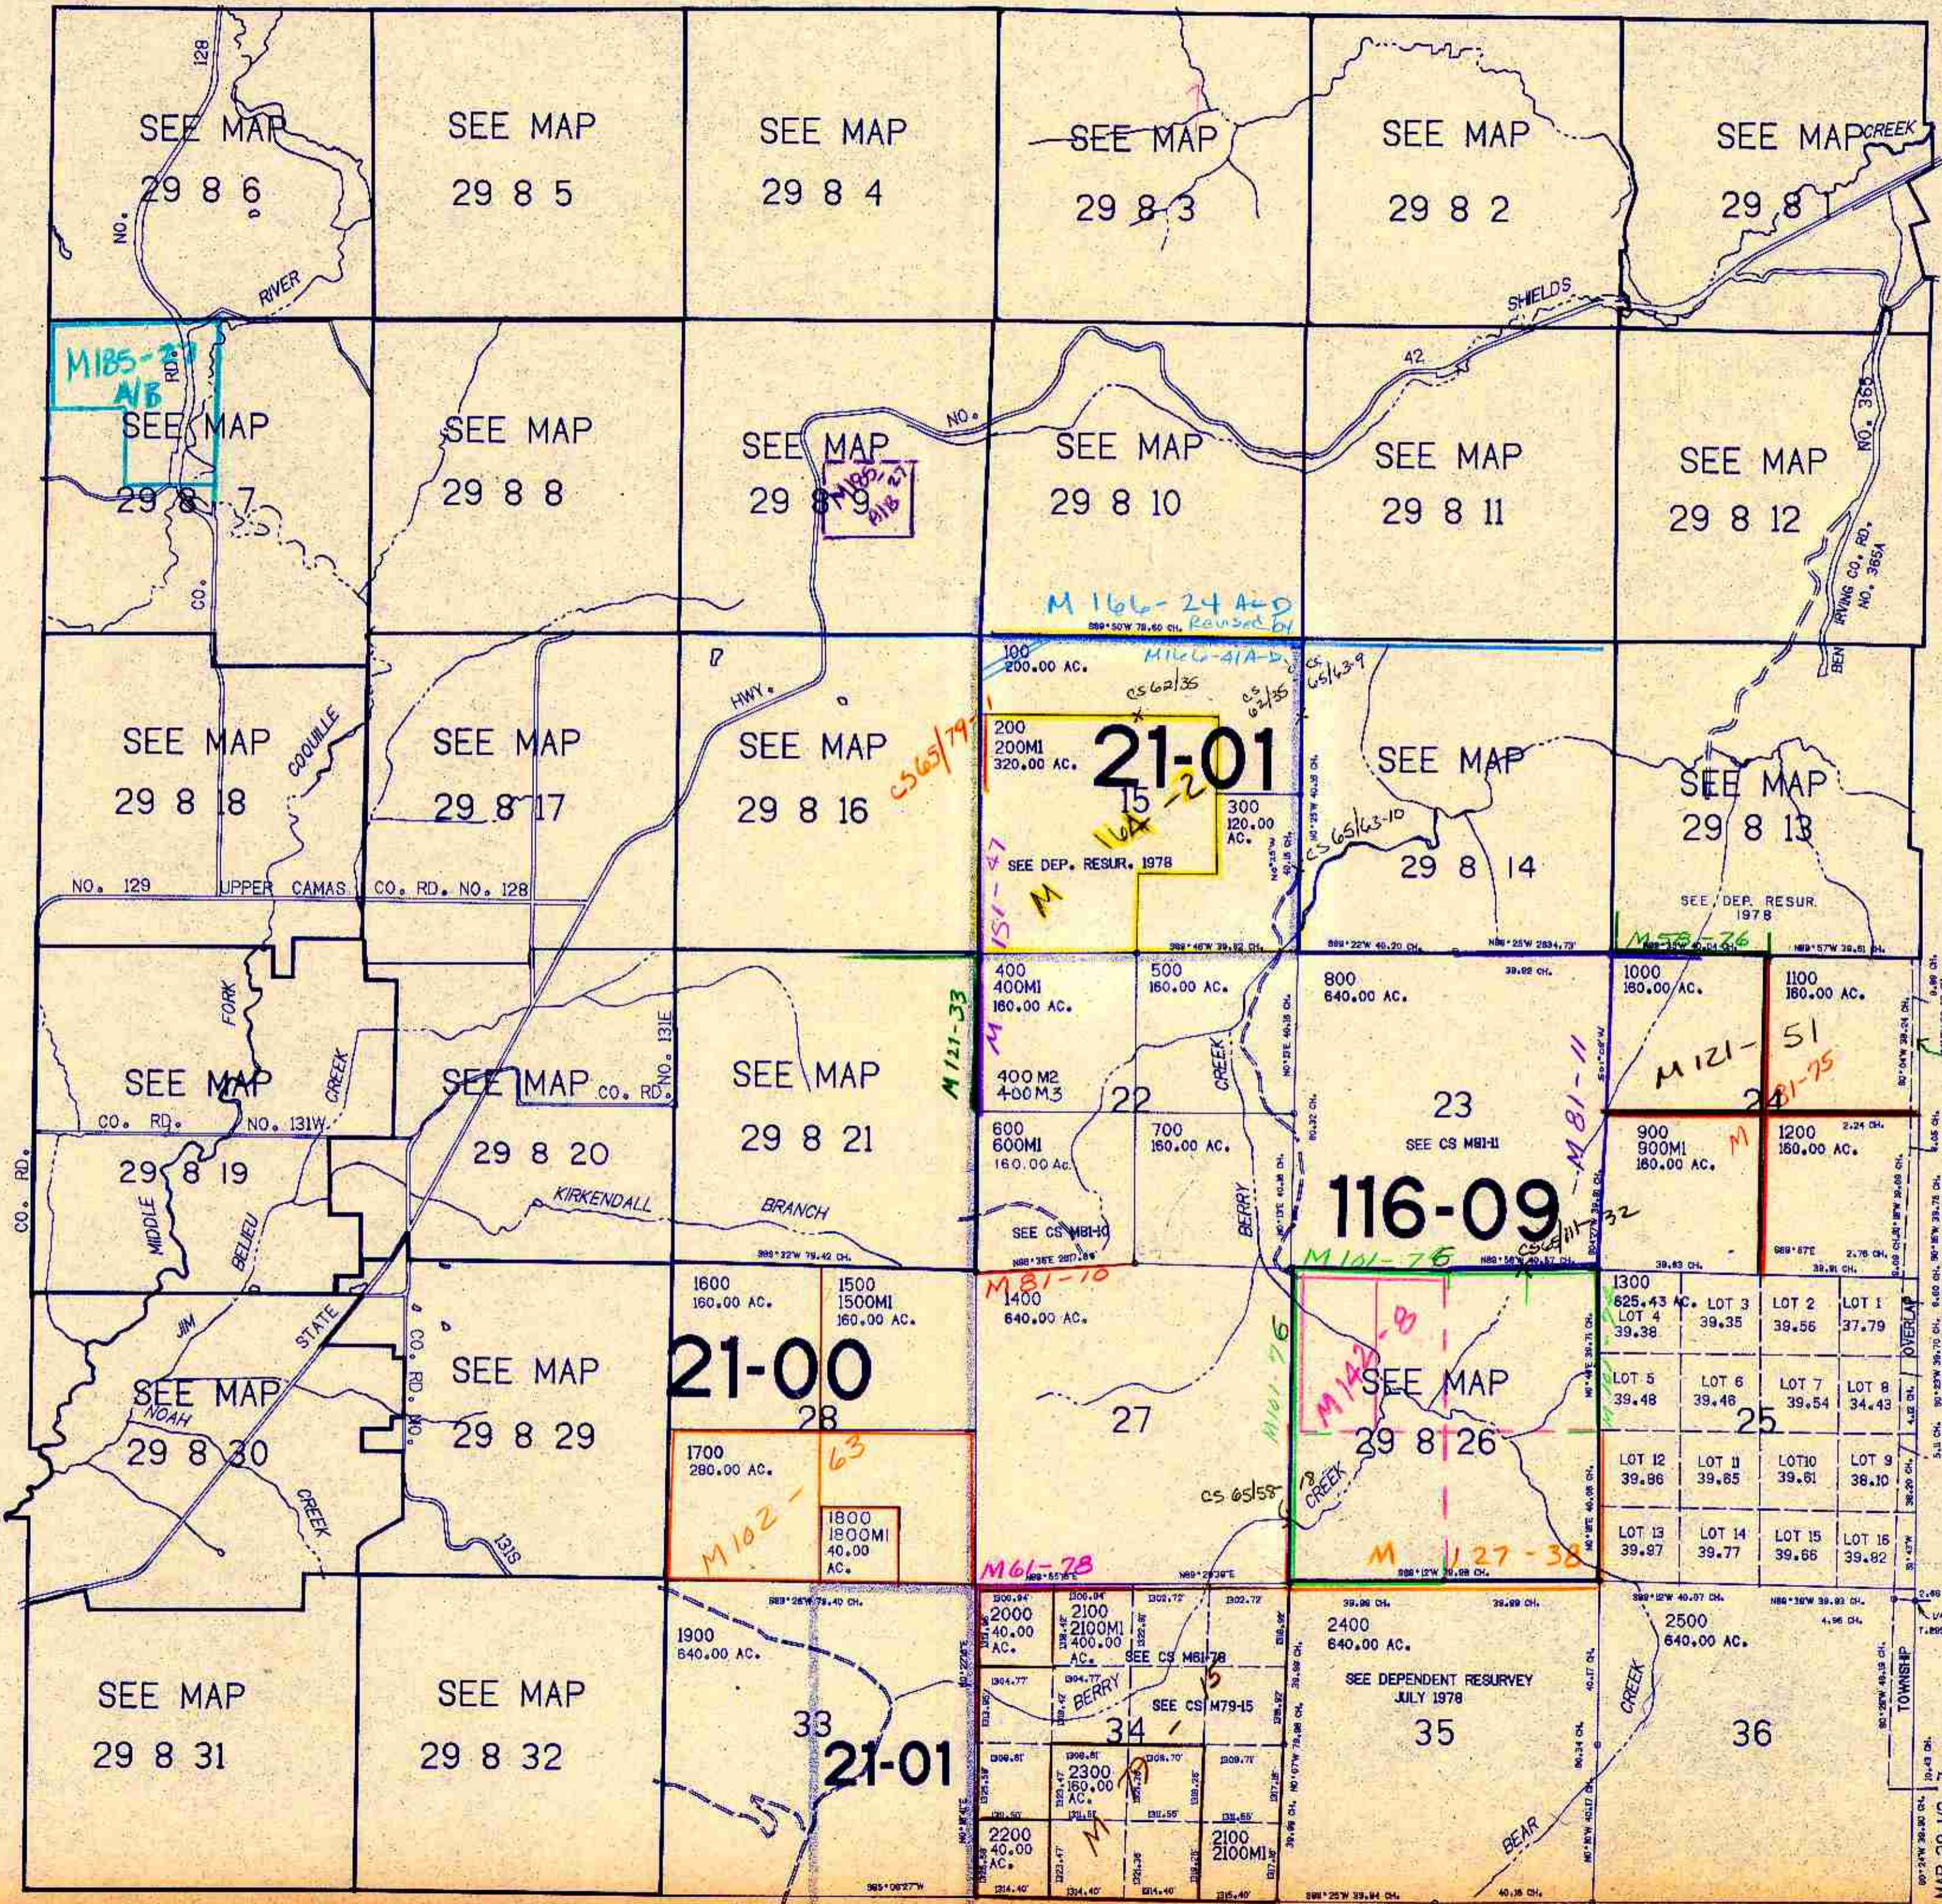

SEE MAP 29 9

SEE MAP 29 7

1/4
5.19
T29-7
see cs
65166-47

29 8 & INDEX

SEE MAP 30 8

SEE MAP 29 1/2 7 31