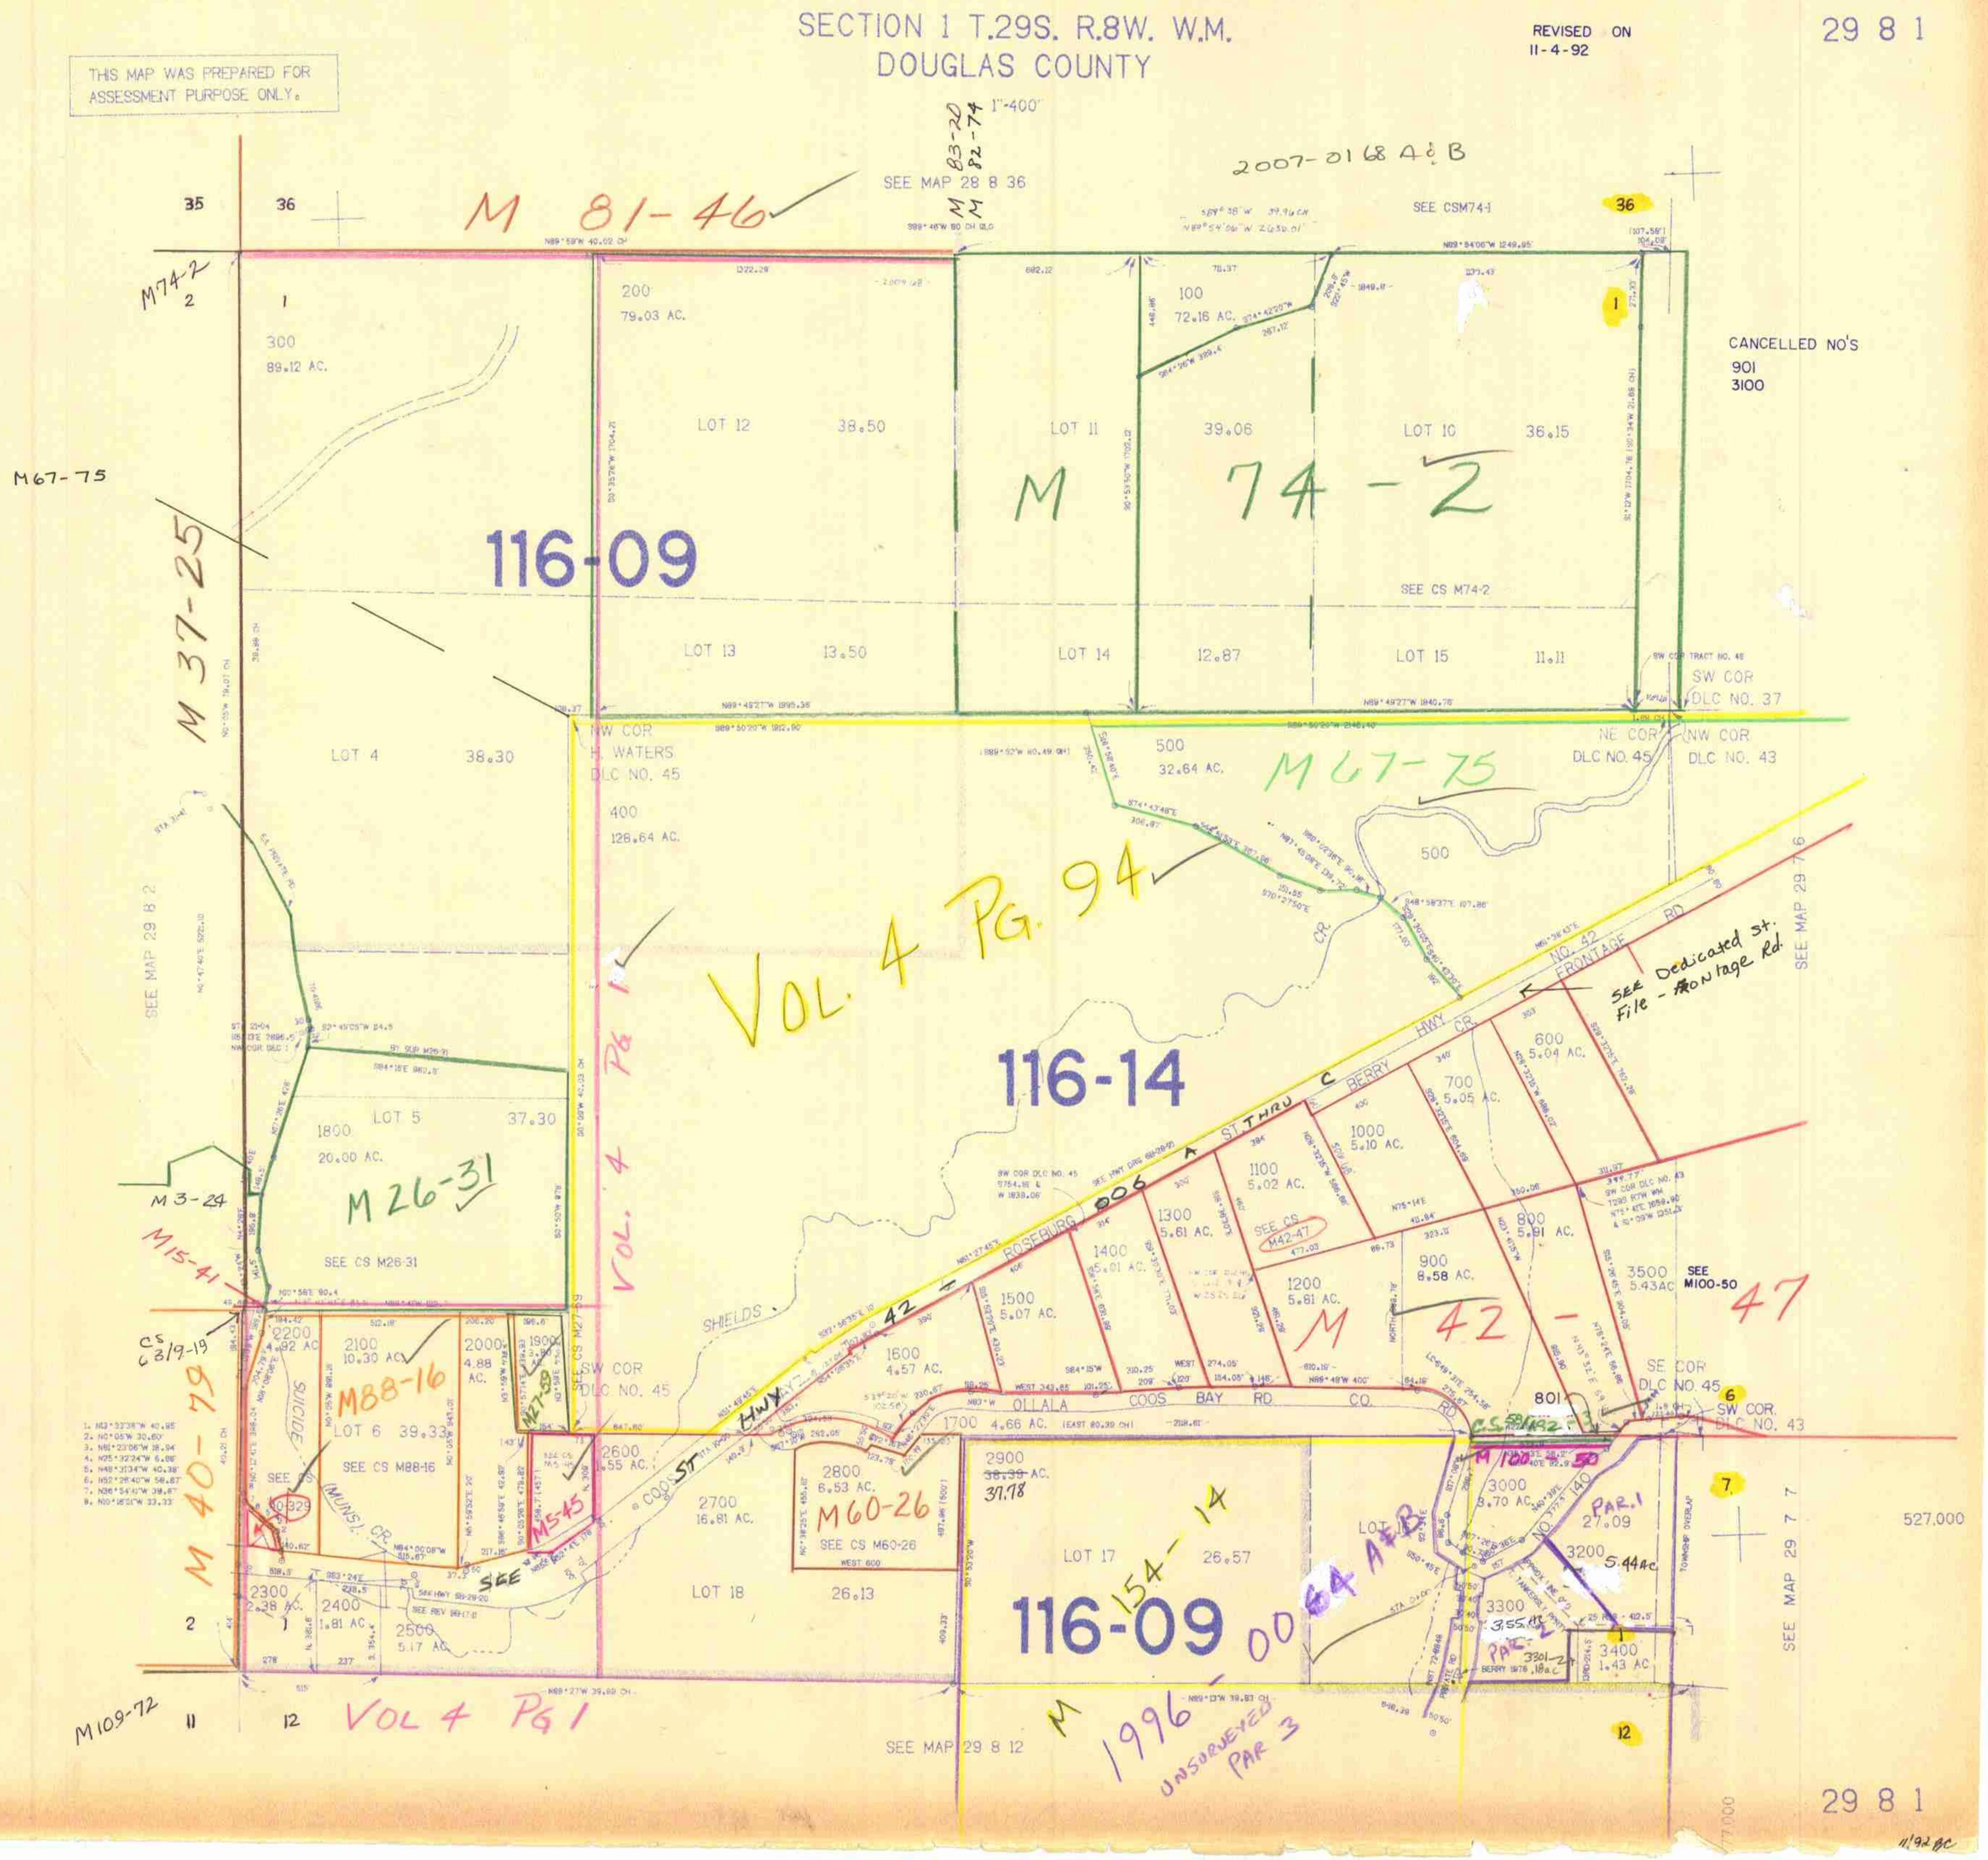
SECTION 1 T.29S. R.8W. W.M.
DOUGLAS COUNTY
REVISED ON 11-4-92
29 8 1
THIS MAP WAS PREPARED FOR ASSESSMENT PURPOSE ONLY.
1"=400'
SEE MAP 28 8 36
SEE CSM74-1
CANCELLED NO'S 901 3100
116-09
116-14
LOT 4 38.30
LOT 5 37.30
LOT 6 39.33
LOT 10 36.15
LOT 11 39.06
LOT 12 38.50
LOT 13 13.50
LOT 14 12.87
LOT 15 11.11
LOT 17 26.57
LOT 18 26.13
SEE CS M74-2
SW COR DLC NO. 37
NW COR H. WATERS DLC NO. 45
NE COR DLC NO. 45
NW COR DLC NO. 43
SW COR DLC NO. 45
SE COR DLC NO. 45
SEE MAP 29 8 2
SEE MAP 29 7 6
SEE MAP 29 7 7
SEE MAP 29 8 12
ROSEBURG HWY
OLLALA COOS BAY RD CO.
BERRY CR.
FRONTAGE RD NO. 42
SHIELDS
MUNSEL CR.
SUICIDE
SEE Dedicated St. File - Frontage Rd.
SEE M100-50
527,000
29 8 1
M 81-46
M 74-2
M 37-25
M 67-75
M 42-47
M 26-31
M 40-79
M 154-14
M 1996-00 64 A&B
VOL. 4 PG. 94
VOL. 4 PG 1
M 3-24
M 15-41
M 109-72
M 67-75
M 88-16
M 60-26
M 100-50
M 27-58
M 54-5
M 42-47
11/92 BC