SECTION 10 T.29S. R.8W. W.M.
DOUGLAS COUNTY

1"=400'
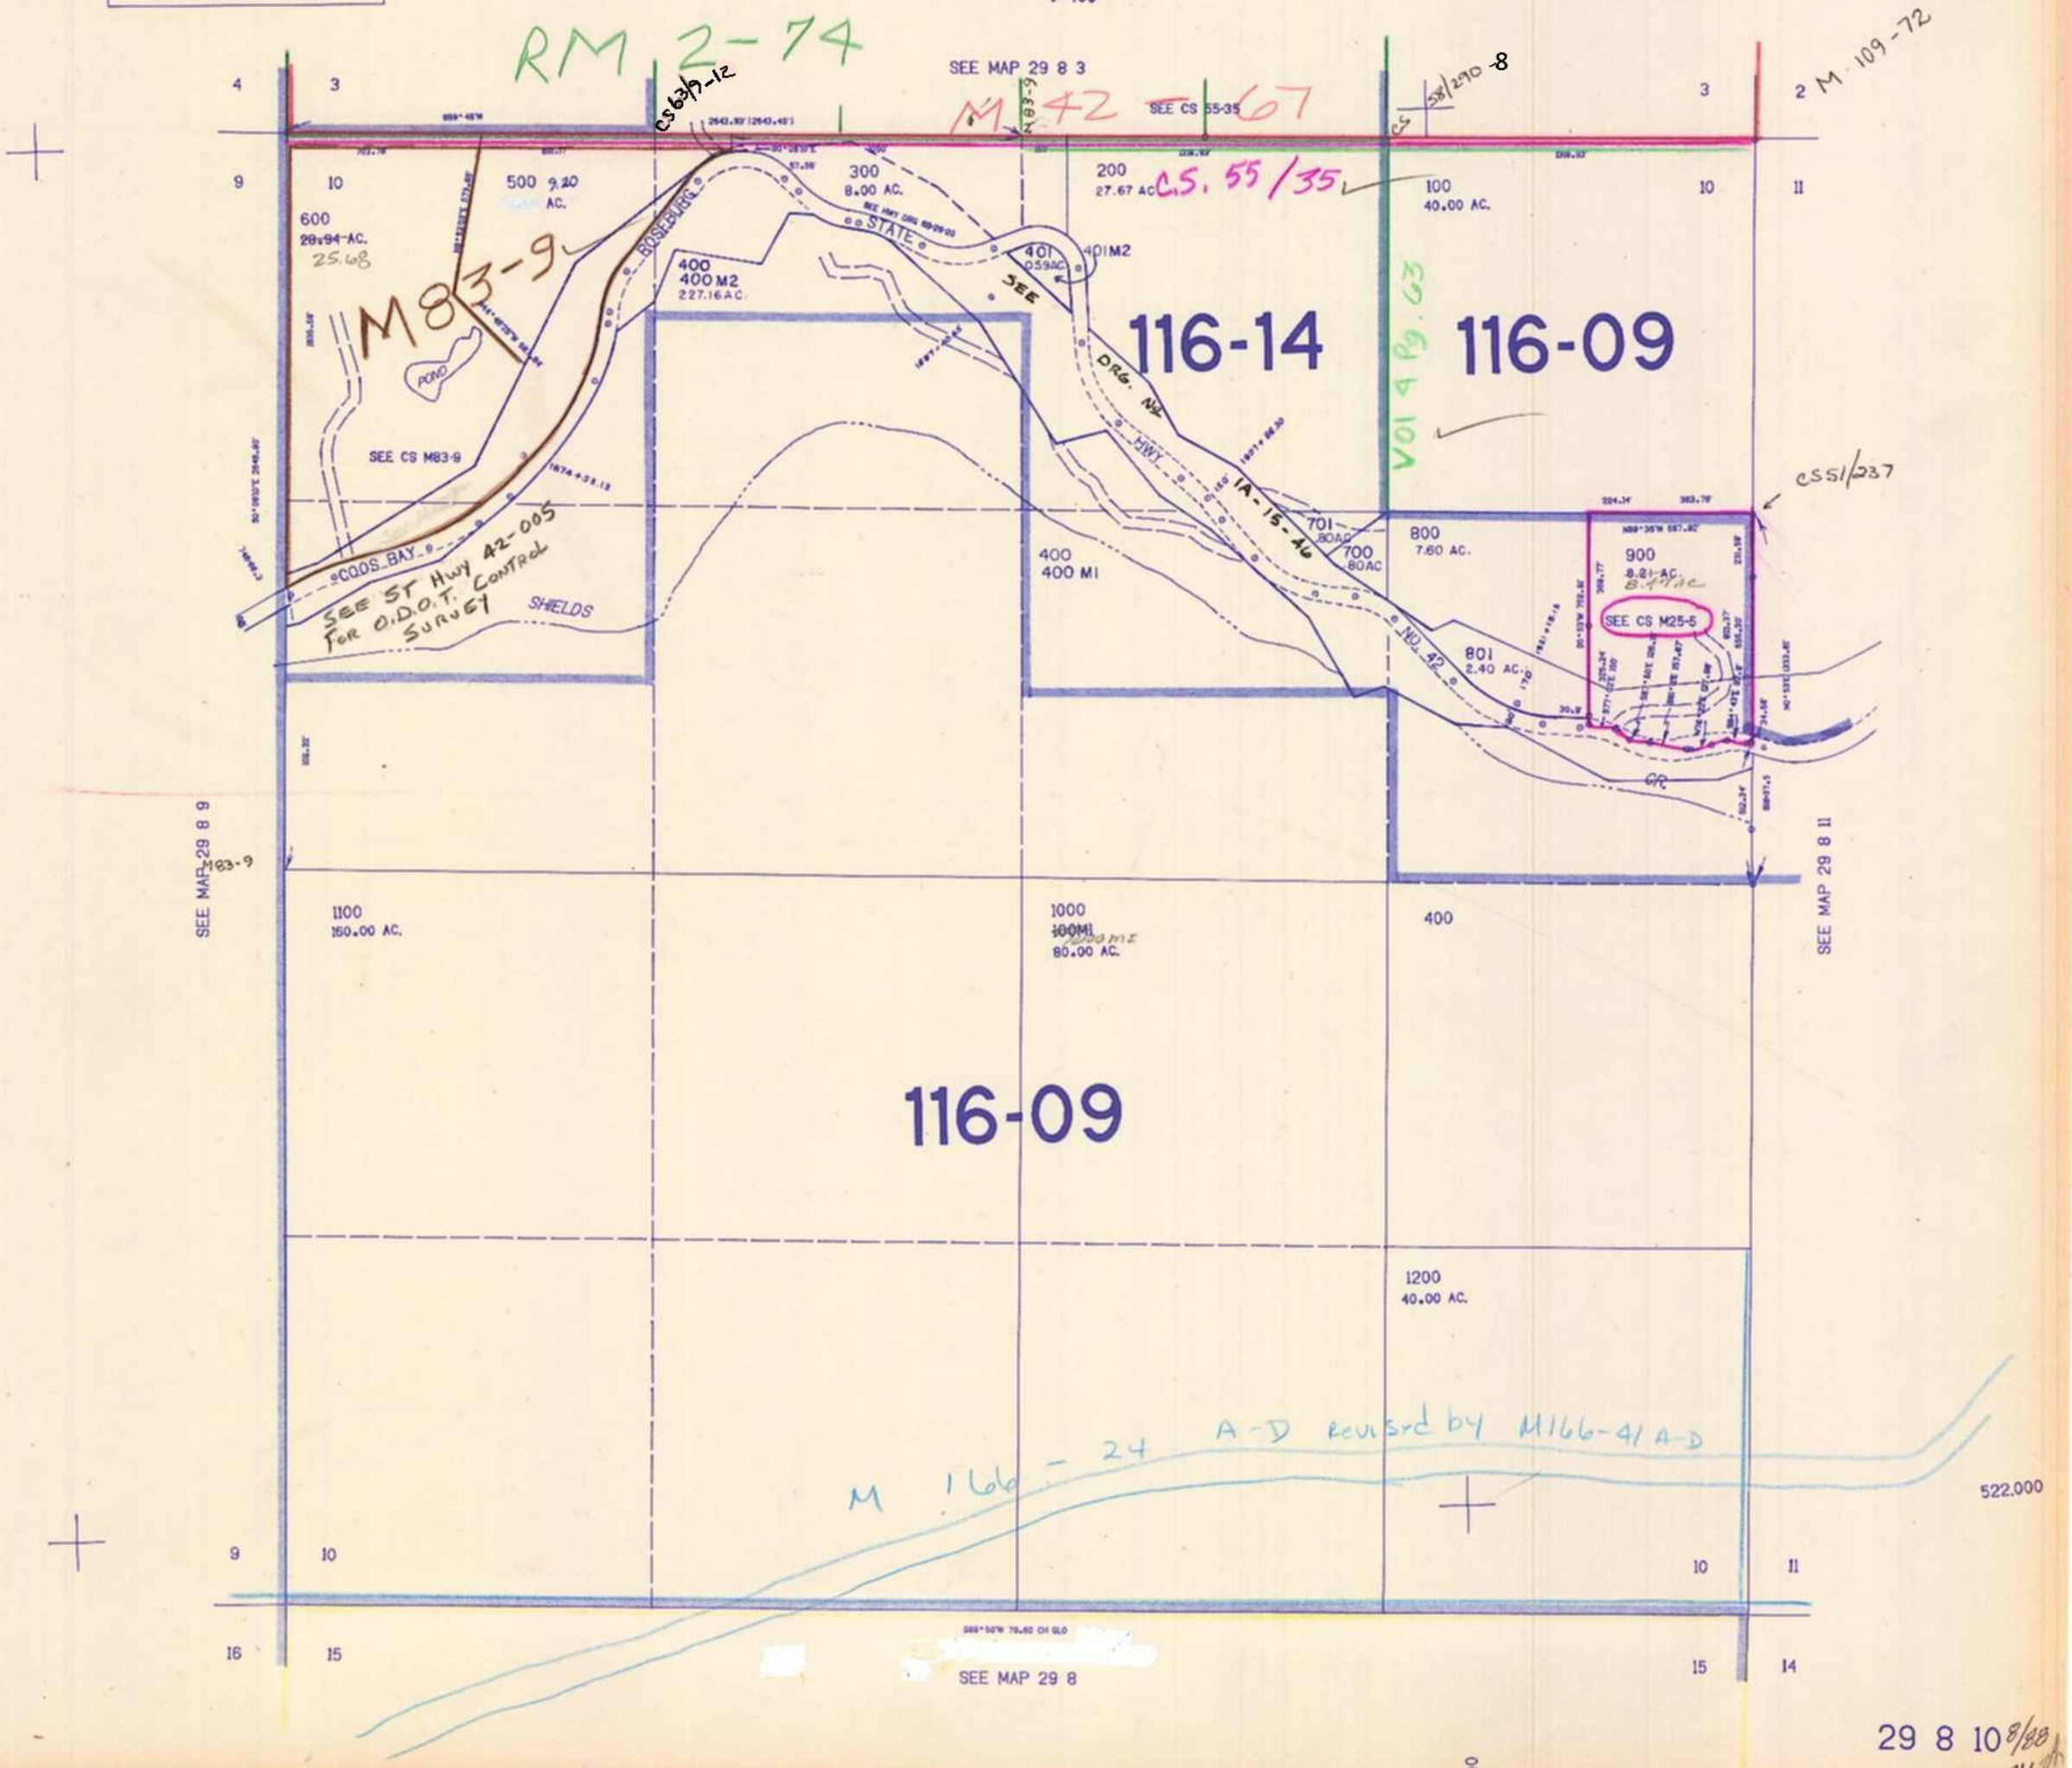
THIS MAP WAS PREPARED FOR ASSESSMENT PURPOSE ONLY.