SECTION 11 T.29S. R.8W. W.M.
DOUGLAS COUNTY

THIS MAP WAS PREPARED FOR ASSESSMENT PURPOSE ONLY.
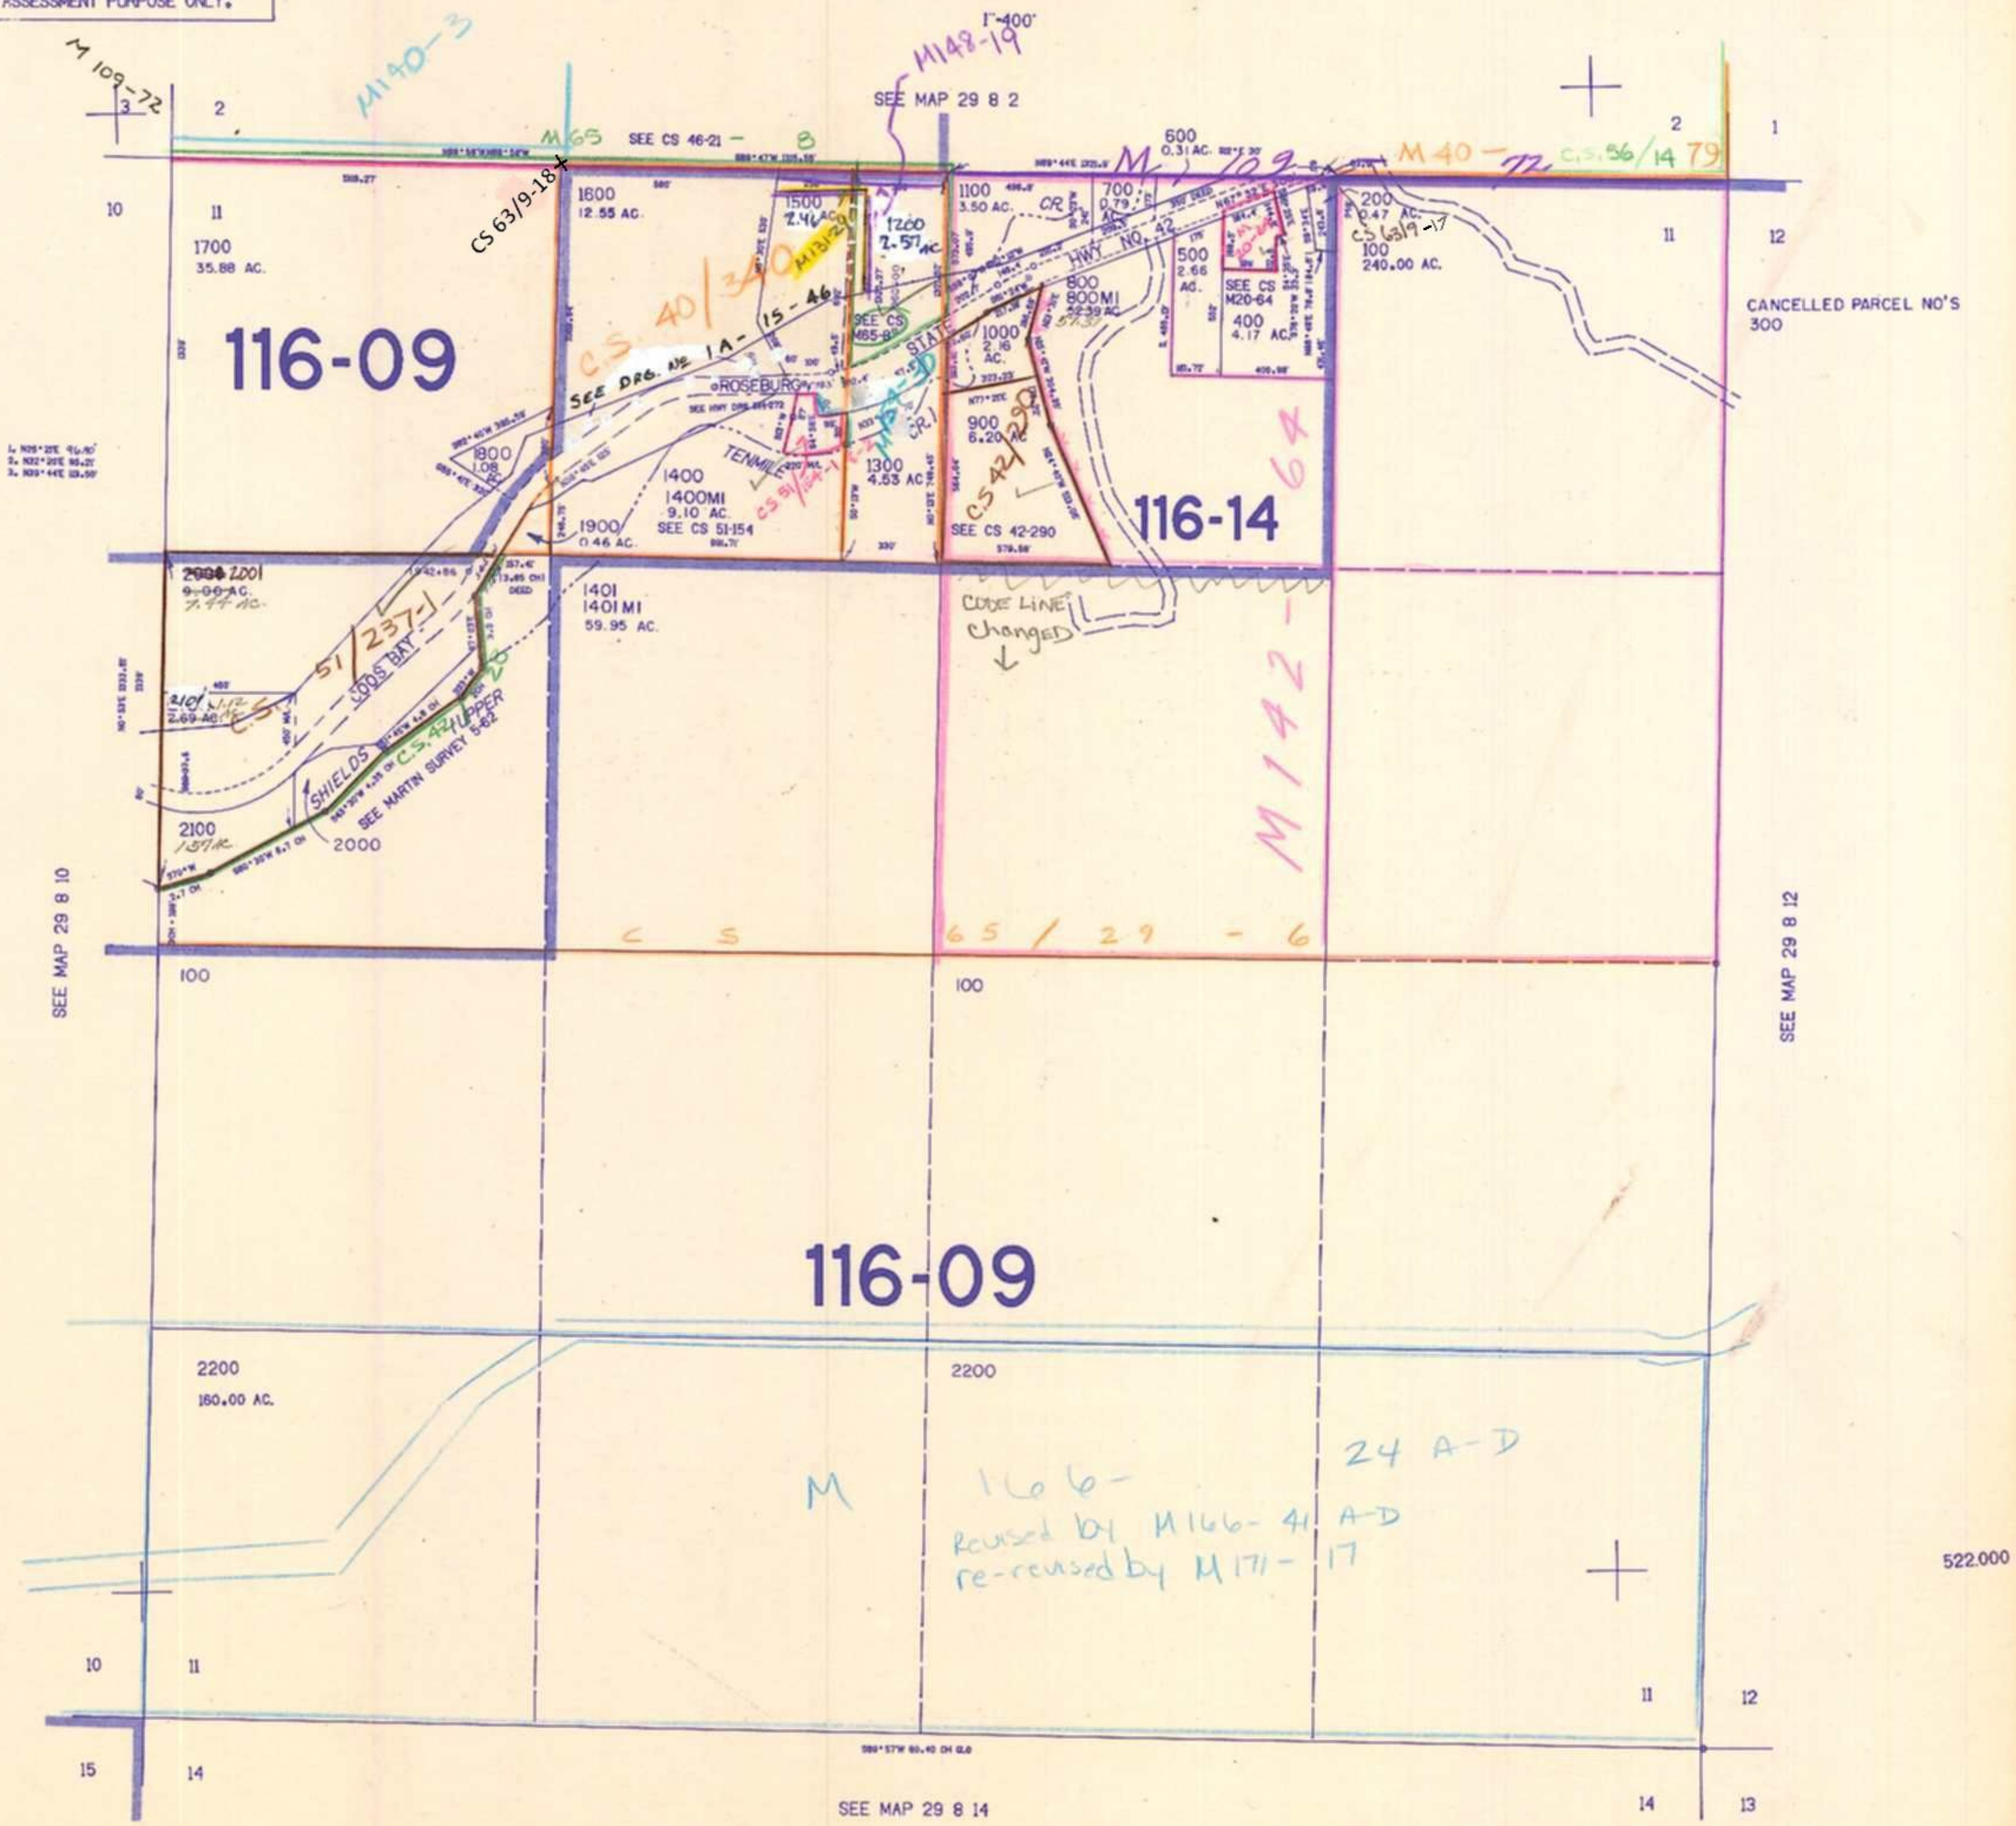
1"=400'