THIS MAP WAS PREPARED FOR ASSESSMENT PURPOSE ONLY.

SEC.16 T.29S. R.8W. W.M.
DOUGLAS COUNTY

1" = 400'

REVISED ON 3-6-08

29 8 16

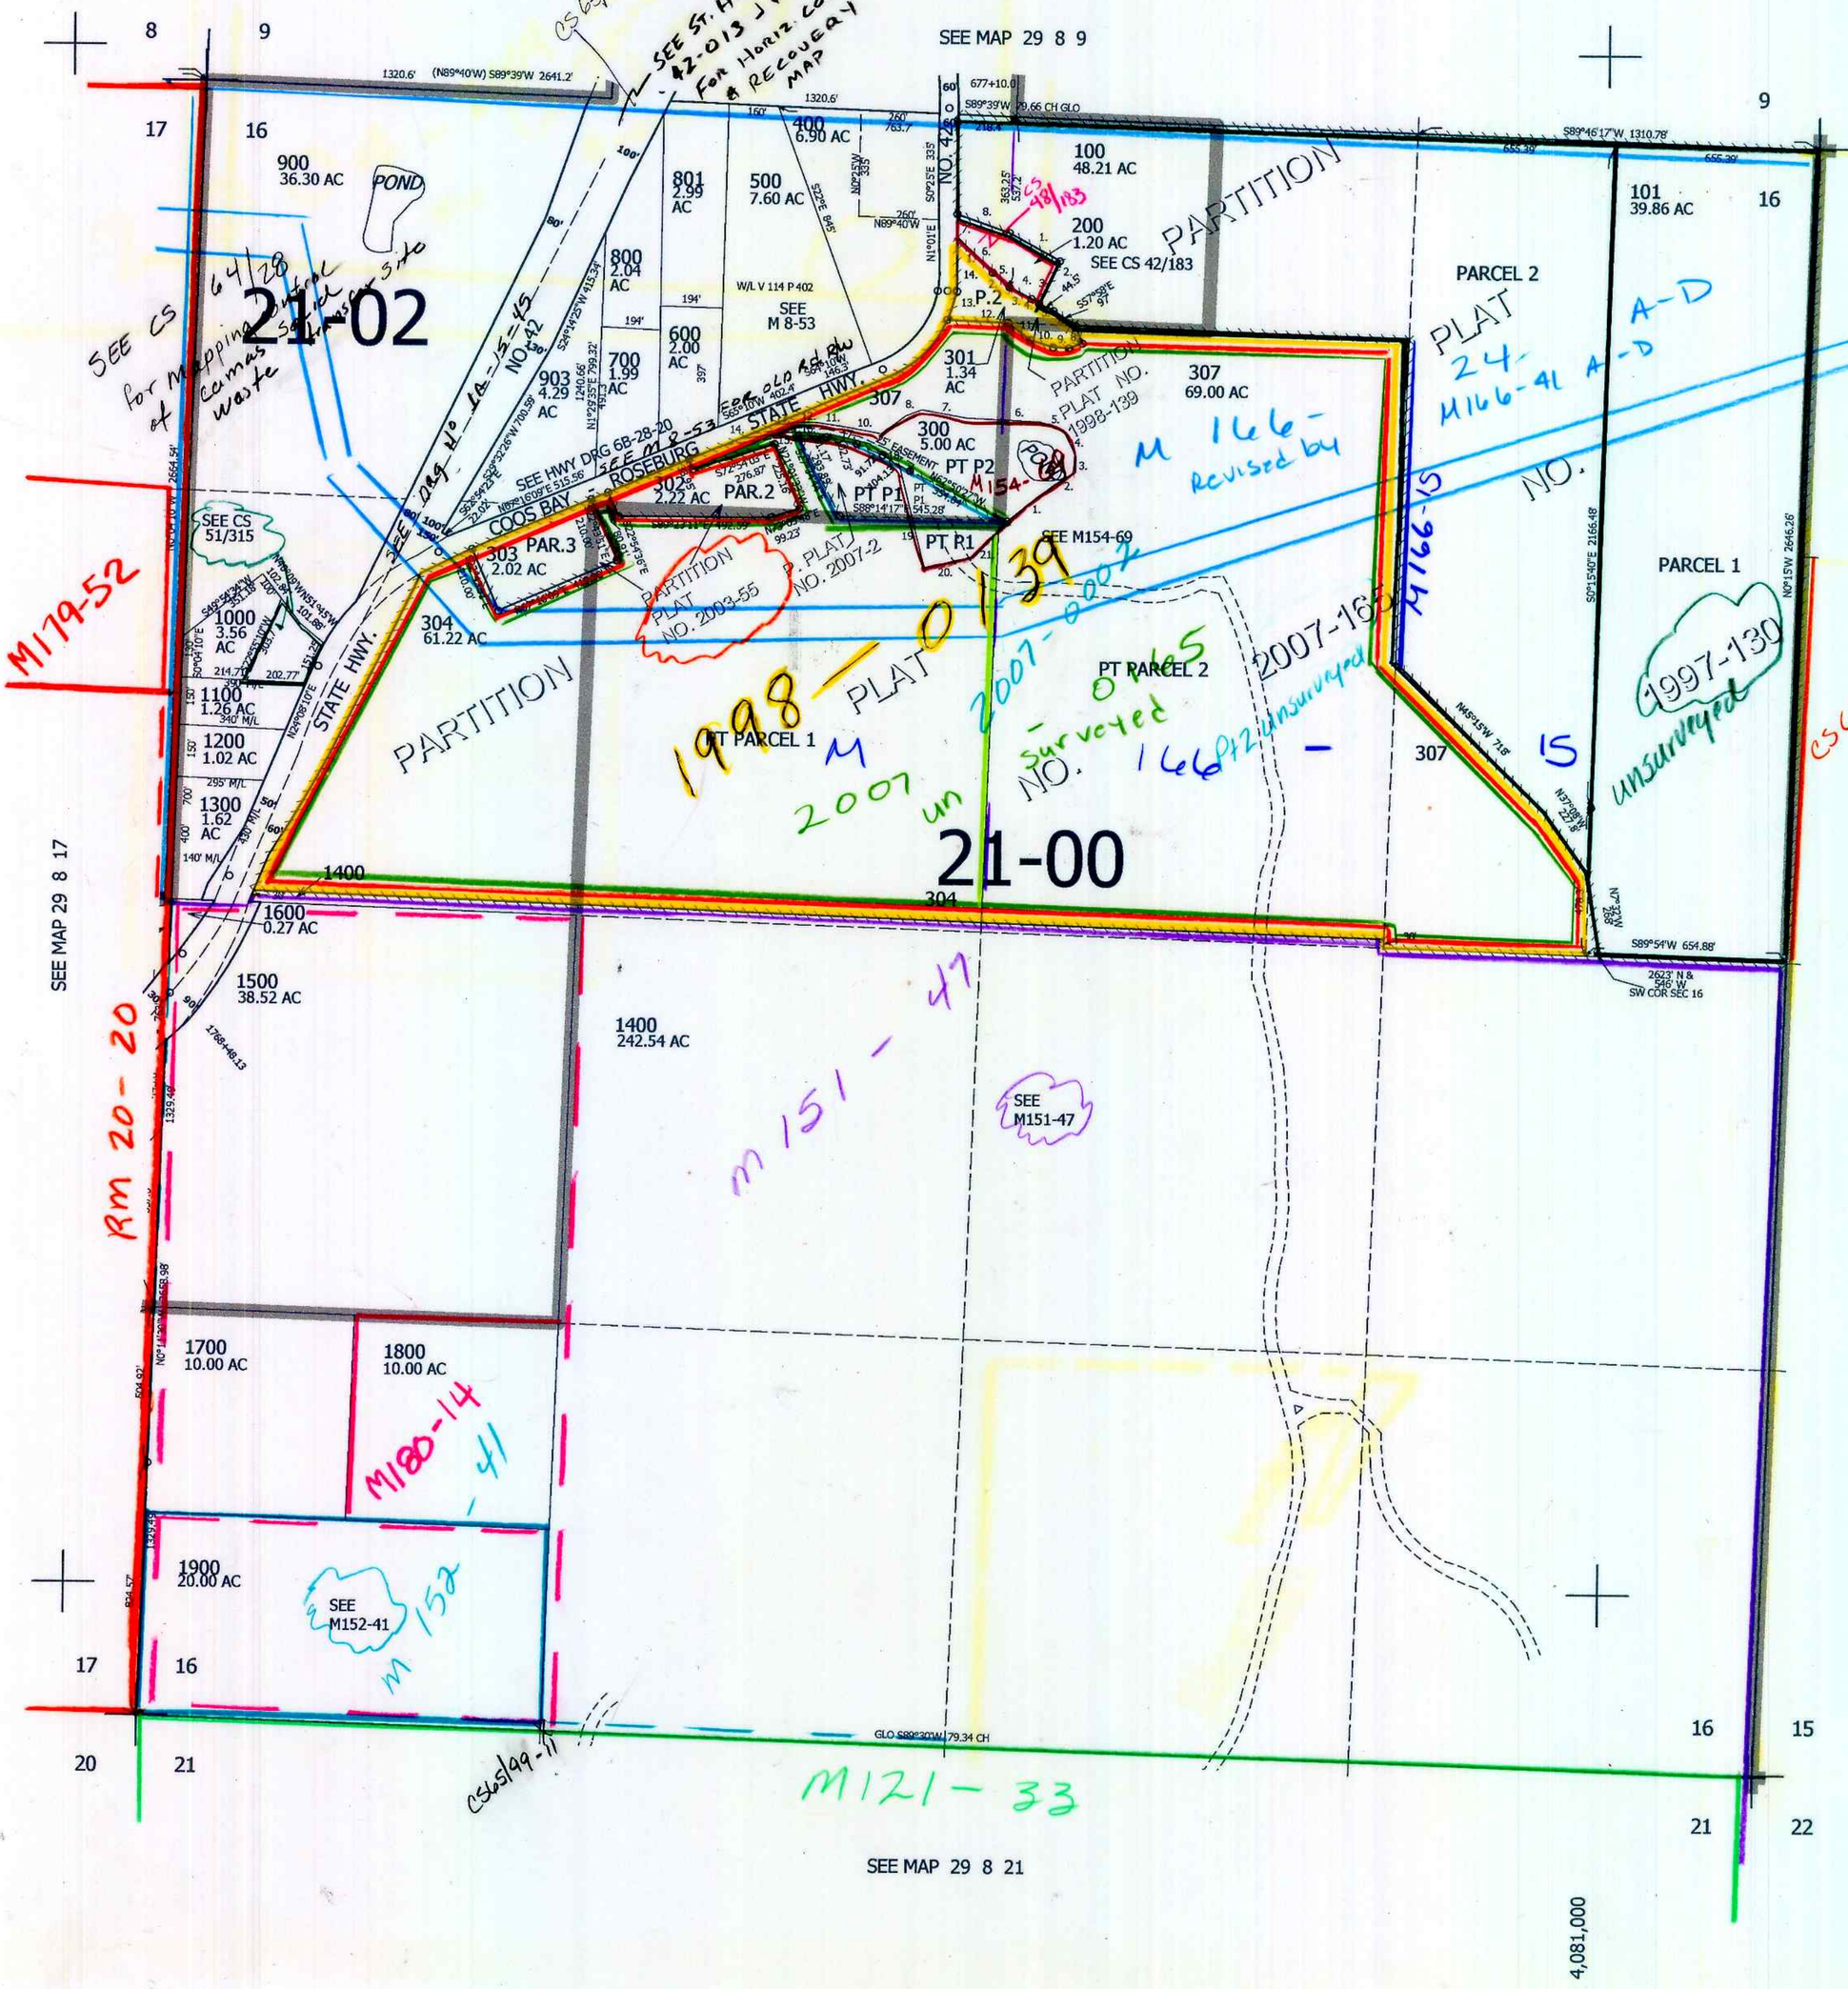

CANCELLED NO'S
901 902 100M1
101M1 300M1 300M2
300M3 600M1 700M1
800M1 801M1 1400M1
1400M2 1400M3 1400M4
1900M1 305 306

PARCEL 200
1. S62°30'E 188'
2. S24°30'W 151'
3. N60°W 33.8'
4. N66°30'W 81.3'
5. S57°41'E 54.7'
6. S43°59'E 155.7'
7. N0°30'E 76.4'
8. S74°30'E 165.4'

PARCEL 301
1. S43°59'00"E 155.7'
2. S57°30'00"E 54.64'
3. S66°31'00"E 81.3'
4. S62°49'00"E 34.13'
5. S62°49'00"E 49.67'
6. S57°58'00"E 97'
7. S17°28'26"E 52.94'
8. S66°28'08"W 46.58'
9. S89°52'43"W 51.7'
10. N76°50'35"W 76.45'
11. N56°17'12"W 187.34'
12. WEST 187.34'
13. N17°35'00"E 99.3'
14. N1°01'00"E 168.5'

PARCEL 300
1. N51°57'50"E 193.61'
2. N59°28'58"E 79.99'
3. N0°02'37"W 55.26'
4. N25°11'25"W 89.11'
5. N71°11'40"W 83.26'
6. N87°17'35"W 240.37'
7. N79°55'23"W 147.14'
8. S68°45'13"W 56.77'
9. S52°40'20"W 97.54'
10. N79°16'24"W 120.7'
11. N82°00'47"W 92.38'
12. N88°17'35"W 59.02'
13. S82°26'58"W 108.85'
14. S66°45'29"W 114.45'
15. N82°22'07"E 201.34'
16. S86°45'55"E 114.32'
17. S77°15'52"E 131.95'
18. S52°17'03"E 127.74'
19. S13°59'23"E 335.92'
20. N76°56'59"E 164.94'
21. N42°21'42"E 159.75'

JCV
CM 9/5/07

29 8 16