THIS MAP WAS PREPARED FOR ASSESSMENT PURPOSE ONLY.

T.29S. R.9W. W.M.
DOUGLAS COUNTY COOS COUNTY

29 9 & INDEX

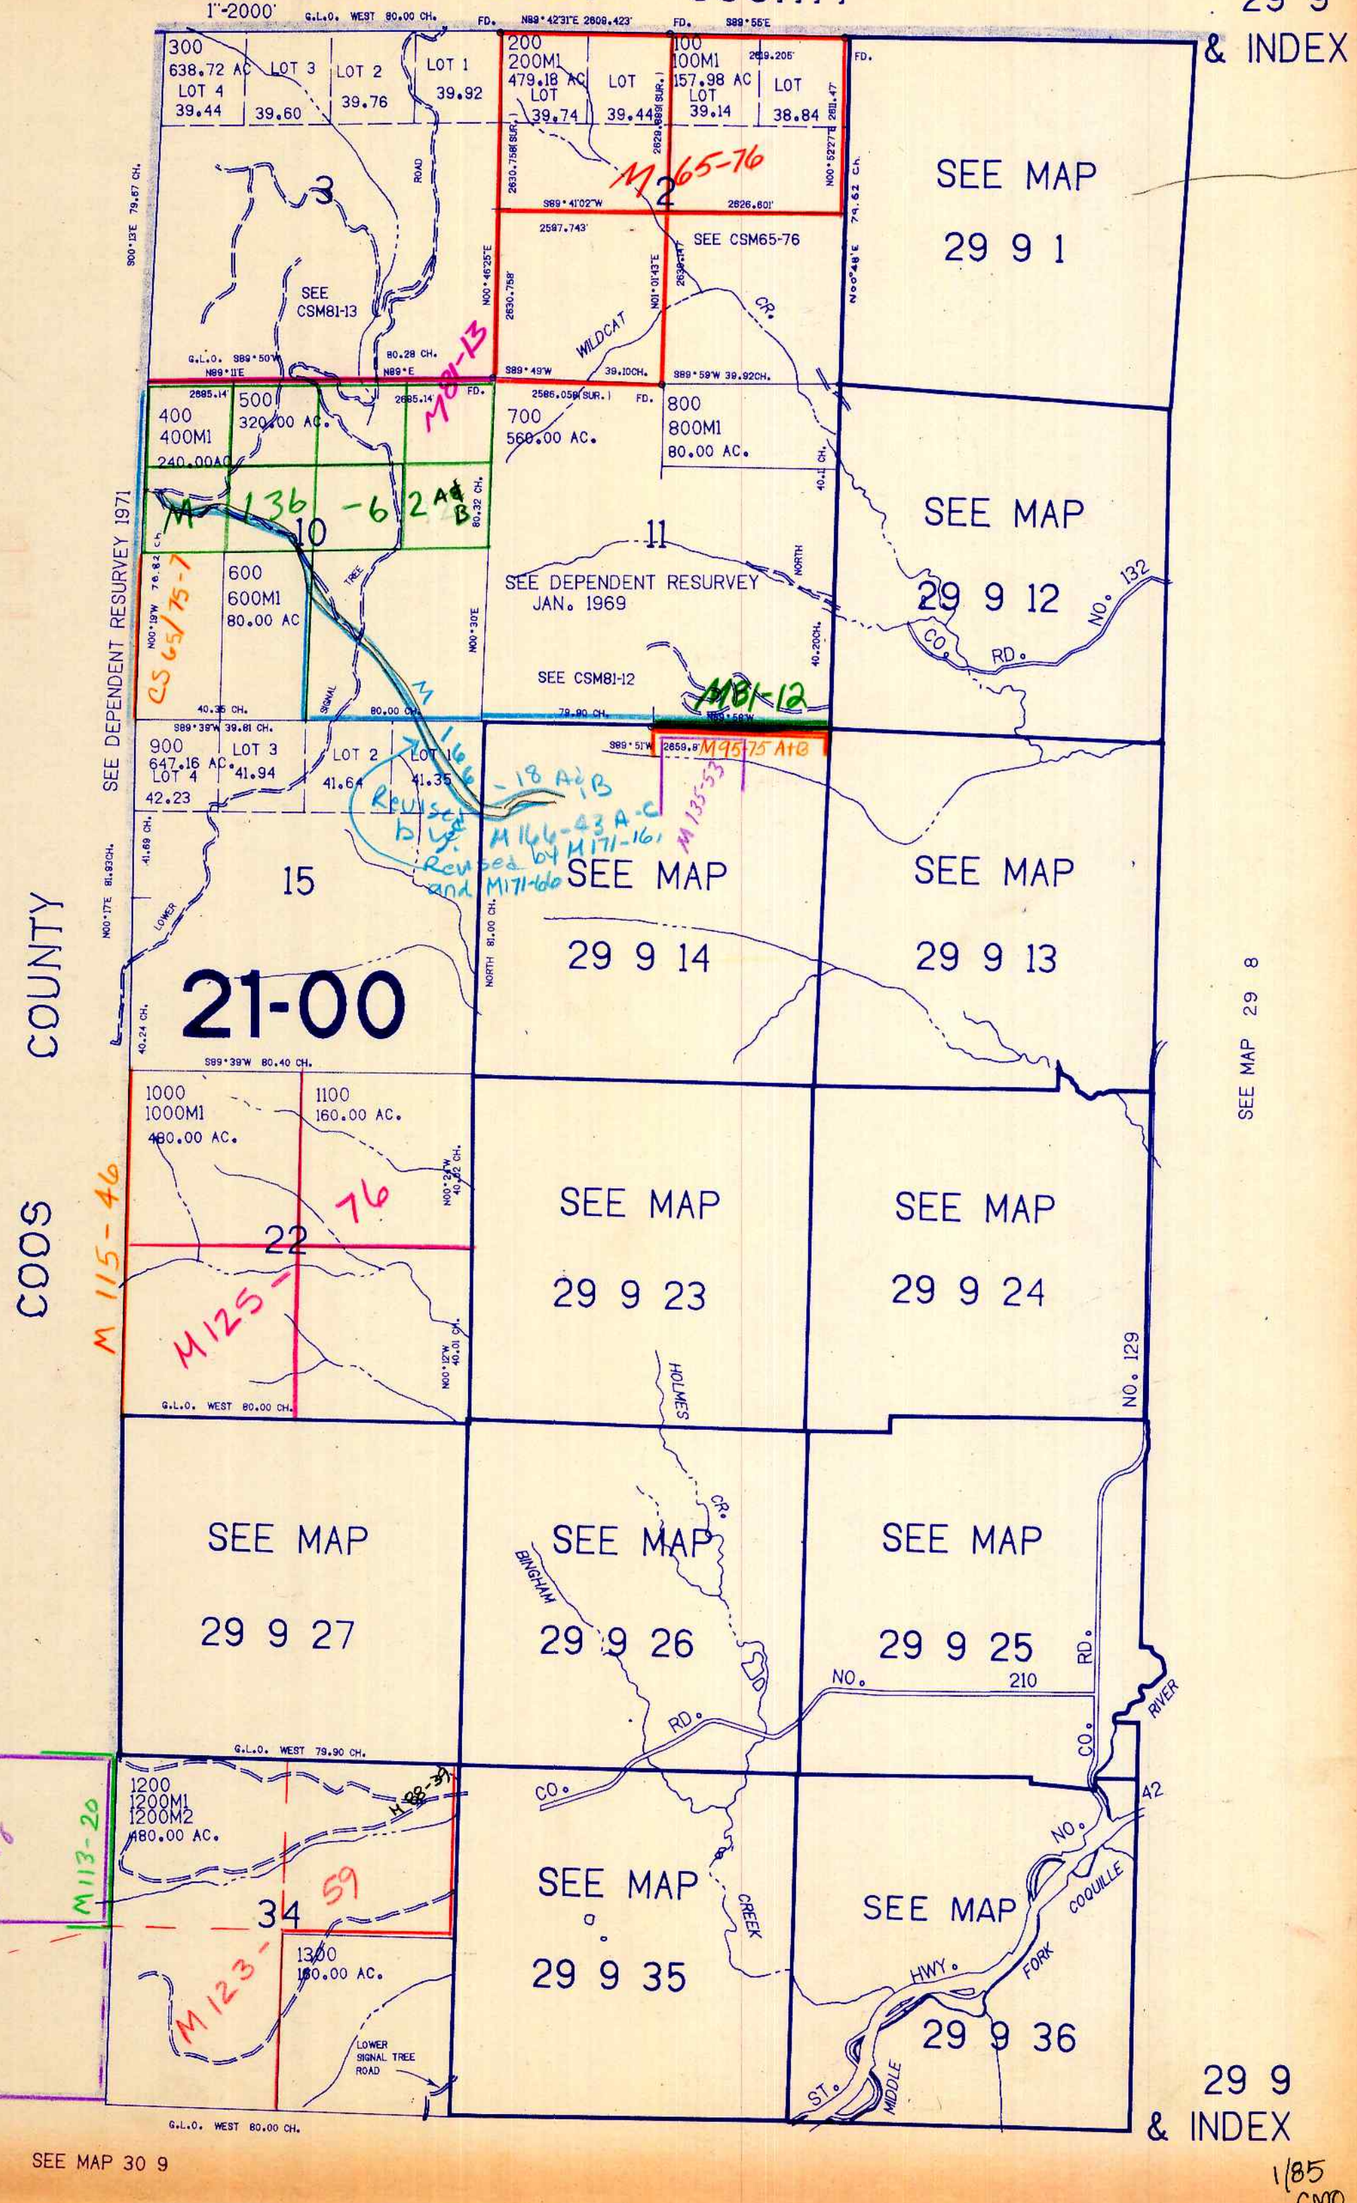

29 9 & INDEX

1/85 CMD