THIS MAP WAS PREPARED FOR ASSESSMENT PURPOSE ONLY.

Upper Left:
123°43'38"W 43°4'16"N
4059210E 528403N ft

SEC.12 T.29S. R.09W. W.M.
DOUGLAS COUNTY
1" =400'

Date Exported 2025-07-10

290912

CANCELLED NOS:
400 900 300 1801 1400A1
701 500 700
801

PARCEL 1401
1. N63°44'15"E 22.82'
2. N28°34'40"W 42.9'
3. S81°58'25"W 73.77'
4. S74°16'09"W 123.38'
5. S63°34'W 54.76'
6. S44°45'08"W 71.68'
7. S27°06'32"W 52.26'
8. S3°58'18"W 81.42'
9. S9°33'09"E 122.09'
10. S11°20'20"W 127.04'
11. S89°26'07"E 25.45'

PARCEL 1500 & 1501
P.O.B. BEARS EAST 21.55'
FROM SW COR SEC 29 PER M131-10
1. N30°32'43"E 99.48'
2. N69°29'43"E 57.67'
3. S68°18'17"E 155.54'
4. S71°43'17"E 135.57'
5. N86°05'43"E 165.26'
6. N87°53'43"E 93.86'
7. N67°47'43"E 34.59'
8. S0°31'W 39.67'
9. N67°47'43"E 100'
10. N36°37'43"E 155.13
11. N41°15'43"E 109.21'
12. N9°49'17"W 137.96'
13. N5°10'43"E 88.49'
14. N12°13'17"W 125.93'
15. N26°49'43"E 166.38'
16. N0°55'43"E 313.9'
17. N7°07'43"E 231.71'

PARCEL 1000
1. S87°09'44"E 101.19'
2. N6°08'54"W 68.77'
3. N1°58'28"W 73.84'
4. N0°09'38"W 91.43'

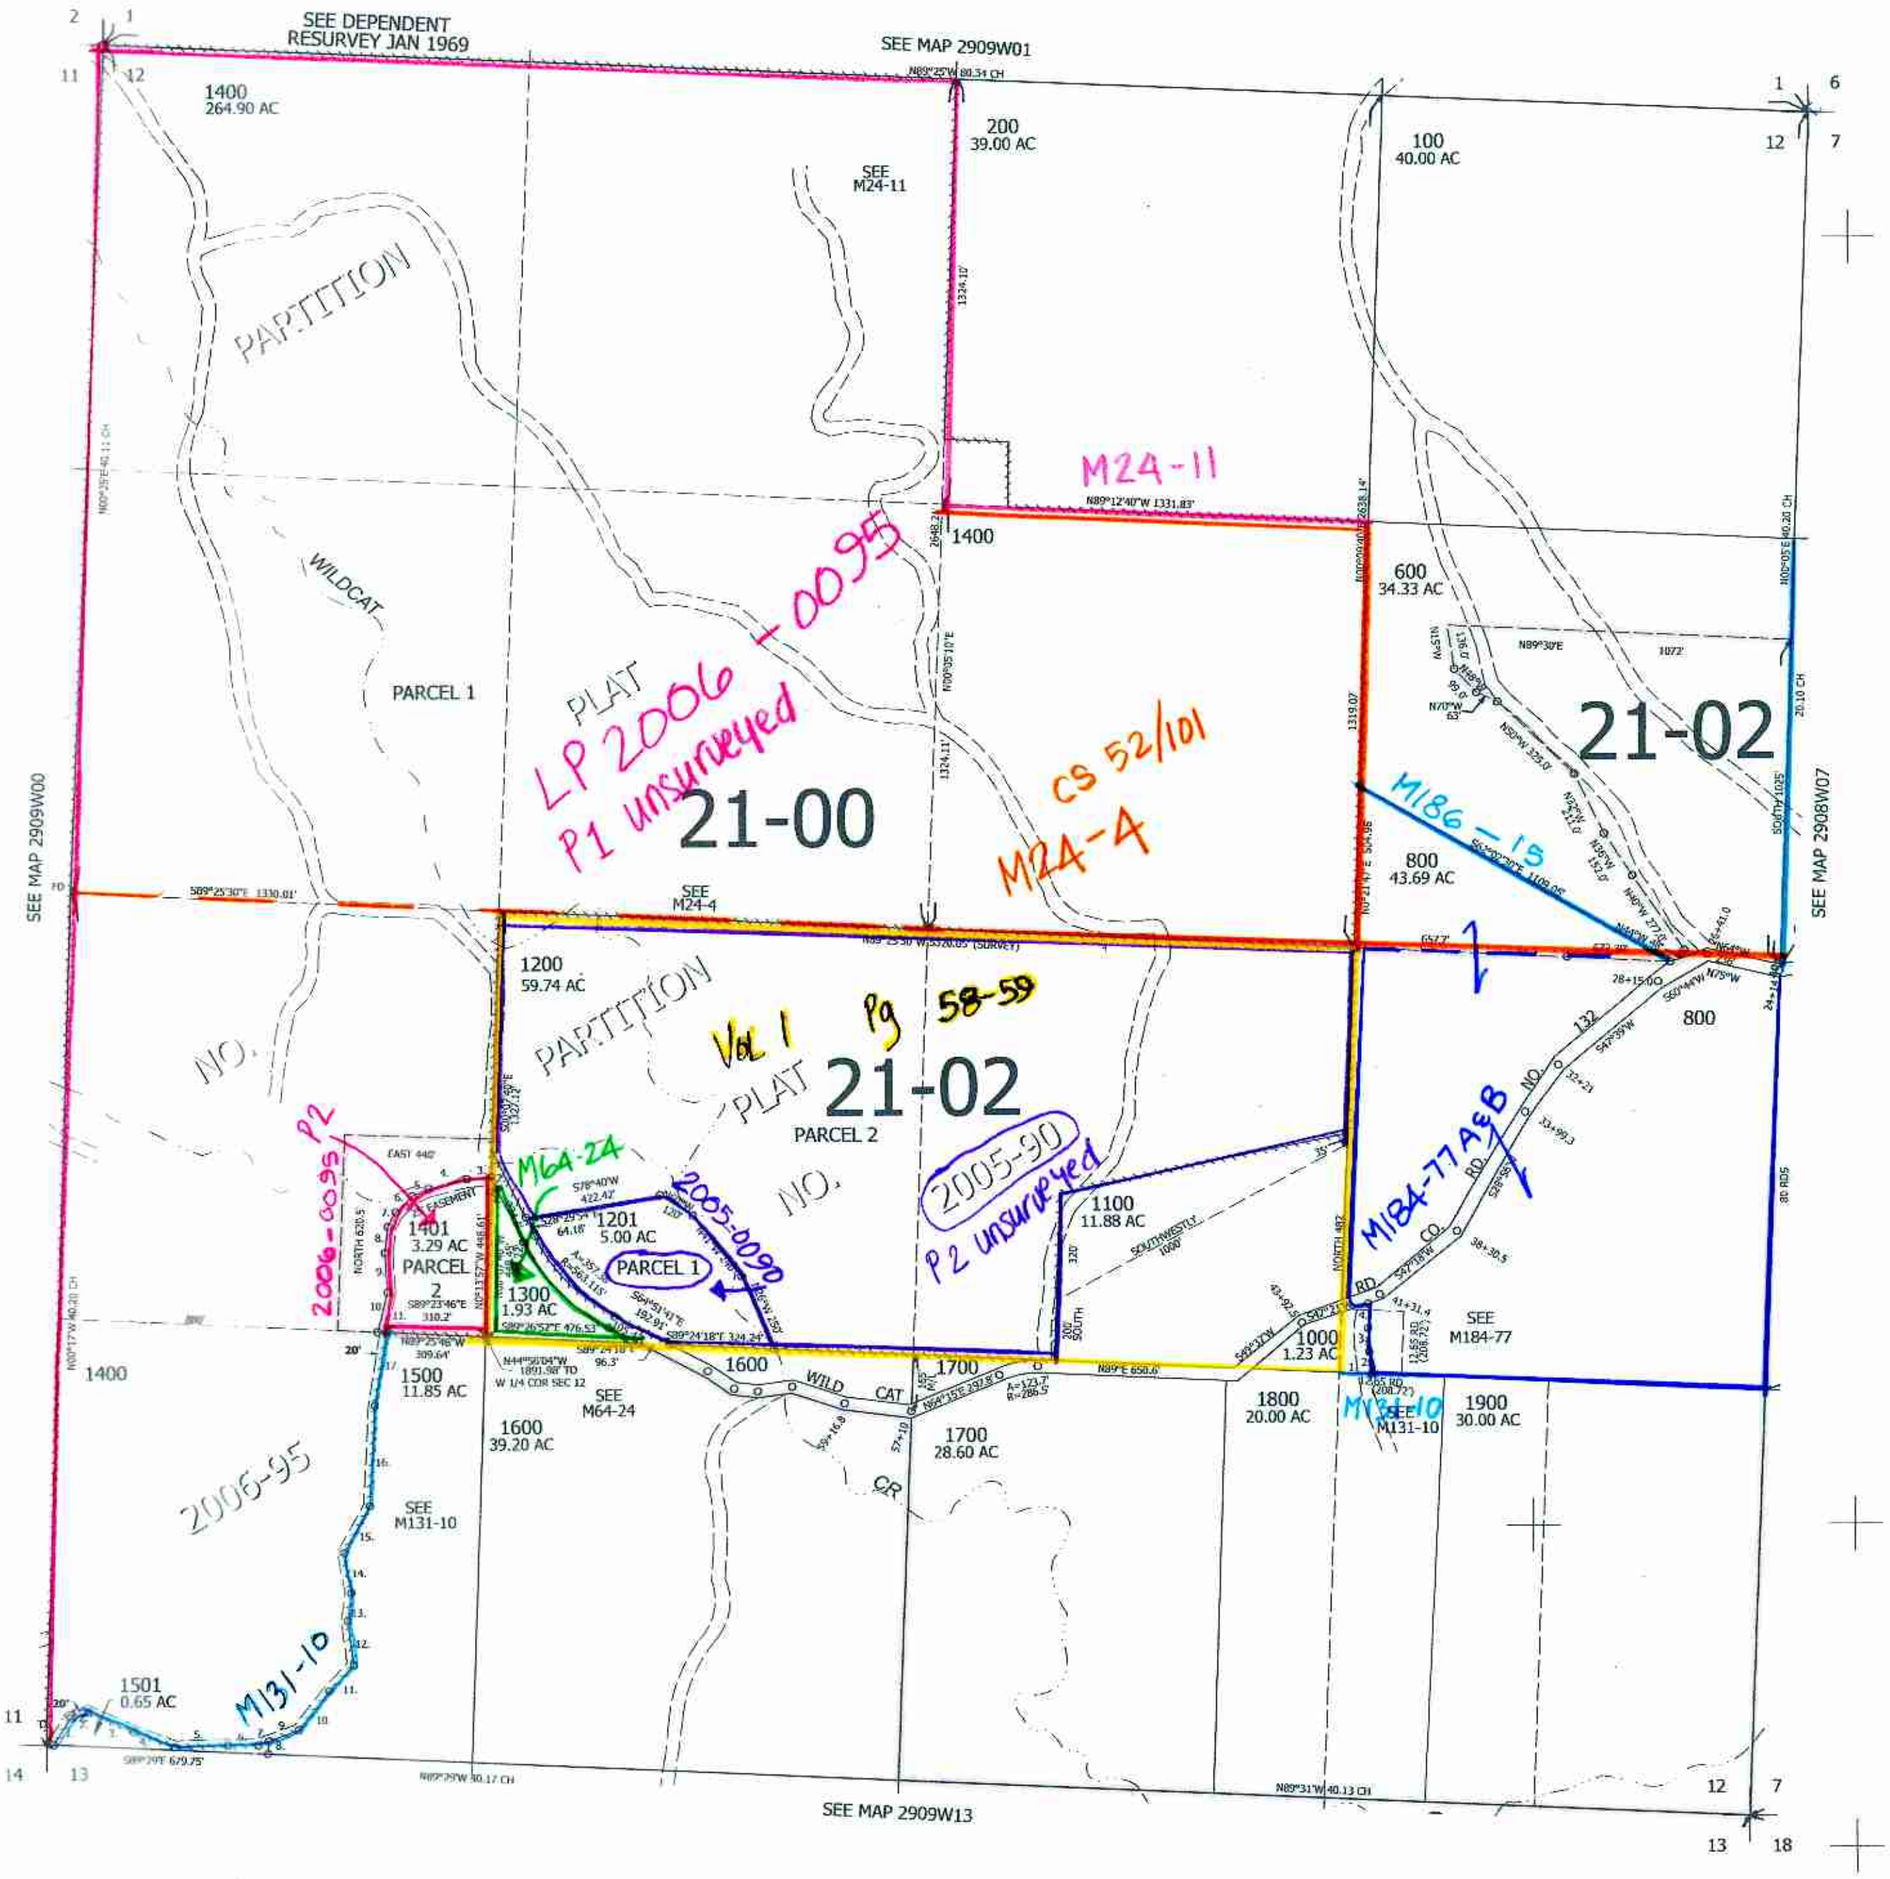

7/2025 BO
KE

290912

Lower Right:
123°41'49"W 43°3'10"N
4067060E 521448N ft