


NW1/4 SEC. 18 T.30S. R.1W. W.M.
DOUGLAS COUNTY

30 1 18B
REVISED: 3-14-91

THIS MAP WAS PREPARED FOR
ASSESSMENT PURPOSE ONLY.

1"=200'

SEE MAP 30 1 7

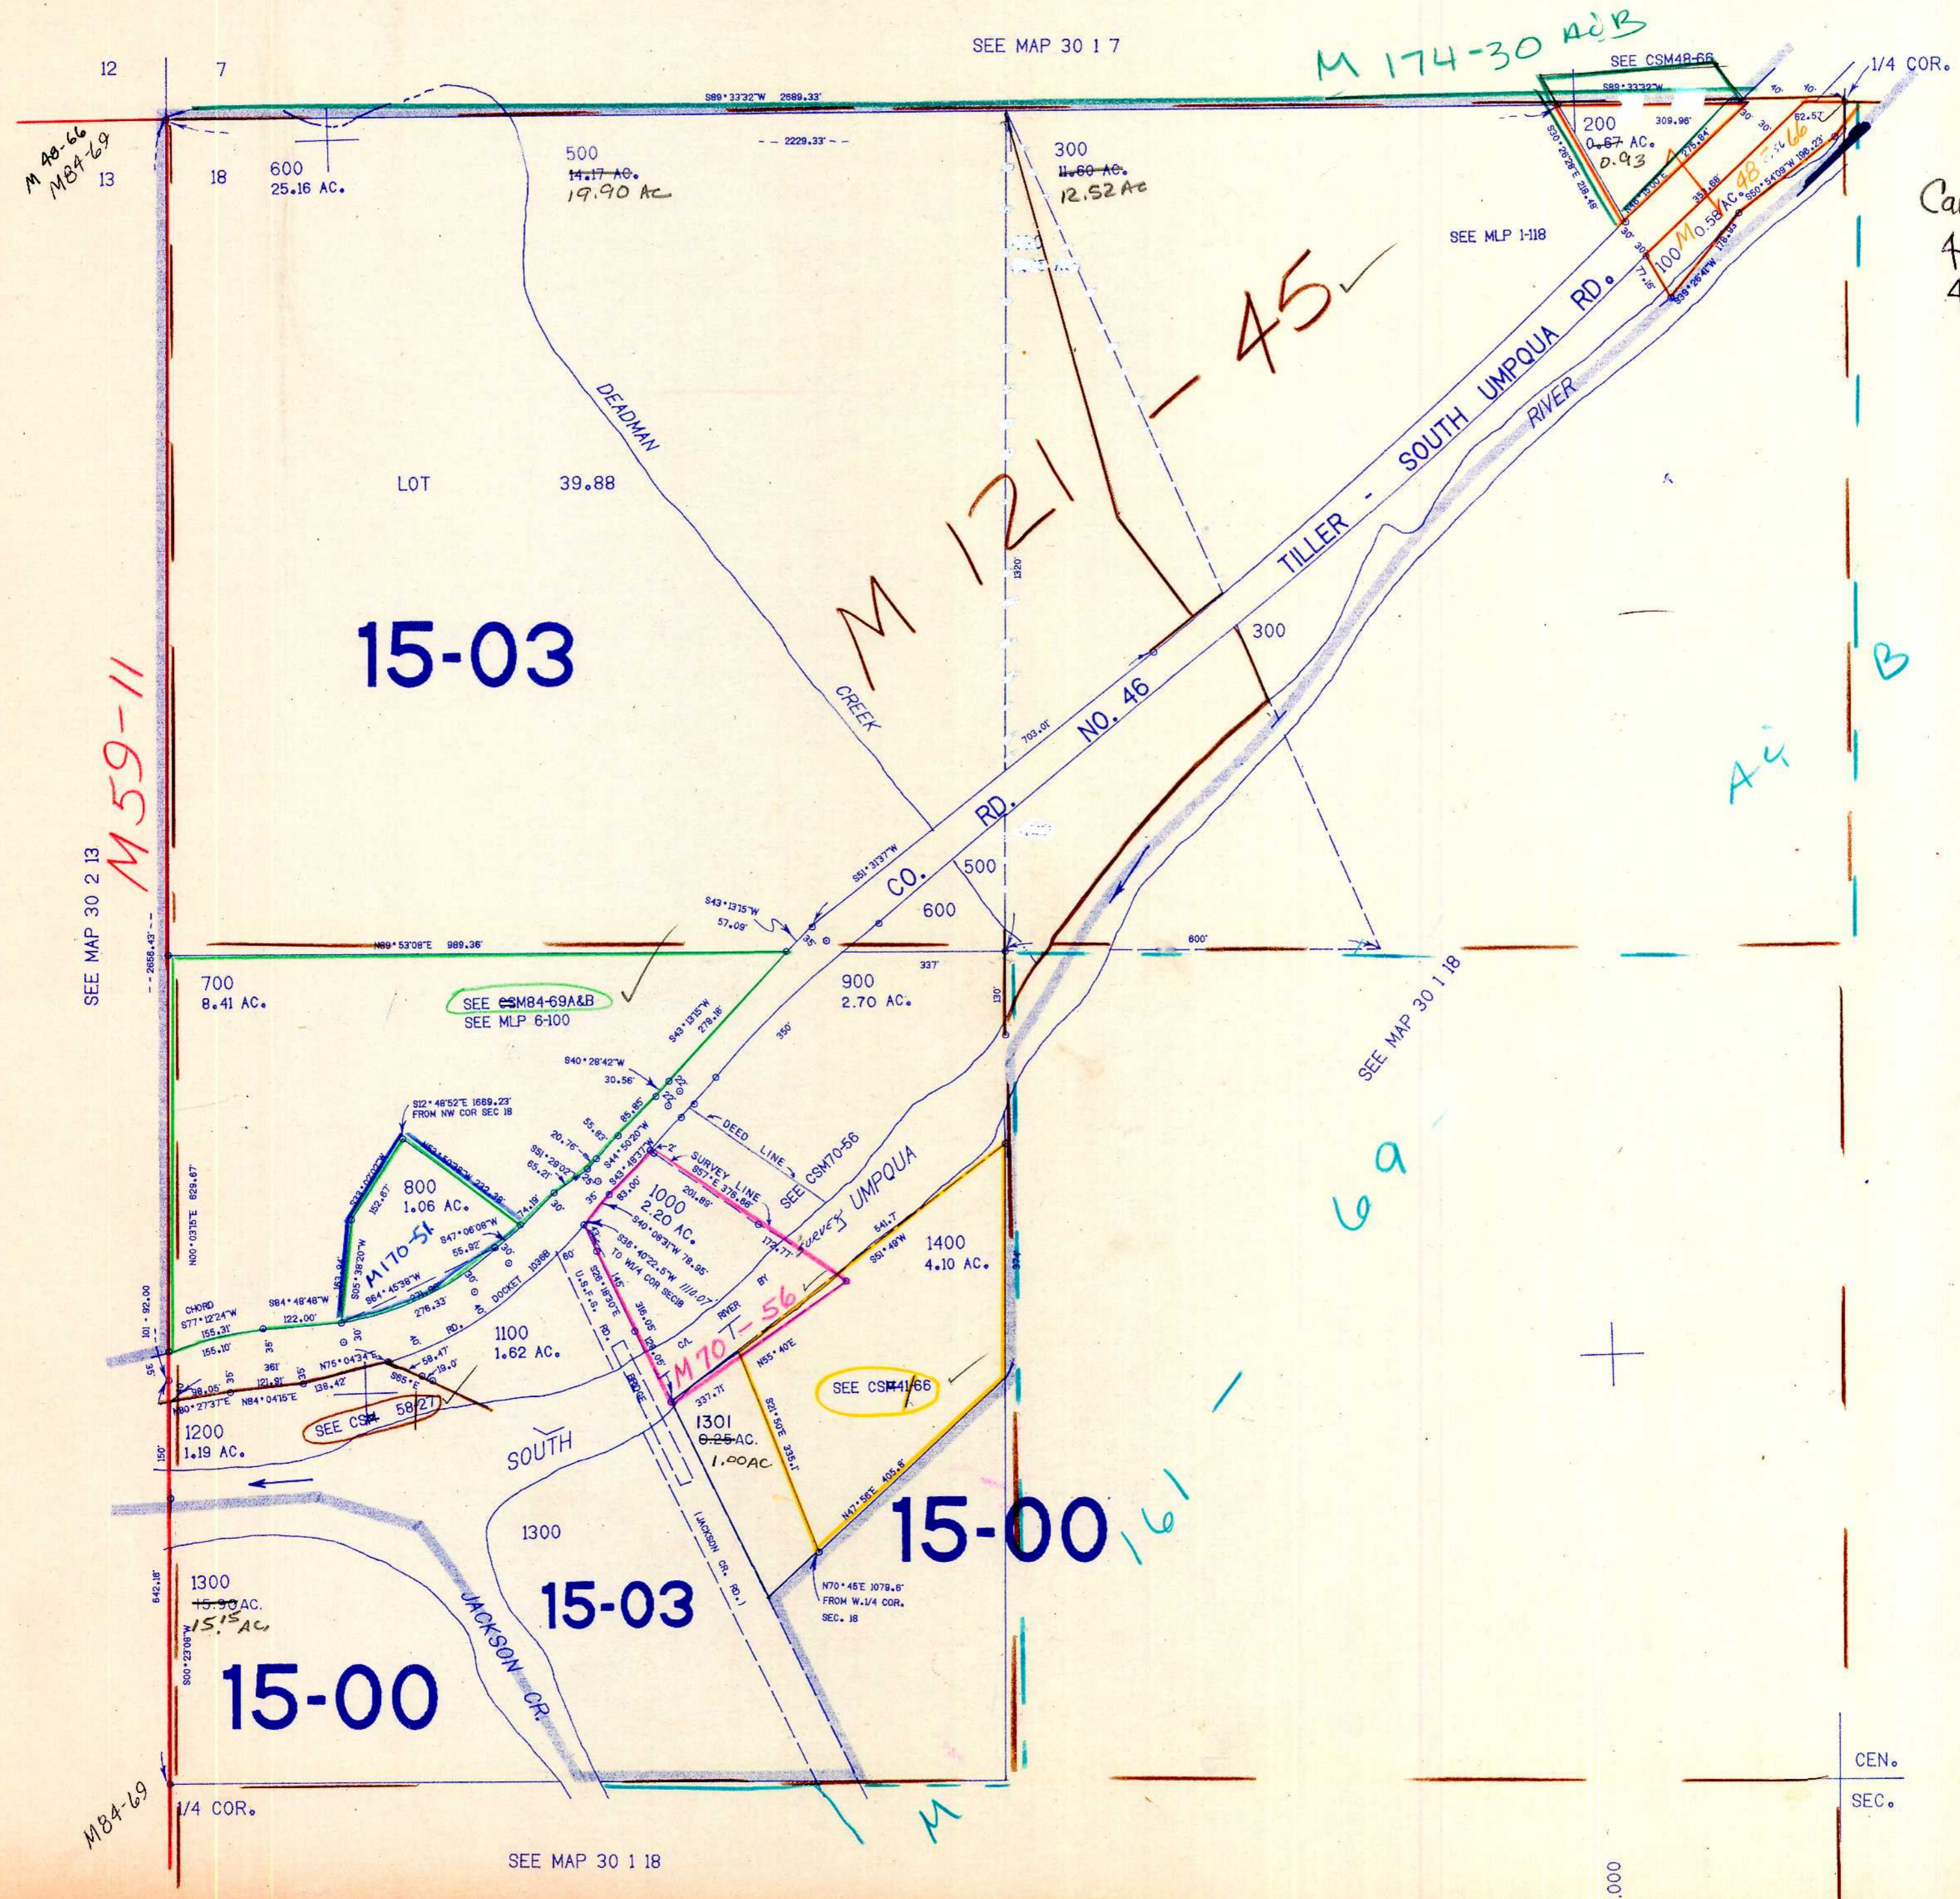

Cancelled Nos
400
401

484.000

1.365,000

30 1 18B

31/91
JMK