


SECTION 22 T.30S. R.2W. W.M.
DOUGLAS COUNTY

30 2 22

1" = 400'

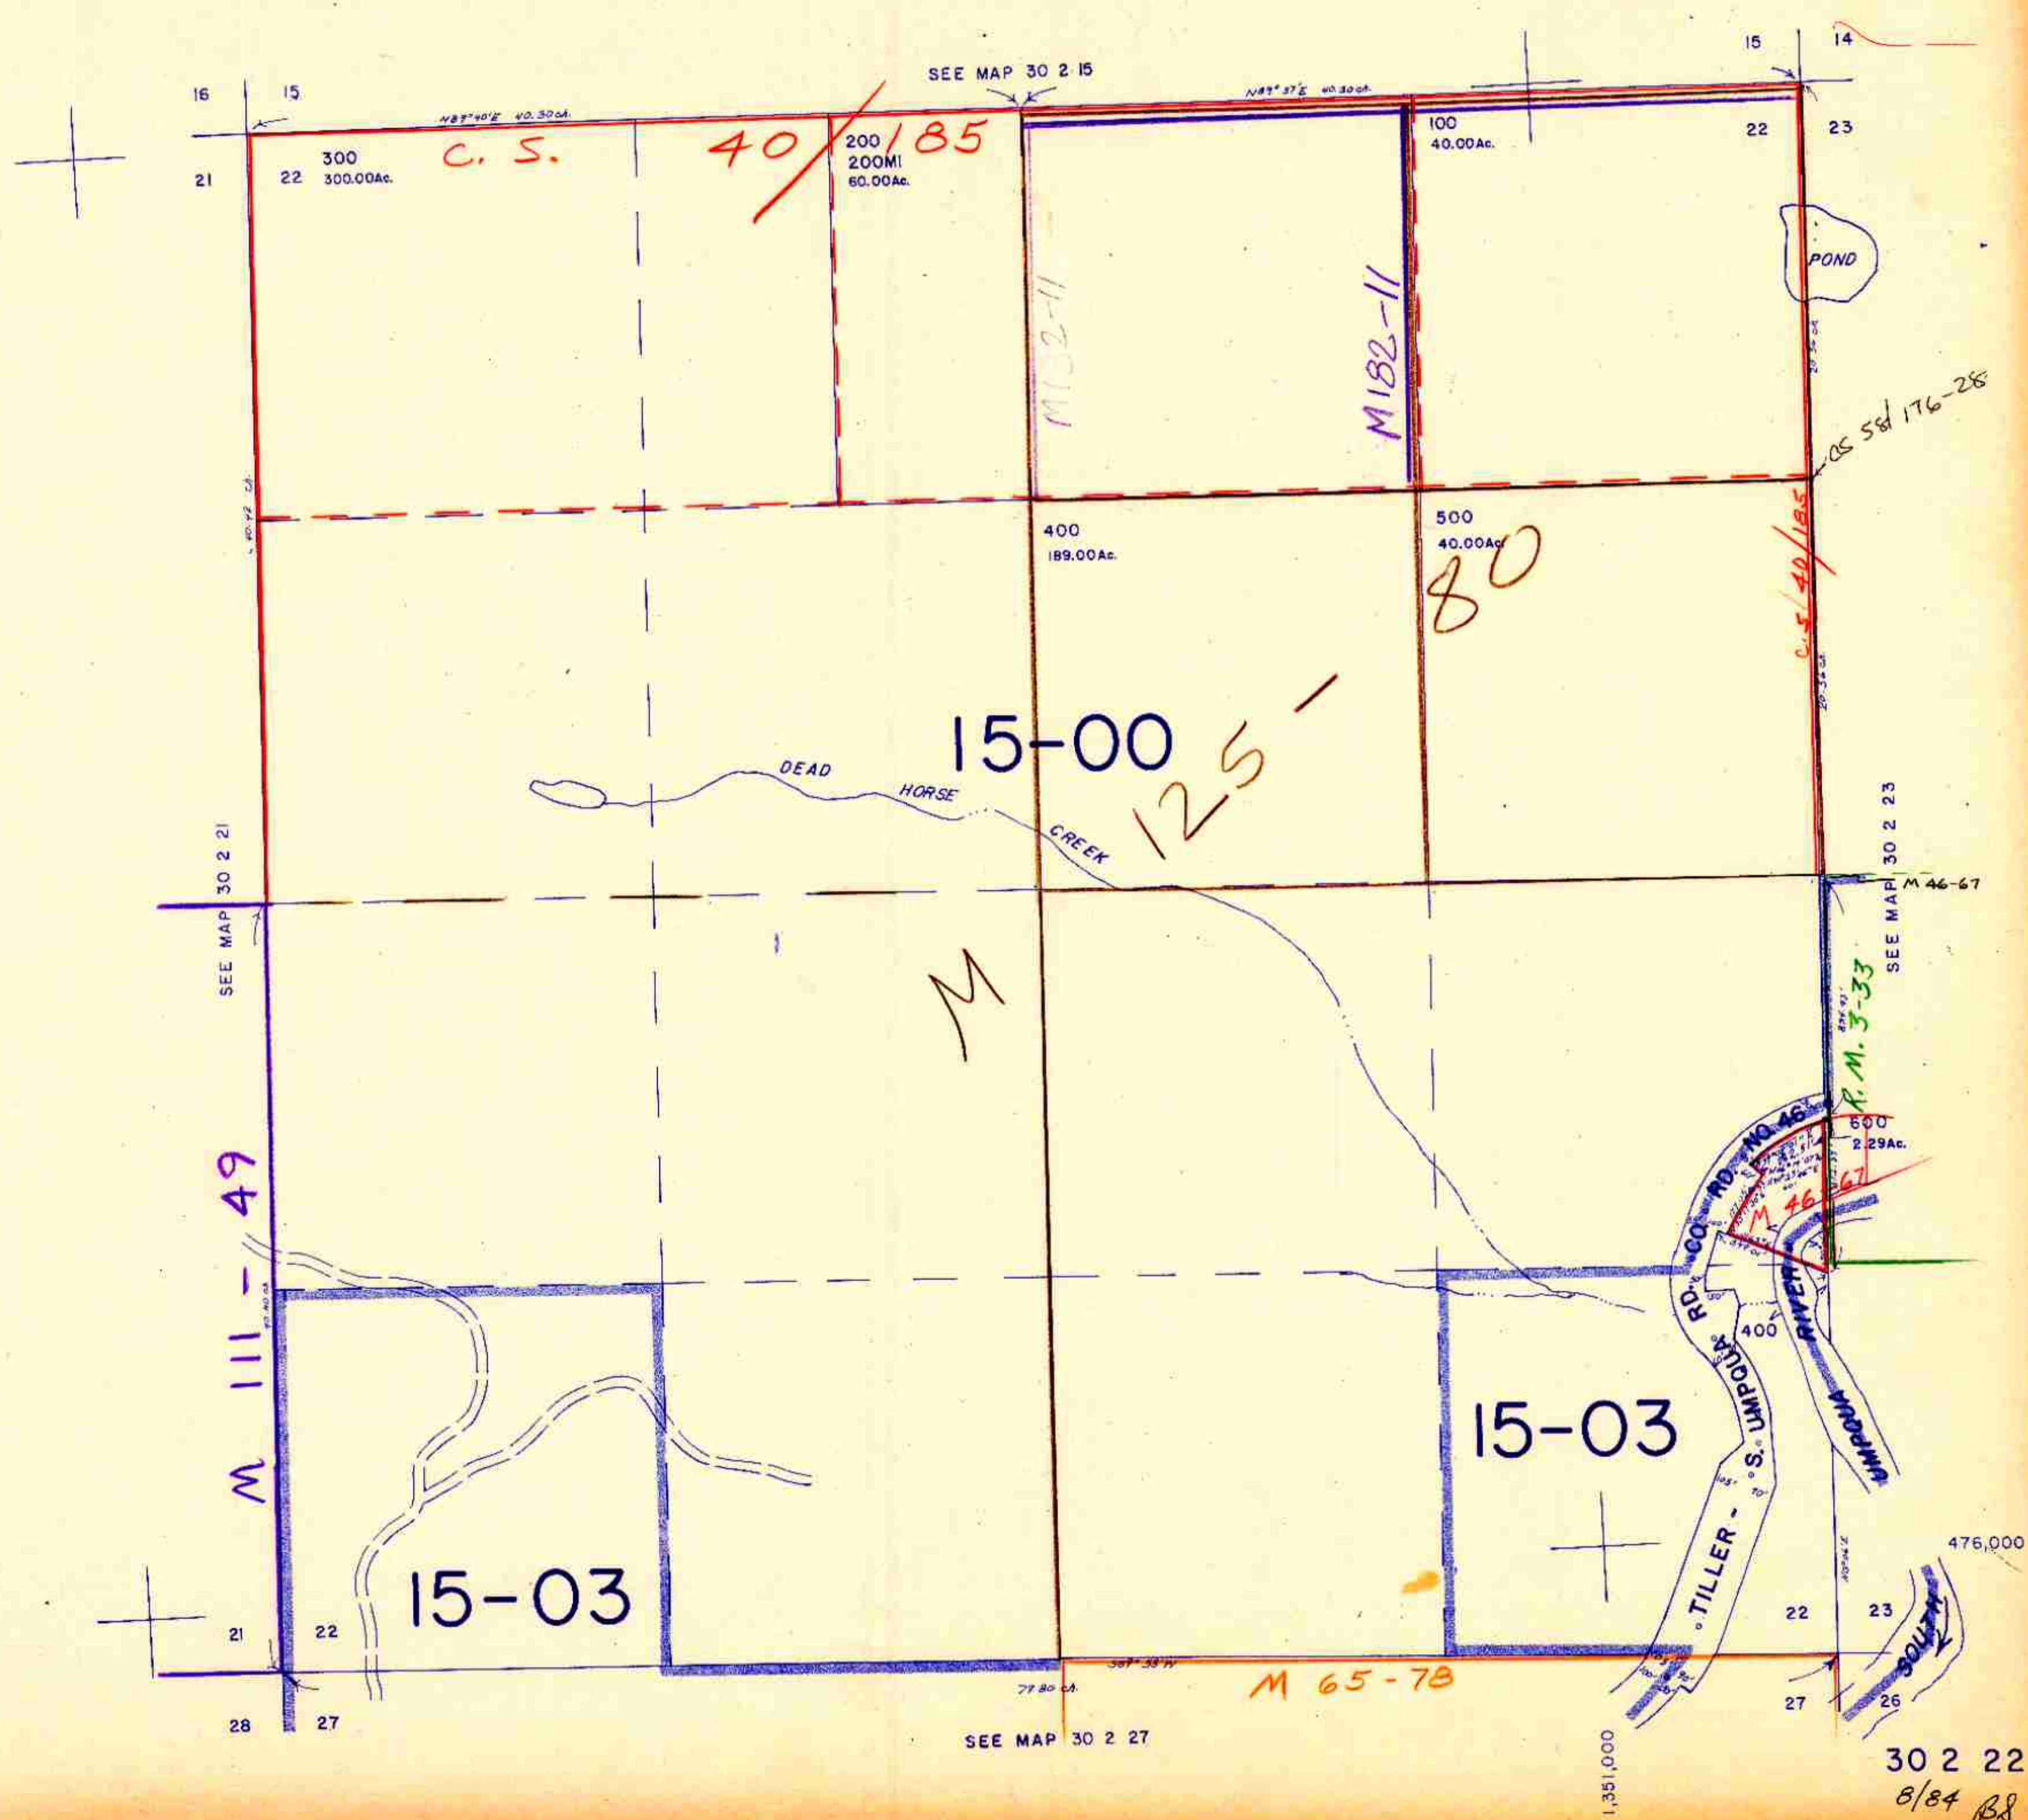

30 2 22
8/84 BS