SECTION 24 T.30S. R.2W. W.M.
DOUGLAS COUNTY

1" = 400'

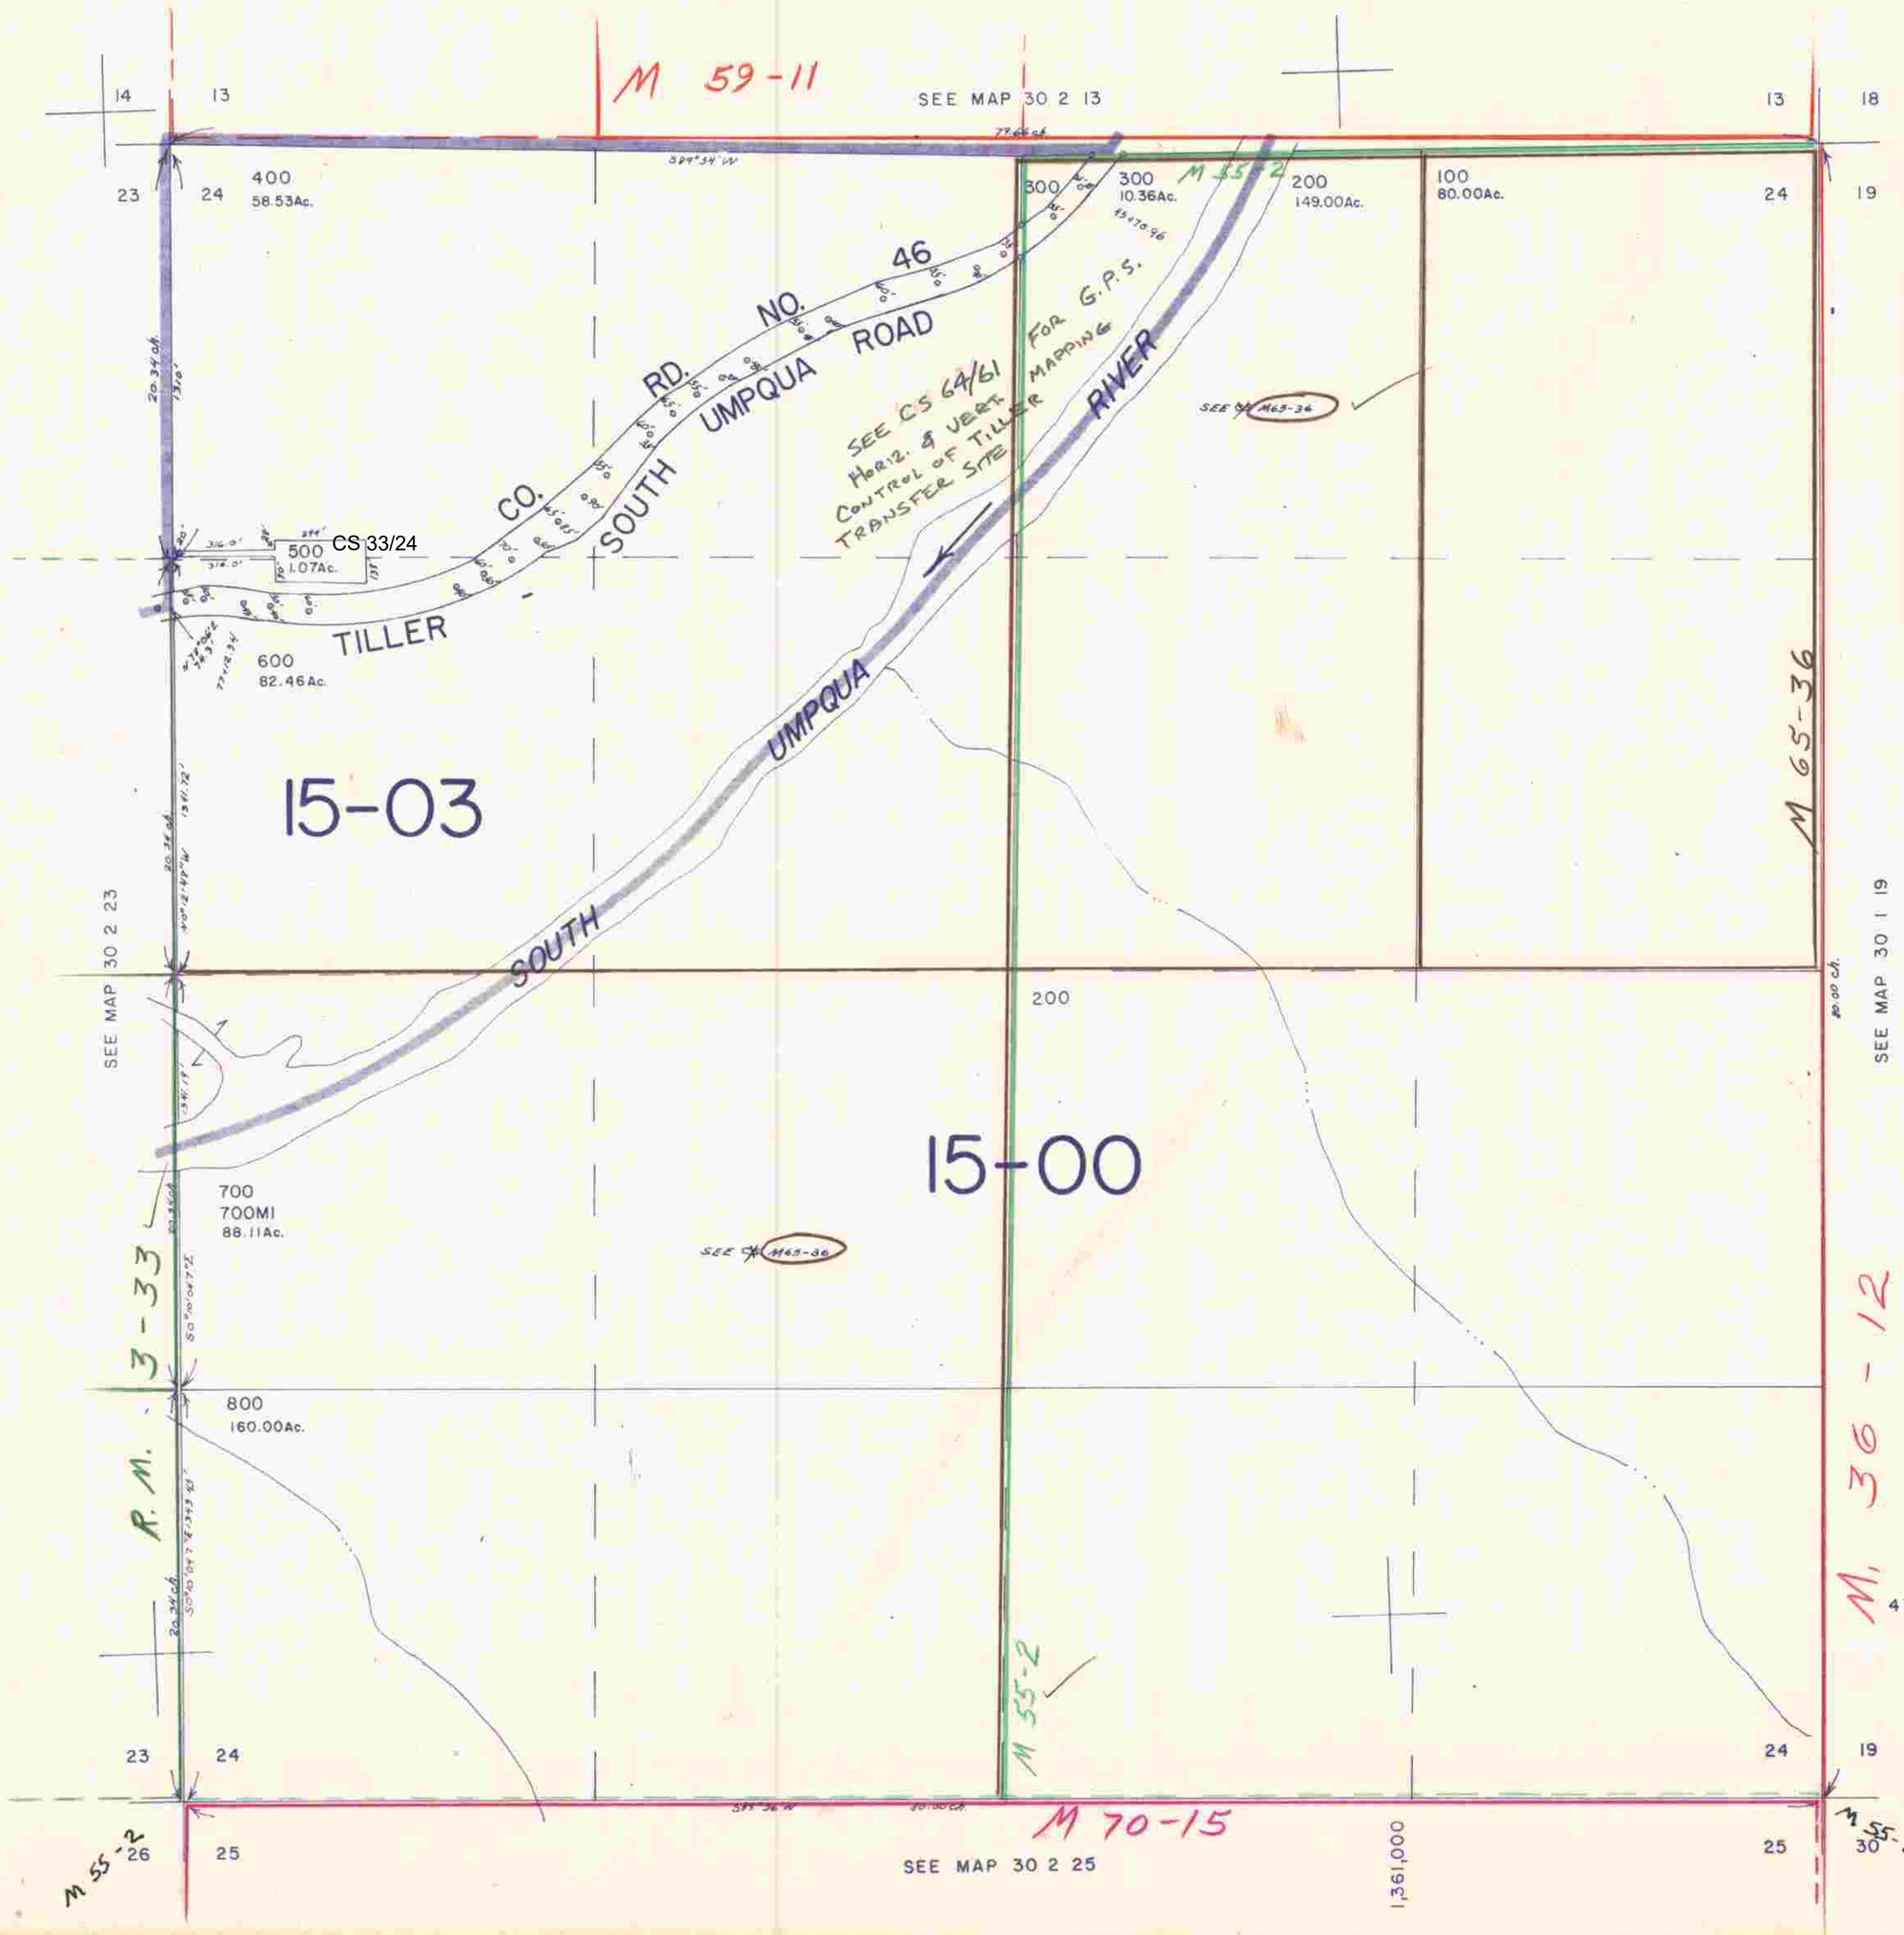

8/84 BS