


THIS MAP WAS PREPARED FOR ASSESSMENT PURPOSE ONLY.

SEC.30 T30S. R.2W. W.M.
DOUGLAS COUNTY
1" = 400'

REVISED ON
11-19-20

30 2 30

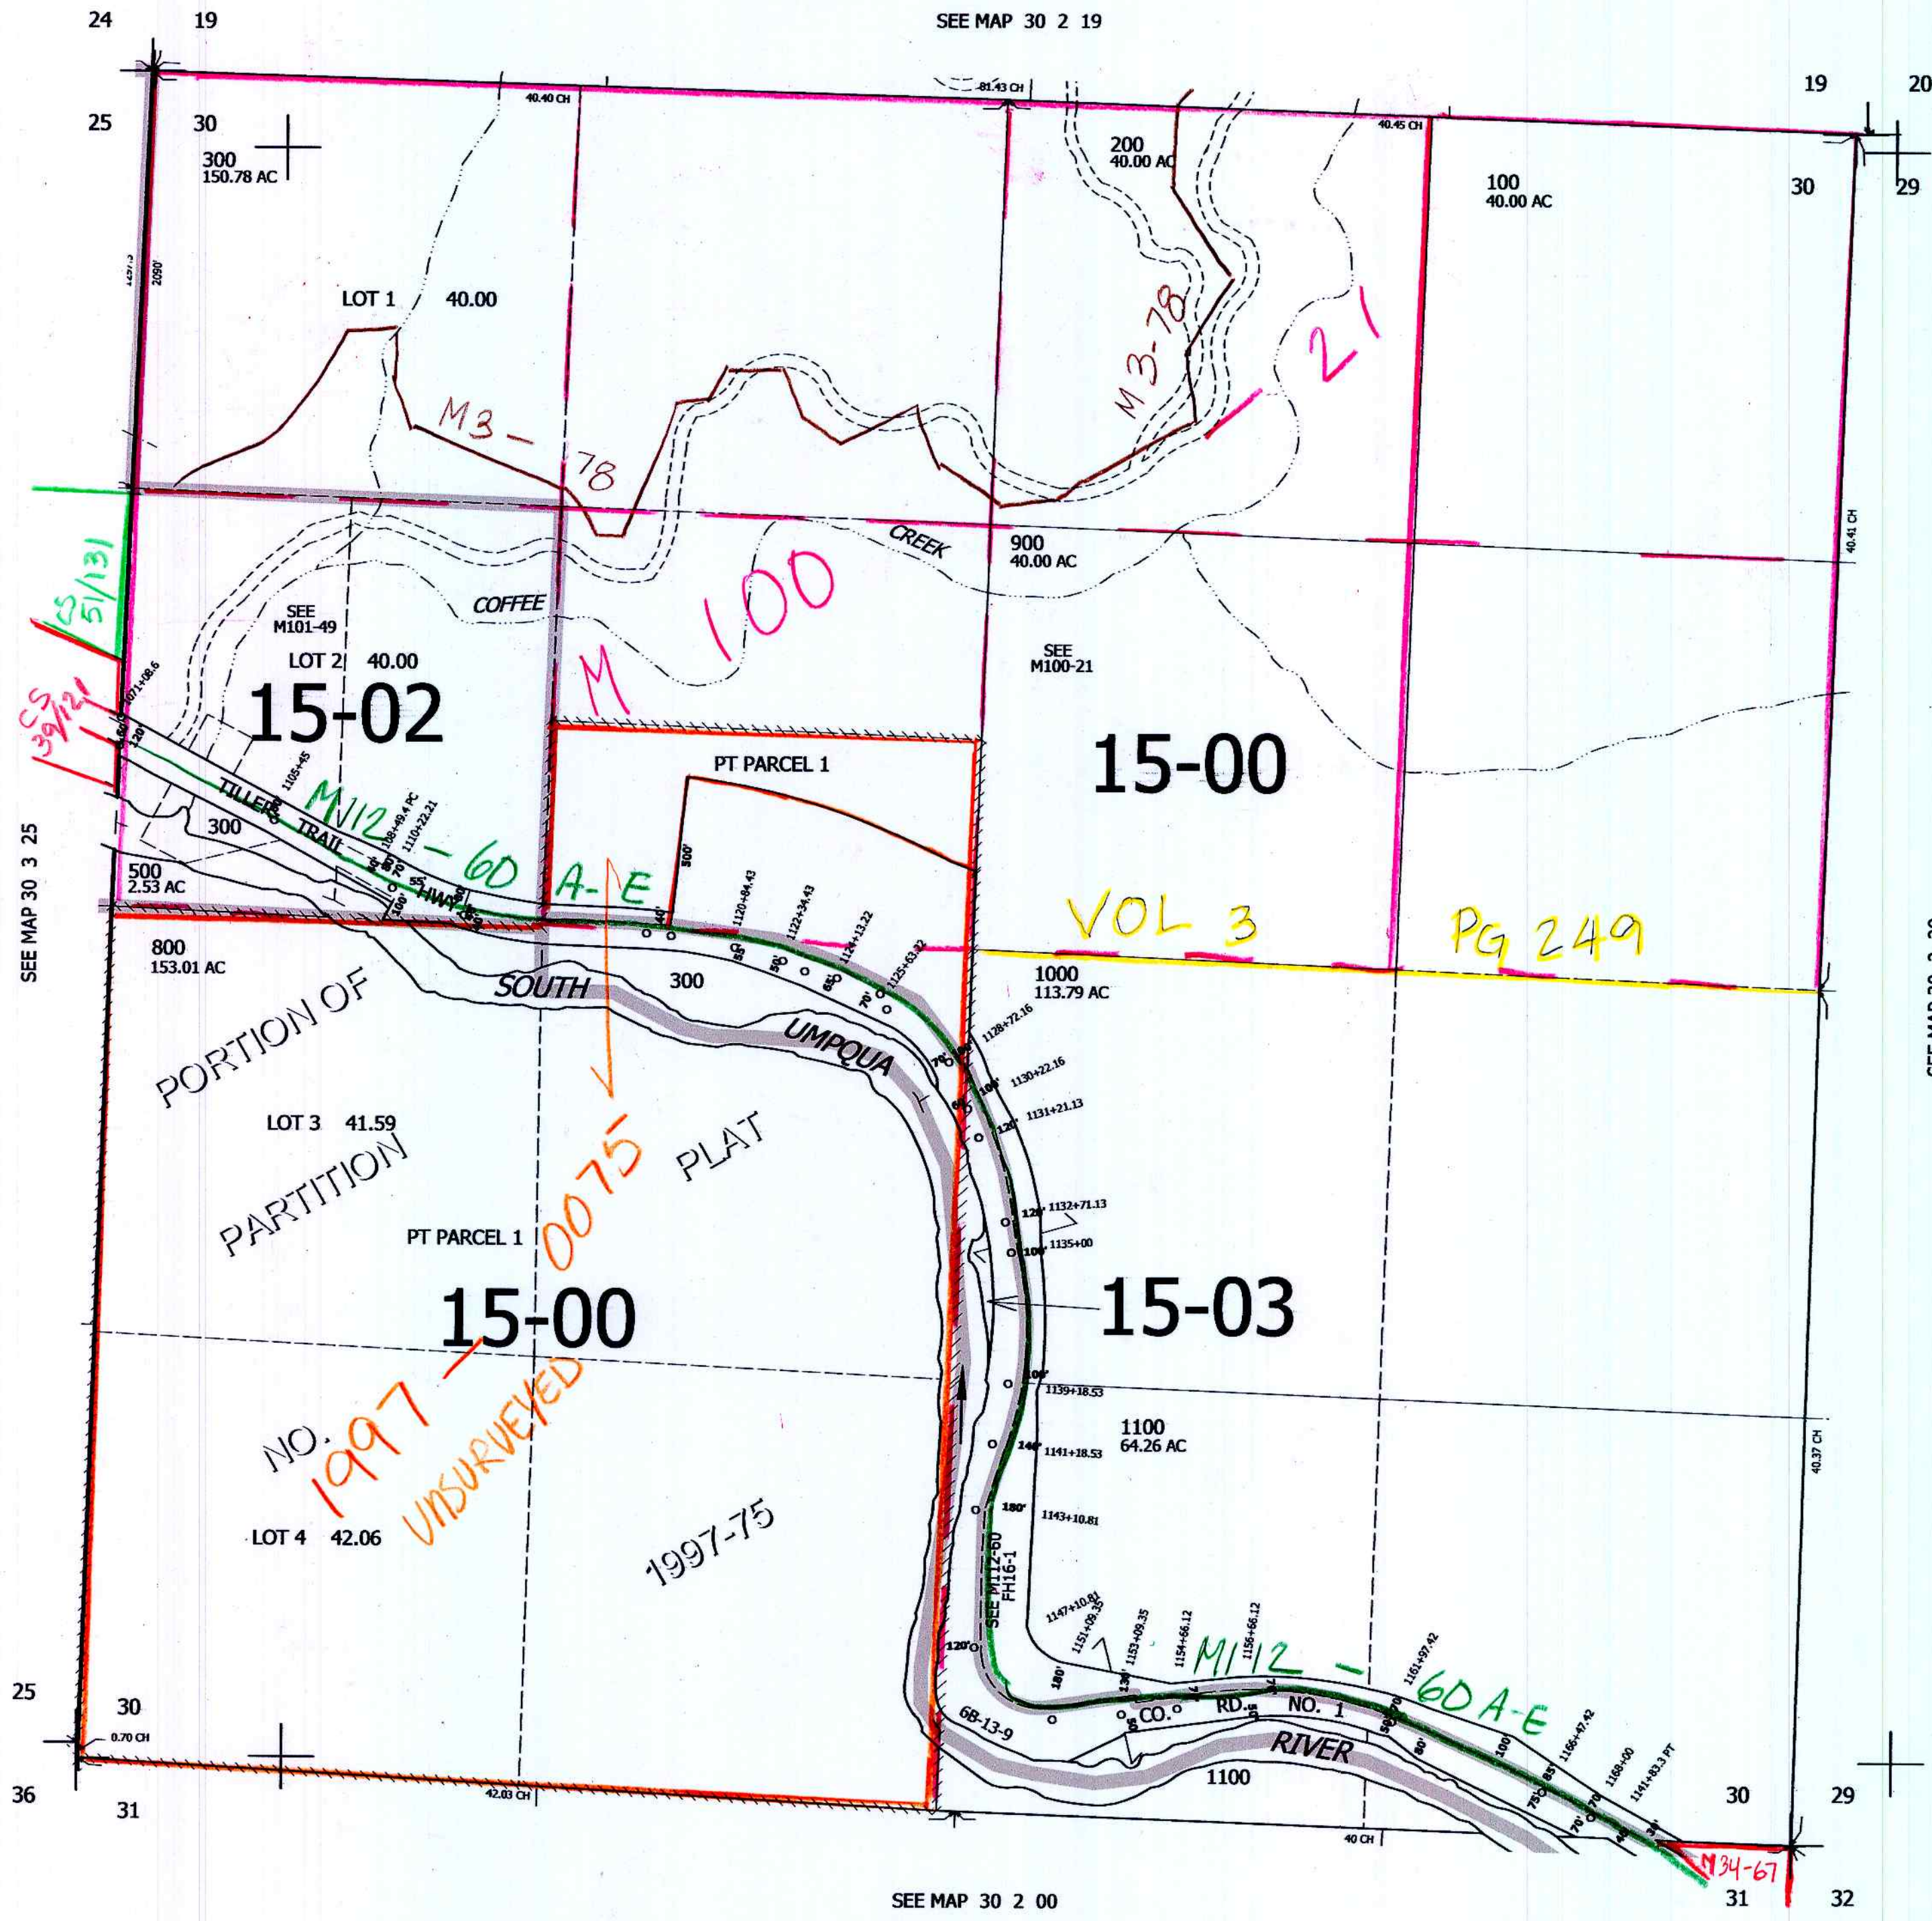

CANCELLED NO'S
100M1 200M1 400
501 600 700
801

NO. 1997-75
UNSURVEYED

VOL 3 Pg 249

11/20/20
SC

30 2 30