SECTION 4 T.30S. R.3W. W.M.
DOUGLAS COUNTY

1"=400'

THIS MAP WAS PREPARED FOR ASSESSMENT PURPOSE ONLY.

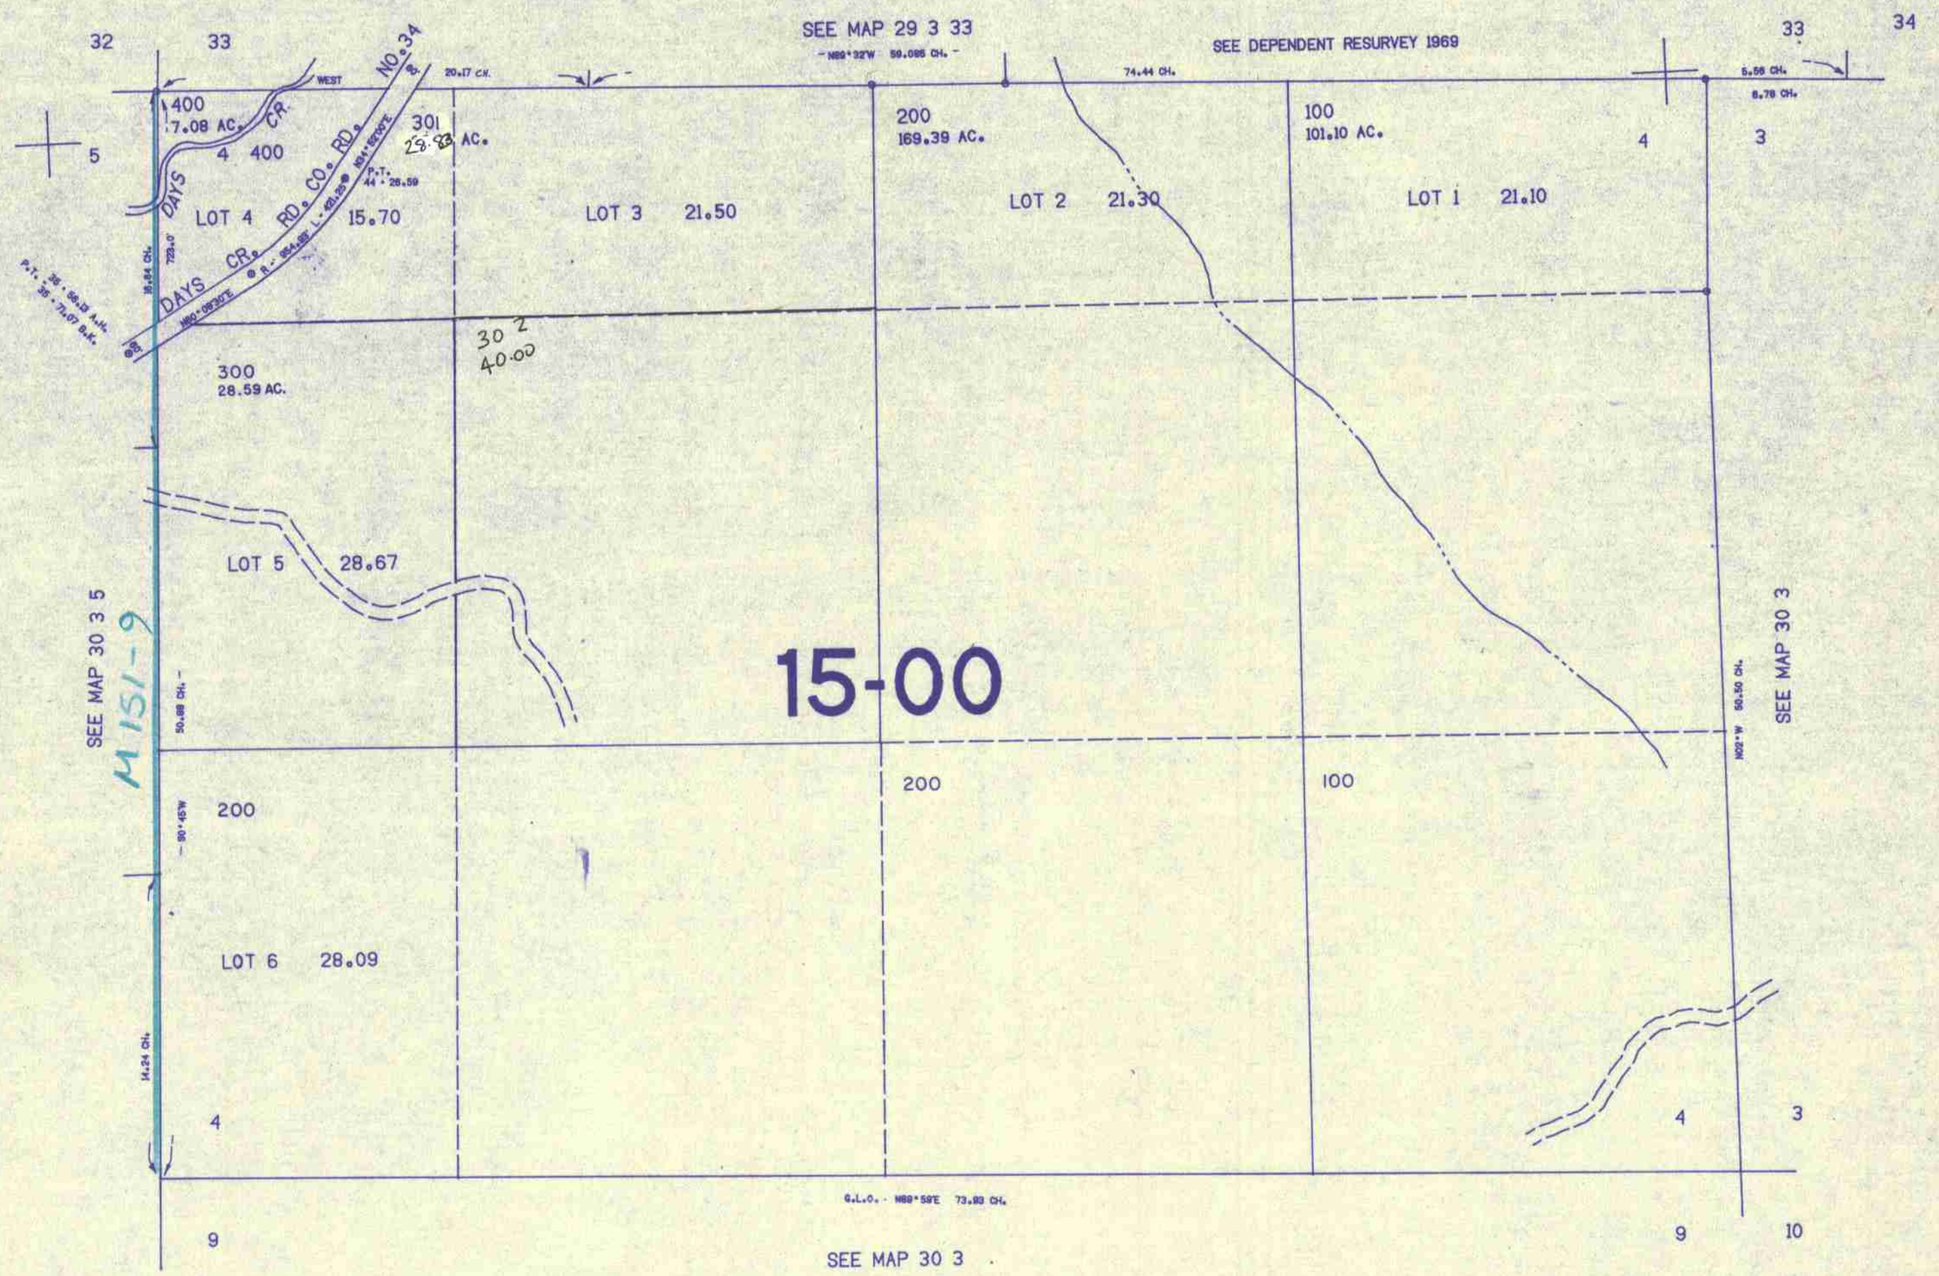

M151-9

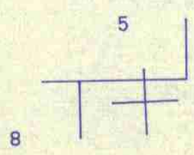

491,000

1,315,000

8/84 BS