SECTION 6 T.30S. R.3W. W.M.
DOUGLAS COUNTY

1"=400'

REVISED ON
1-27-93
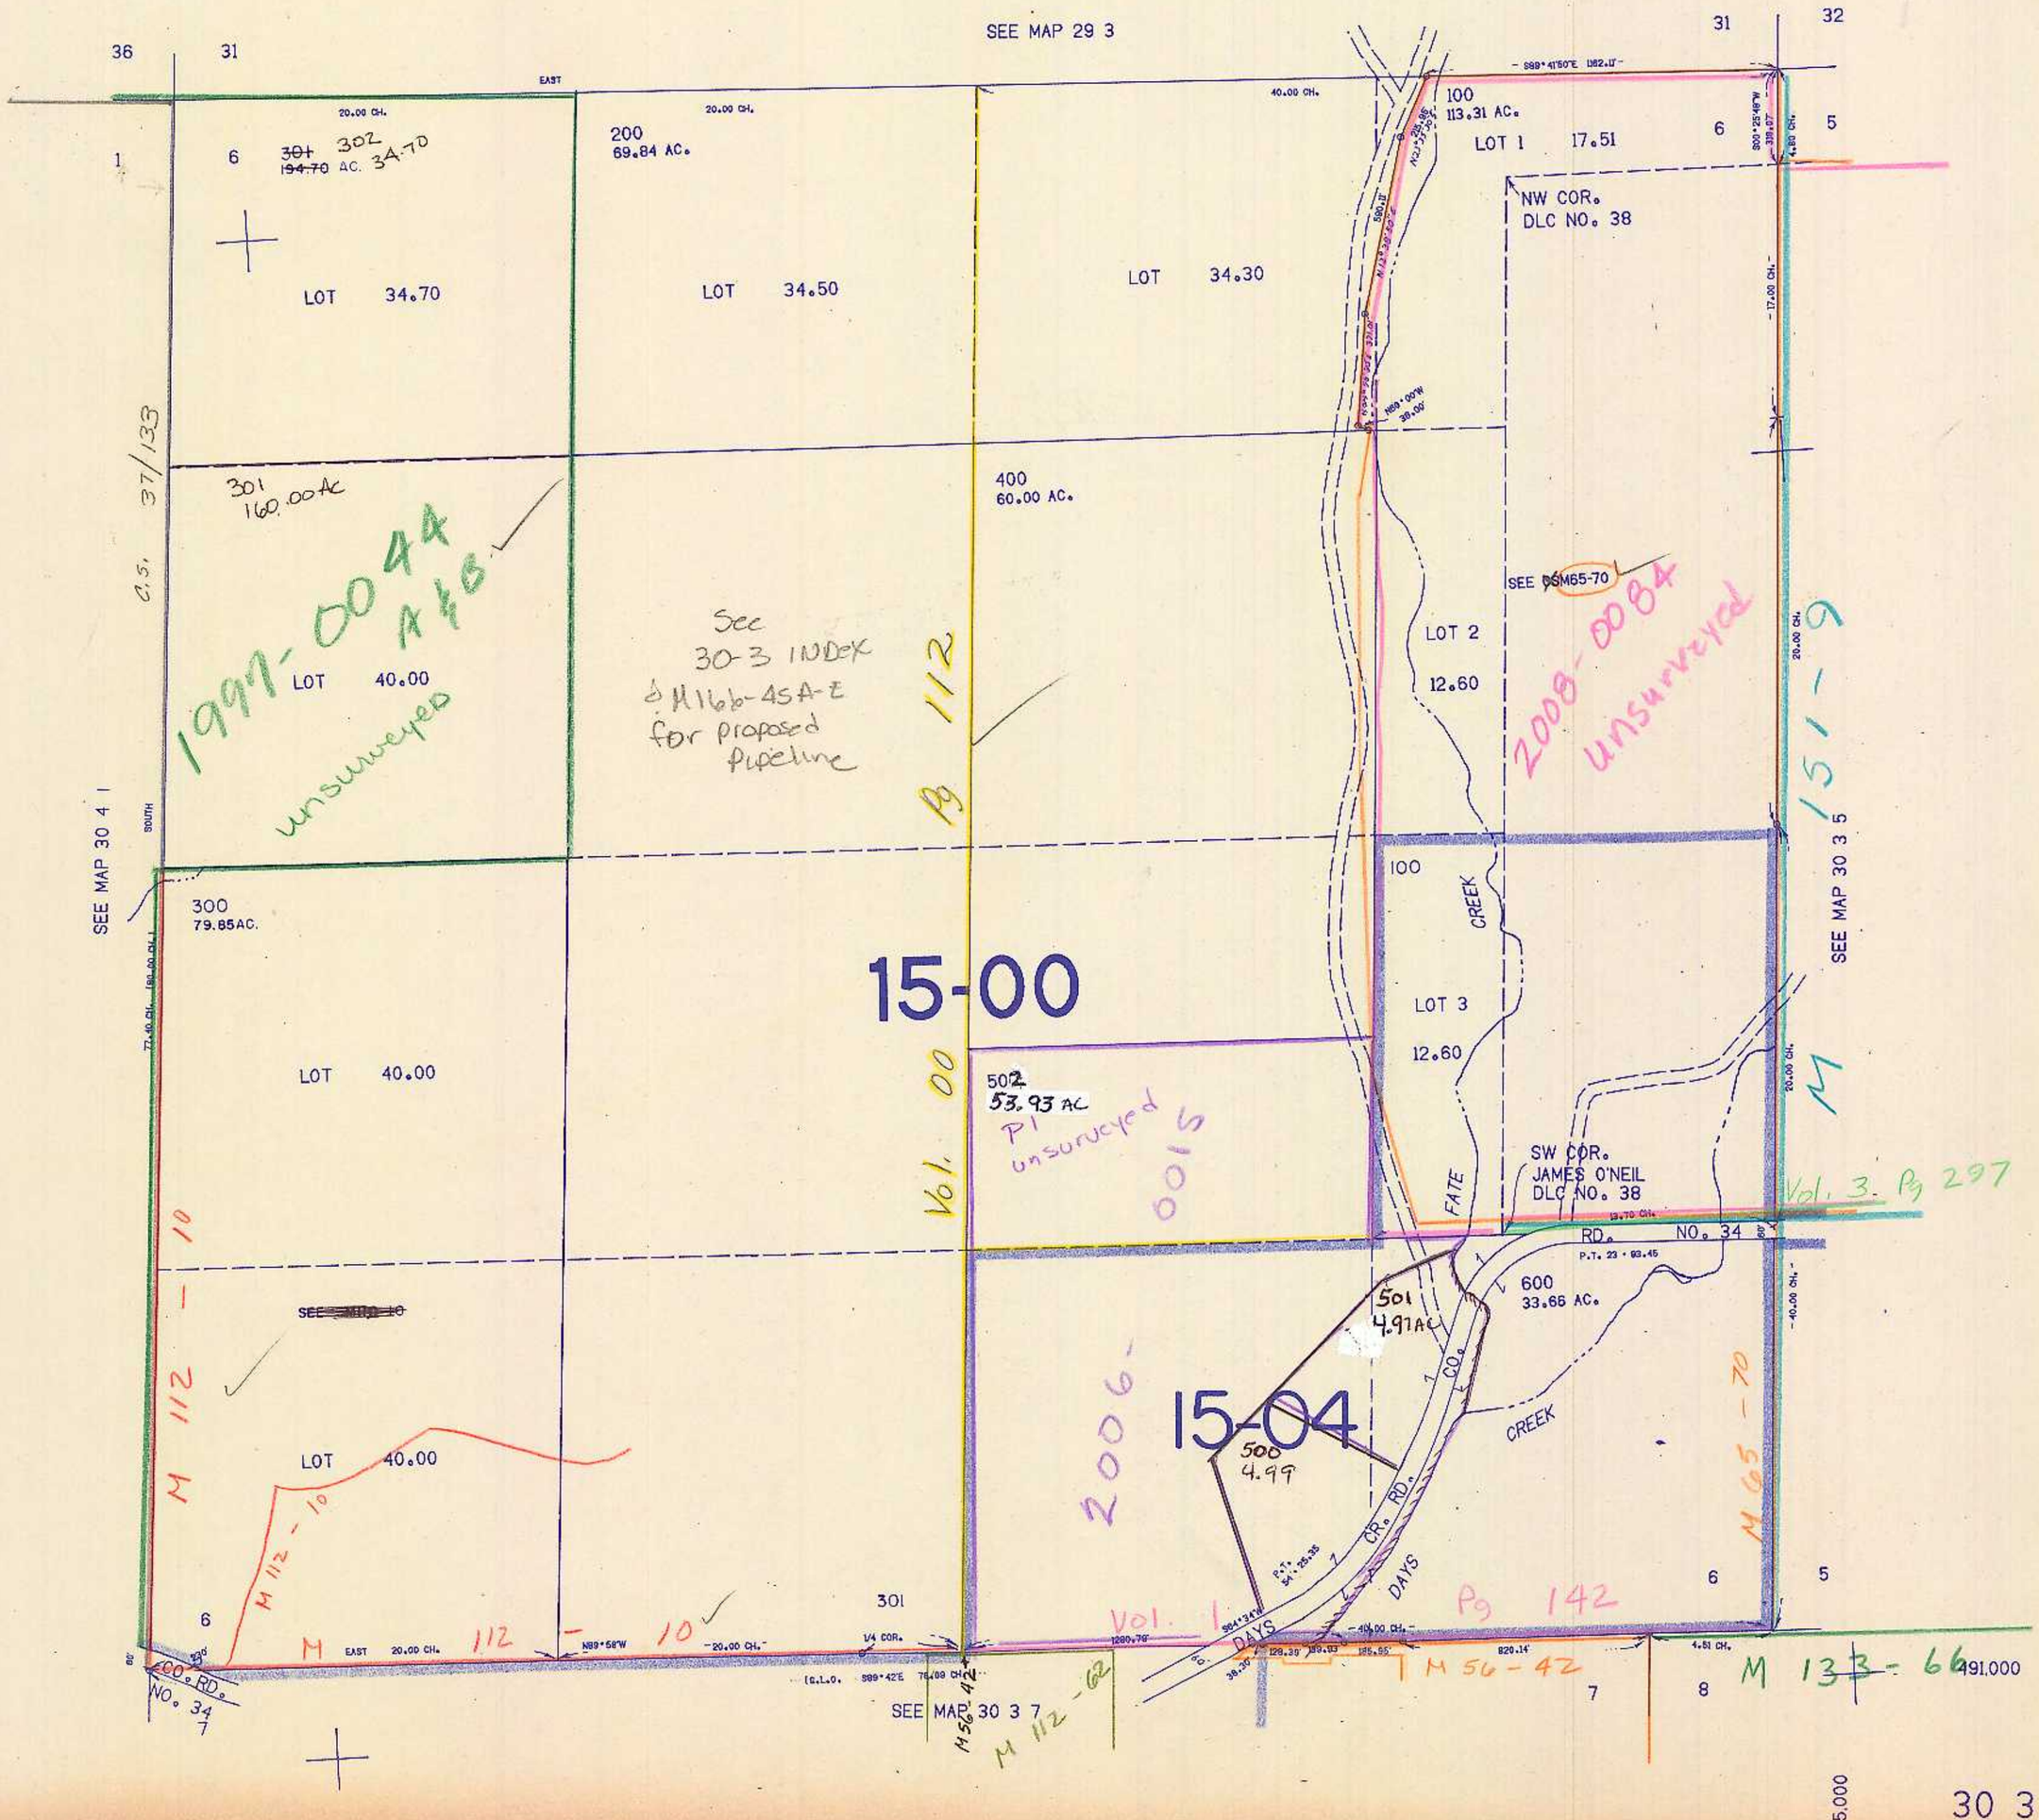
THIS MAP WAS PREPARED FOR ASSESSMENT PURPOSE ONLY.