THIS MAP WAS PREPARED FOR ASSESSMENT PURPOSE ONLY.

SEC.7 T30S. R.3W. W.M.
DOUGLAS COUNTY
1" = 400'

REVISED ON
5-3-19

30 3 7

CANCELLED NO'S
1201

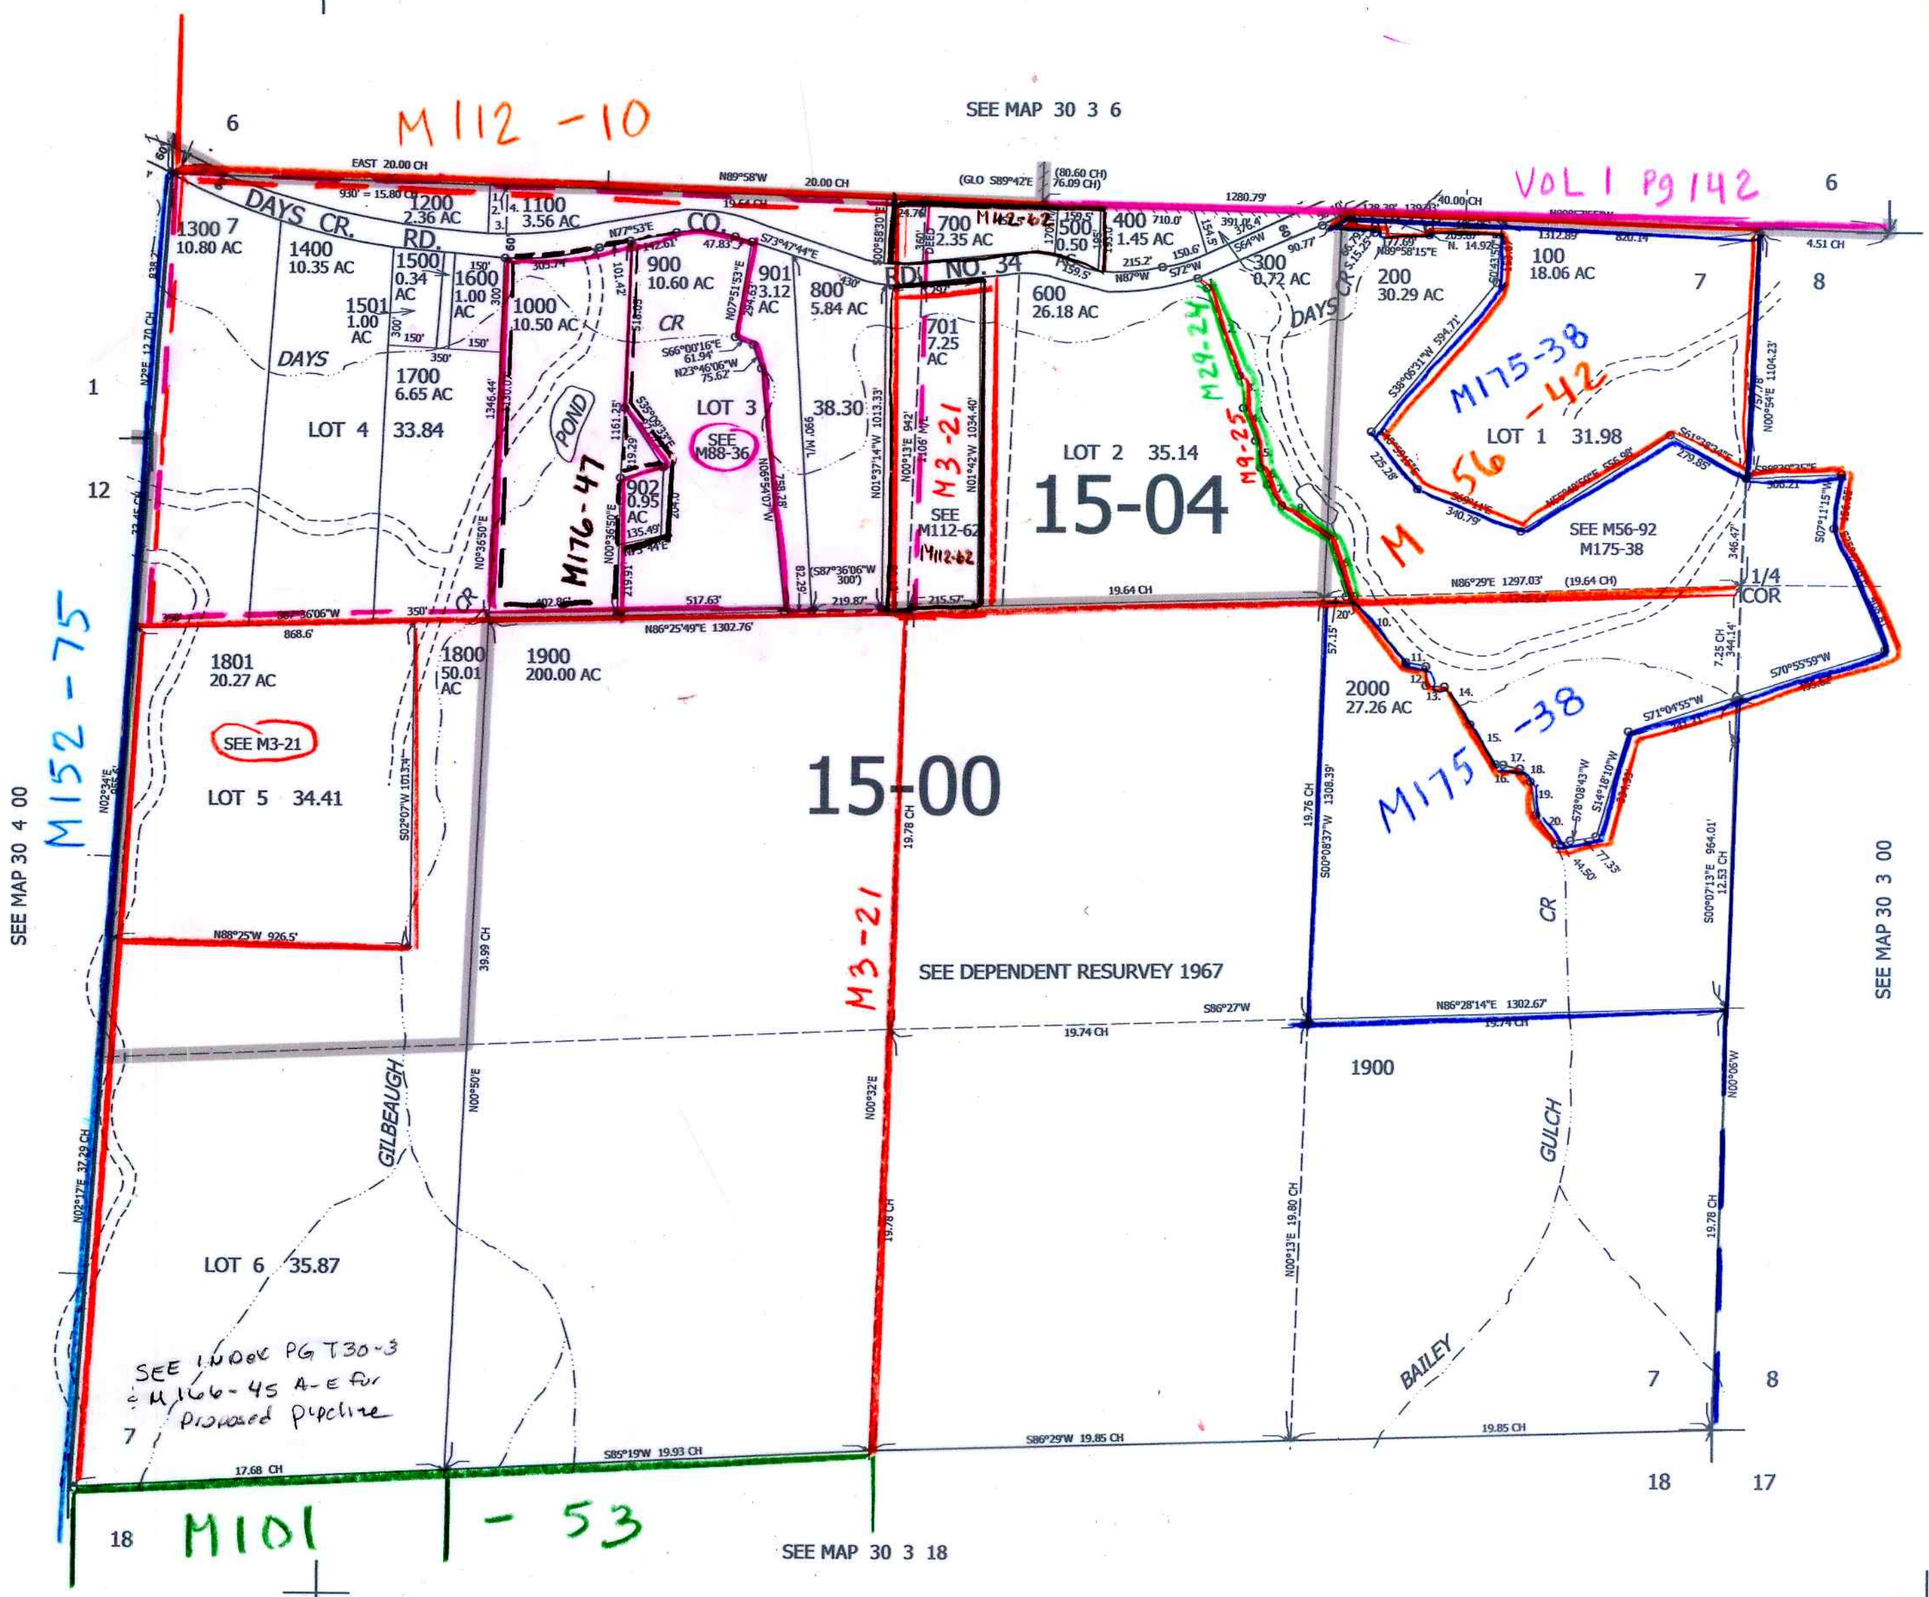

PARCEL 2000

1. S44°52'E 42.6'
2. S23°52'E 283.3'
3. S8°34'E 99.9'
4. S20°36'E 111.8'
5. S14°53'E 87.4'
6. S21°58'E 63.2'
7. S37°18'E 79.6'
8. S58°38'E 154.7'
9. S23°21'E 192.3'
10. N44°24'W 276.02'
11. N85°53'W 64.26'
12. N6°35'E 63.32'
13. S88°55'W 66.35'
14. N36°20'W 142.14'
15. N37°18'W 142.6'
16. S87°20'W 26.84'
17. N76°55'W 69.91'
18. N38°33'W 46.02'
19. N11°42'W 106.78'
20. N36°20'W 102.77'

PARCEL 1201

1. N89°58'23"W 55.9'
2. S0°36'50"W 156.79'
3. N87°51'02"E 55.97'
4. N0°36'50"E 154.66'

487,000

4,226,000

5-7-1981 KV

30 3 7