THIS MAP WAS PREPARED FOR ASSESSMENT PURPOSE ONLY.

SW1/4 NE1/4 SEC.26 T.30S. R.3 W.W.M.

DOUGLAS COUNTY

1"=100'

REVISED ON

30 3 26AC

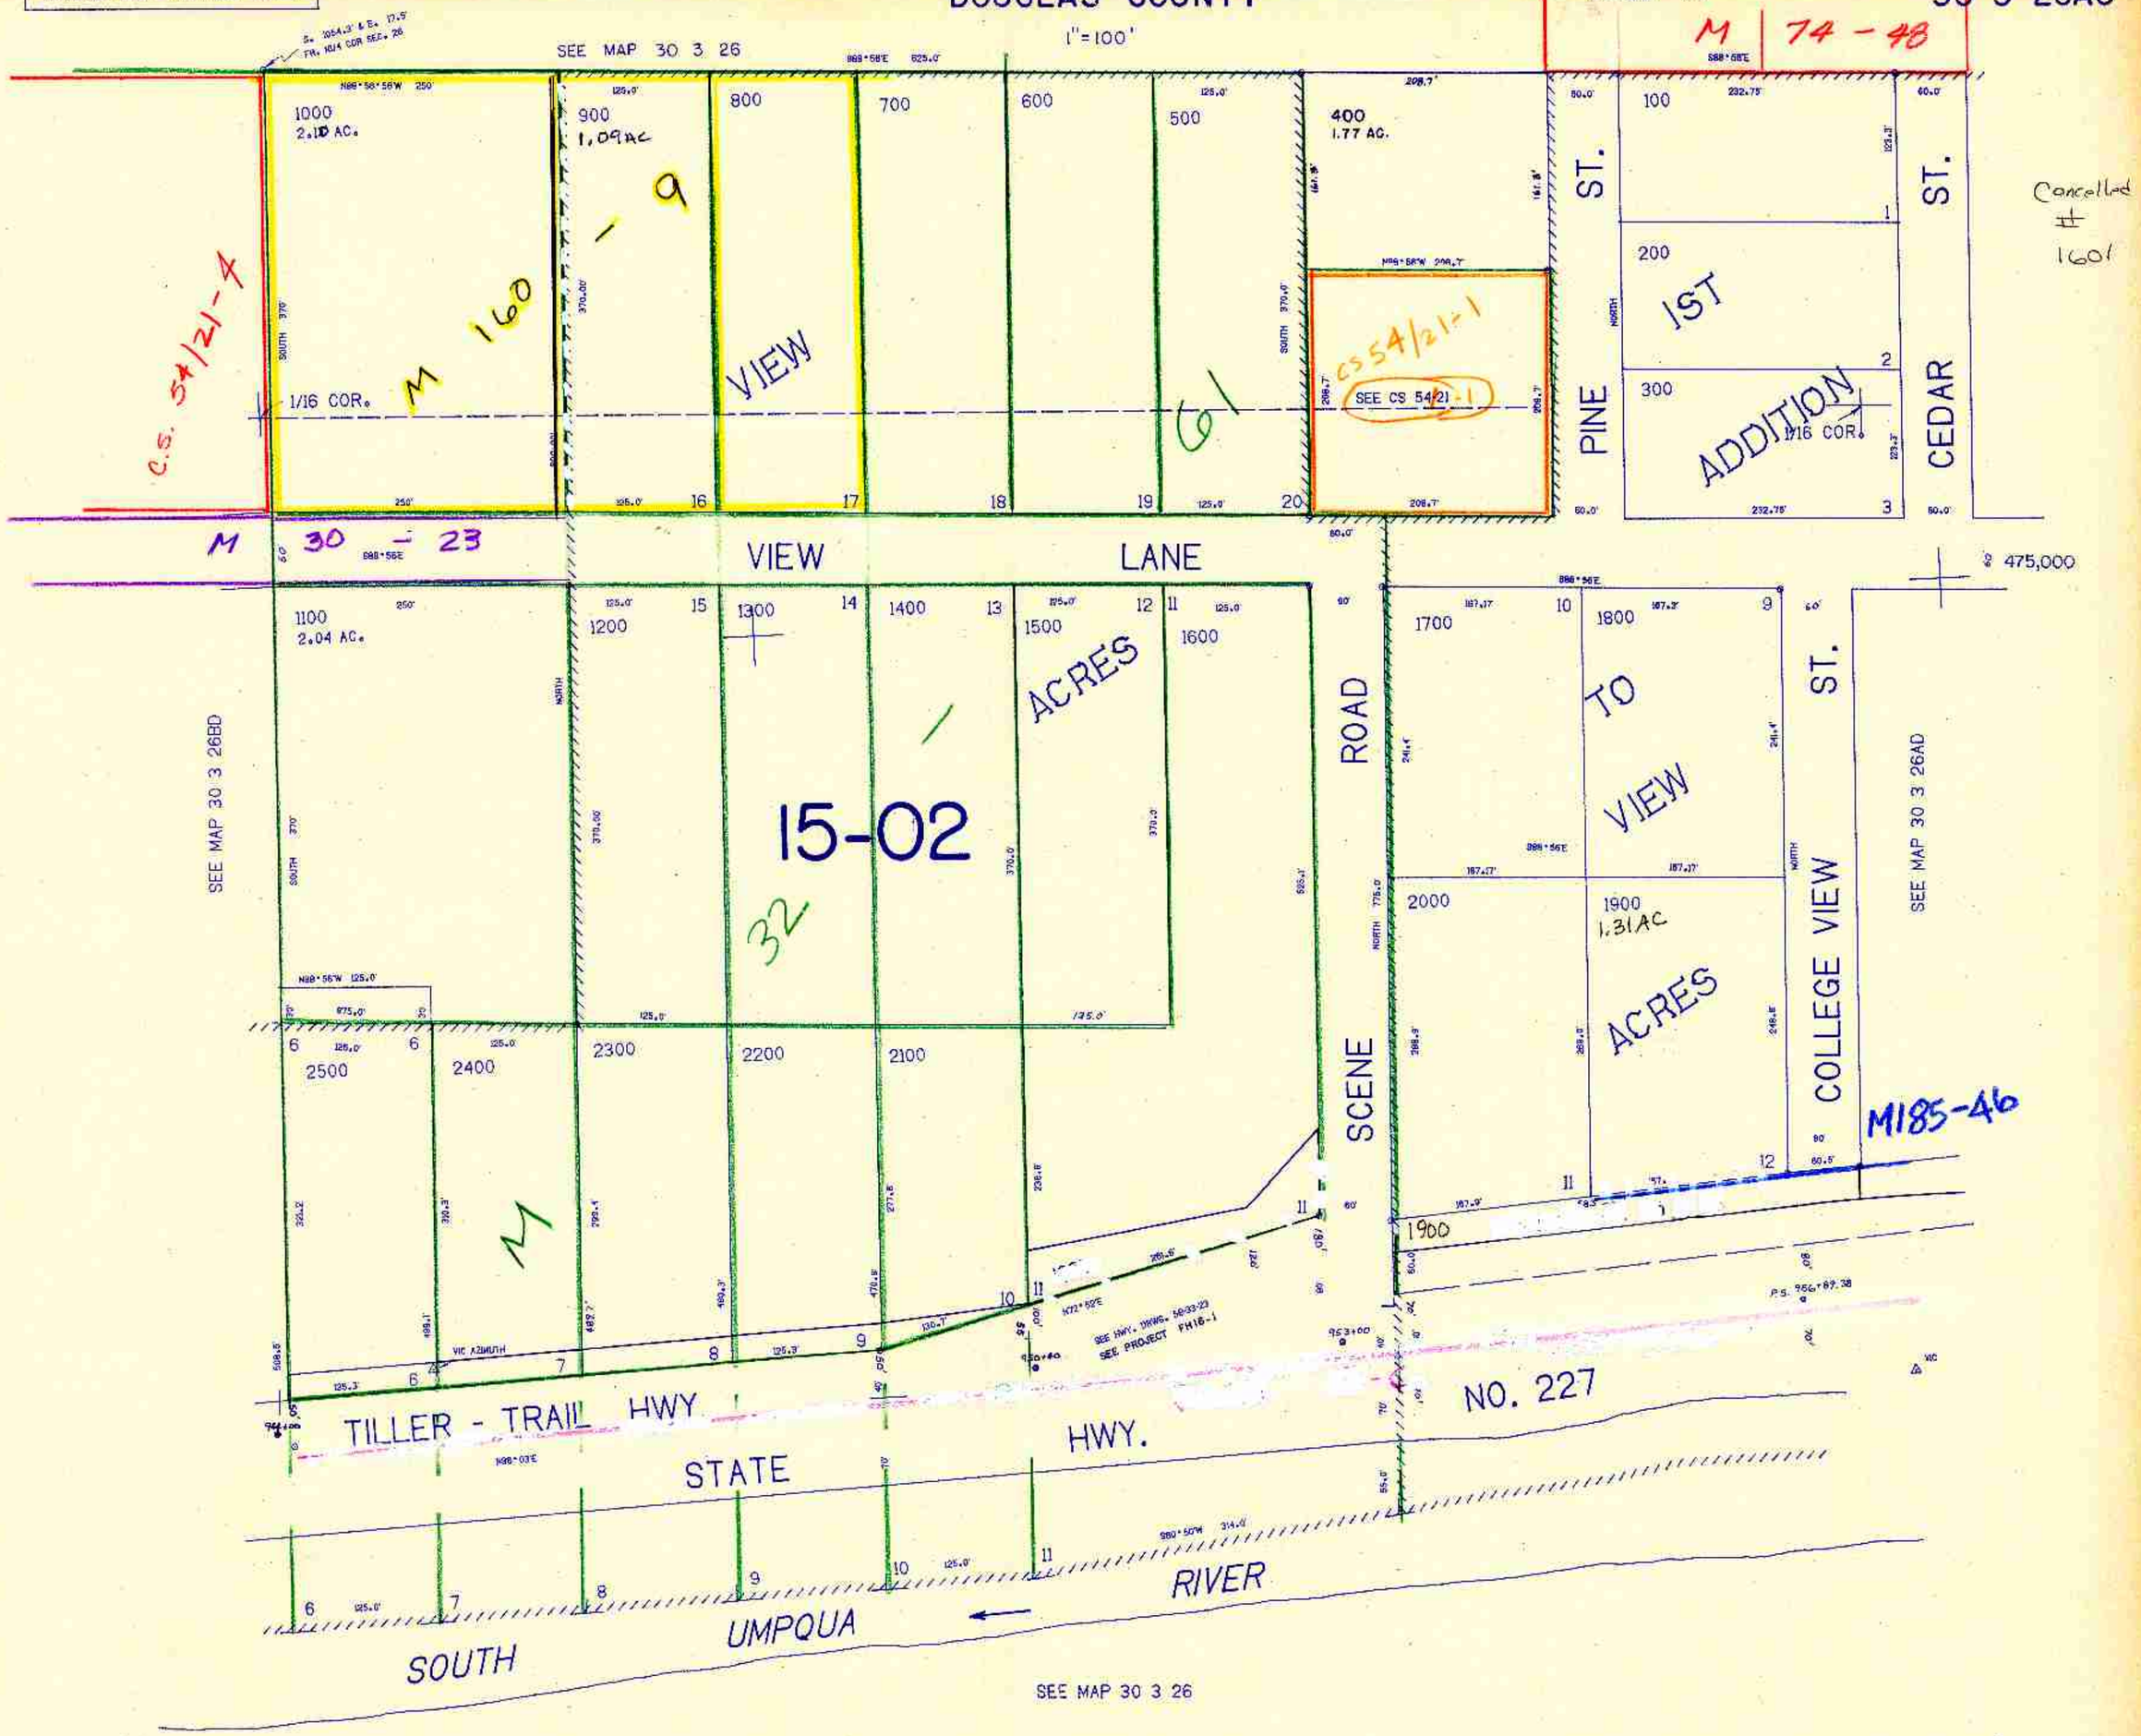

CENTER SECTION

1/16 COR.

30 3 26AC