


DOUGLAS COUNTY

1" = 100'

THIS MAP WAS PREPARED FOR ASSESSMENT PURPOSE ONLY.

APPROX. 1/16 COR.

1/16 COR.

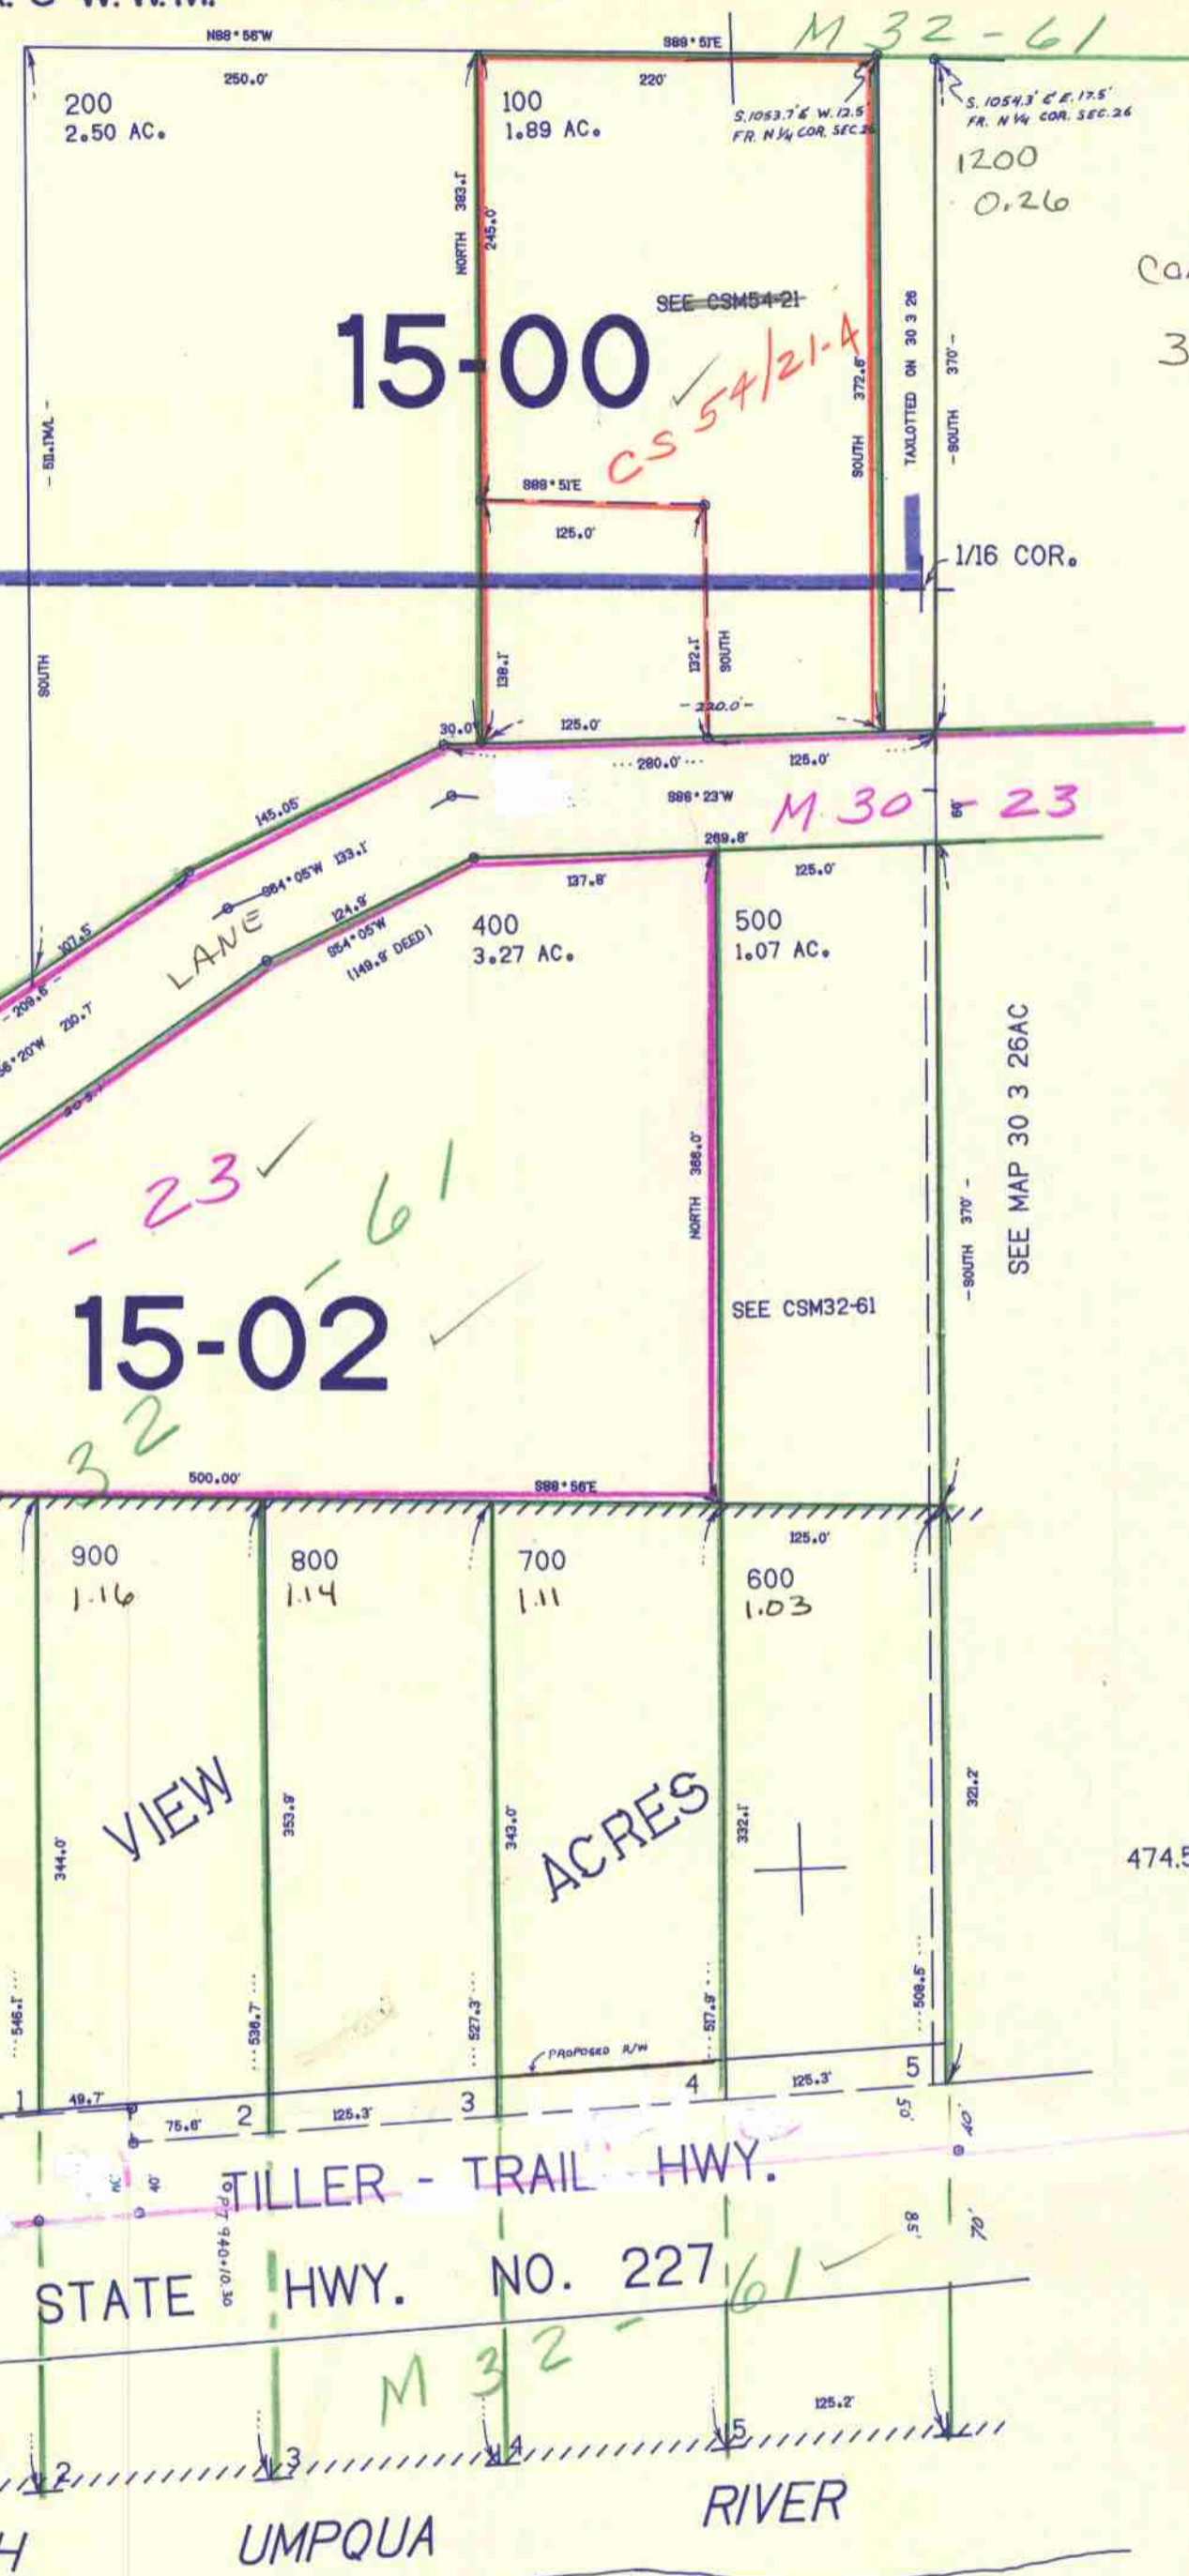

Cancelled
300

474.500

1.322.500