


T.30S. R.4W. W.M.
DOUGLAS COUNTY

1"=2000'
SEE MAP 29 4

THIS MAP WAS PREPARED FOR
ASSESSMENT PURPOSE ONLY.

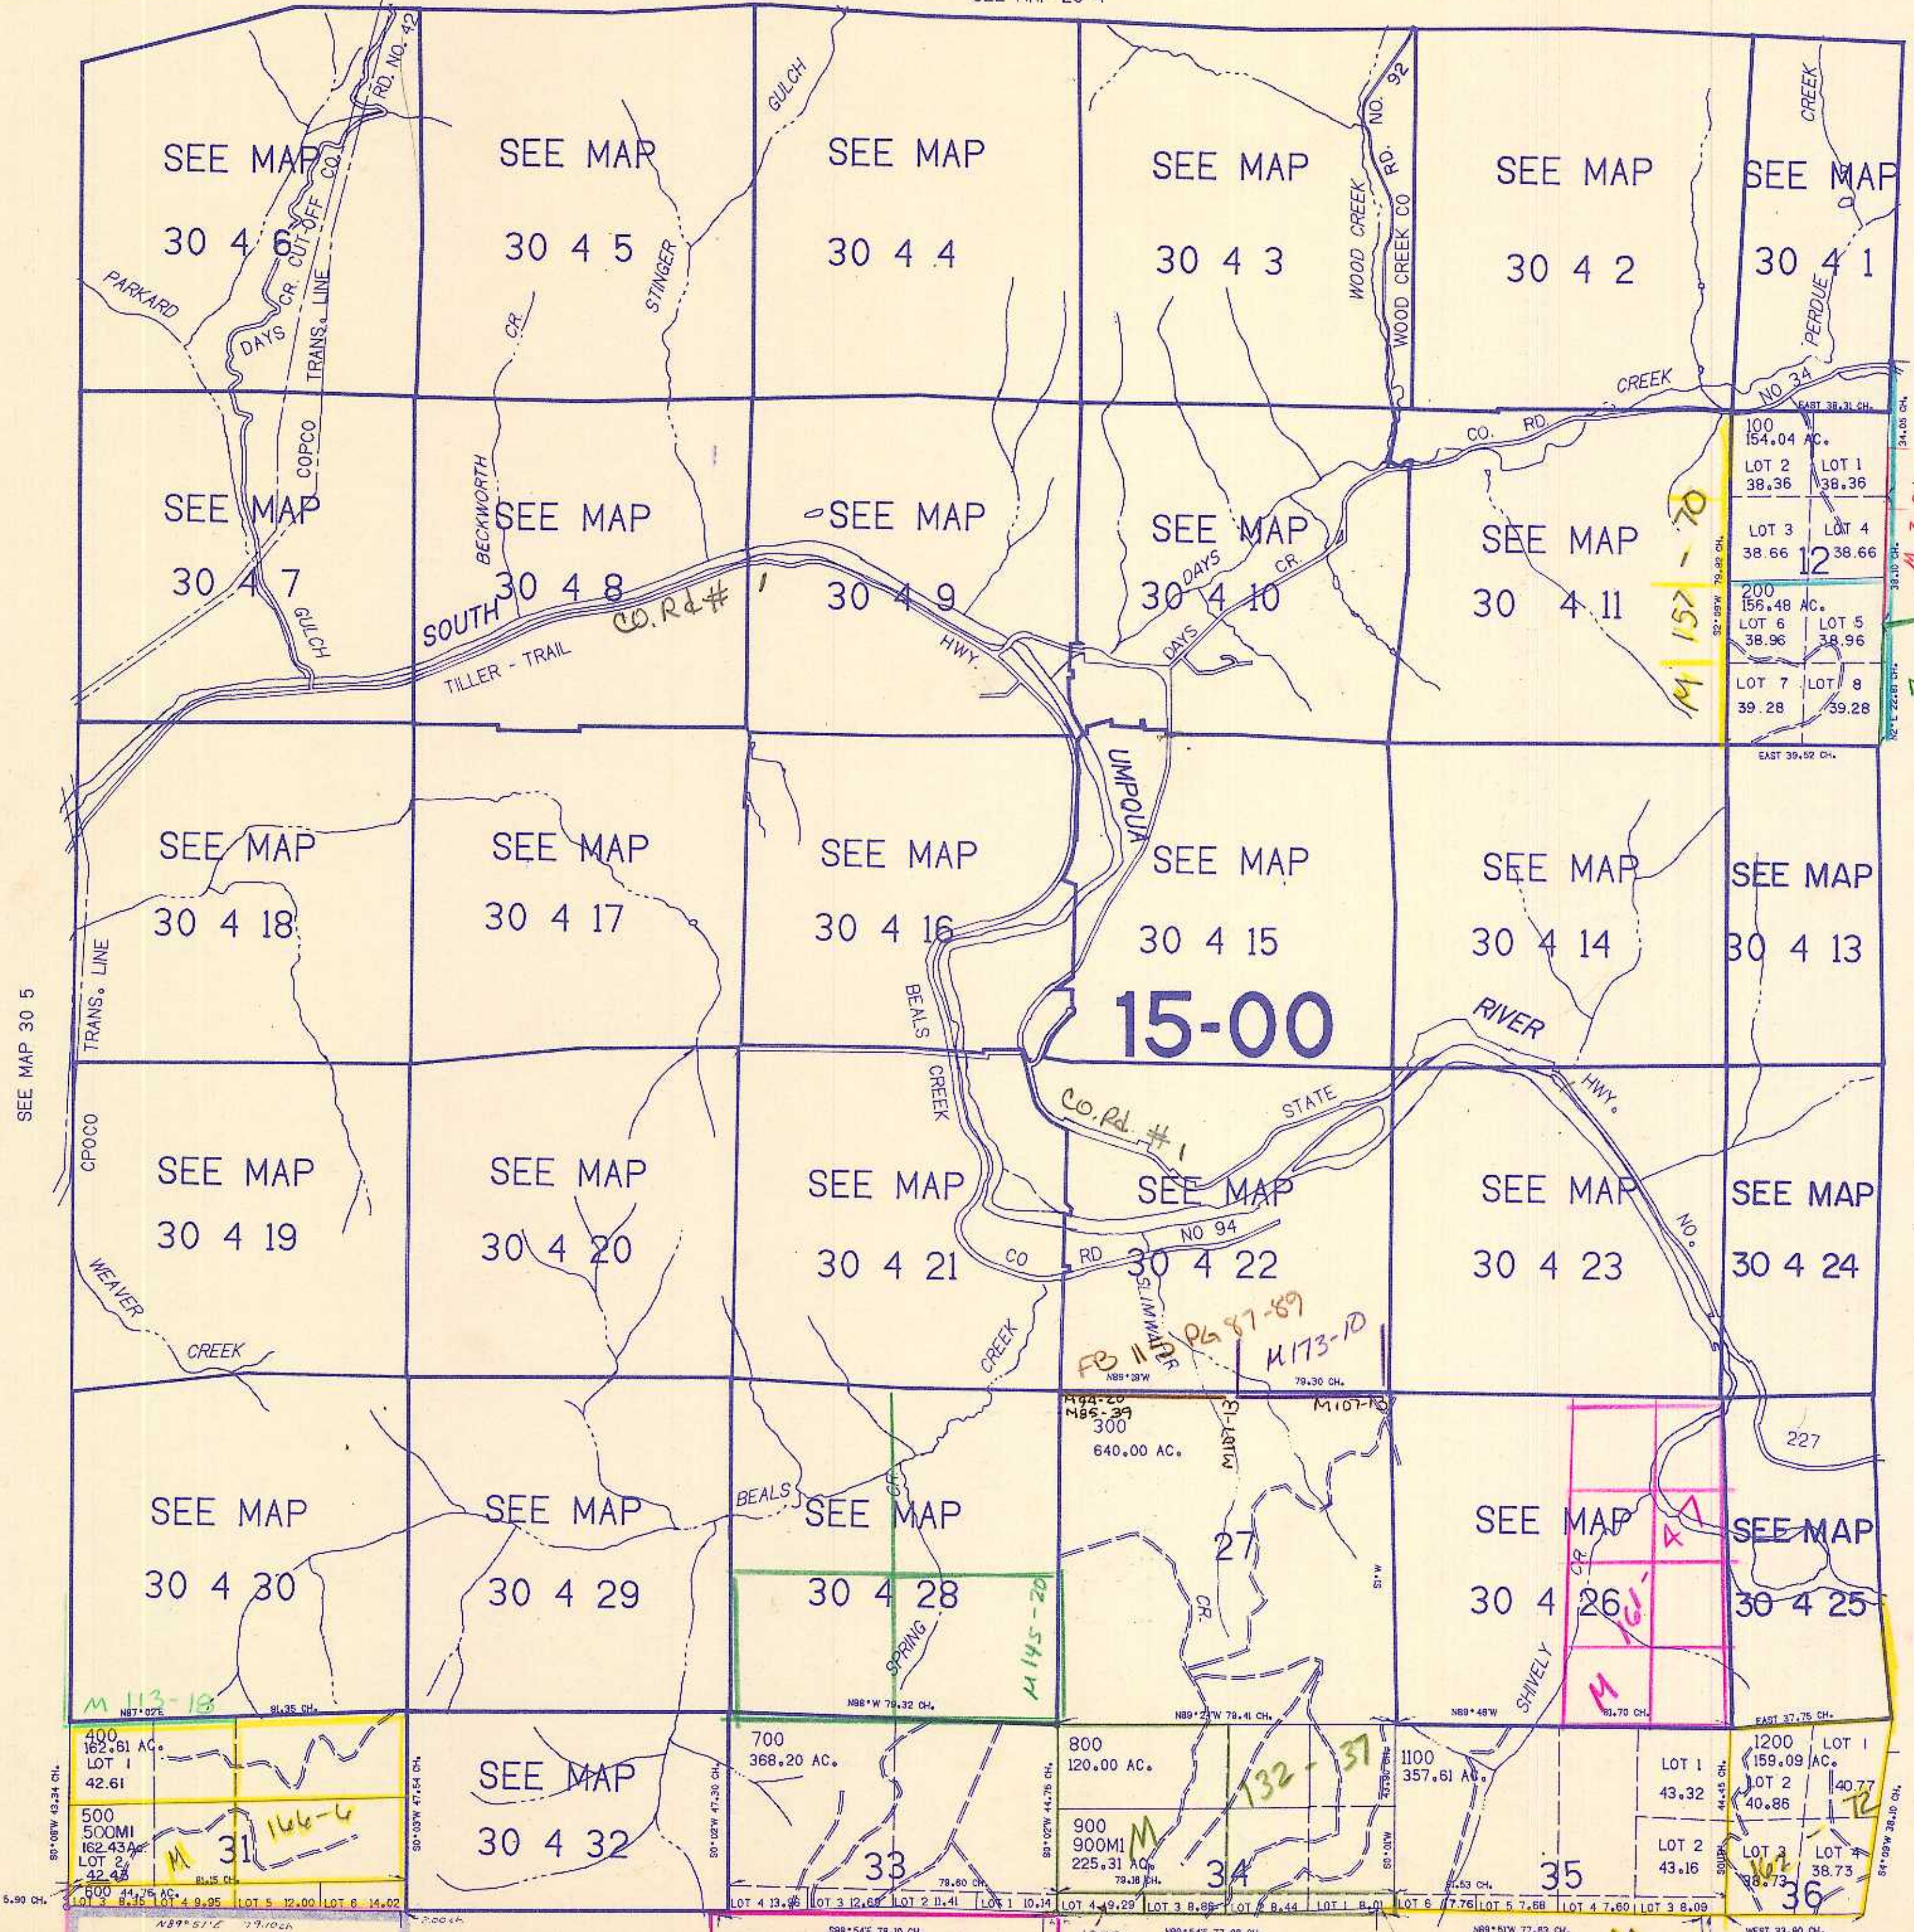

10/84 88